

January 23, 2020

RFB 2001
AQUIFER RECHARGE AT FLATFORD SWAMP IN MANATEE COUNTY, FLORIDA

ADDENDUM #1
(Acknowledgment is Required)

The Consultant must acknowledge the receipt of this Addendum by signing below and including a signed copy of this Addendum with its Bid Response.

Please note that underlined information (example) is added wording and stricken information (~~example~~) is deleted wording.

Please note the following change to Section 1.5 of the above referenced solicitation:

1.5 BID RECEIPT AND OPENING. One (1) signed hardcopy original, four (4) hardcopies, one (1) exact electronic Adobe™ portable document format file (.PDF) copy of all required response documents including the Bid Response Forms, ~~and one (1) exact electronic Microsoft Excel™ format file (.xlsx) copy of Parts 1 through 4 and the Total Bid Amount sections of the Bid Response Forms~~ must be received by the District's Procurement Office (PRO), Building 4, at the Southwest Florida Water Management District, 2379 Broad Street (U.S. Hwy. 41 South), Brooksville, Florida 34604-6899, on or before **February 4, 2020 at 2:00 p.m.** Signature is required on the one (1) hardcopy original of the Bid Response Form, ~~but not the one (1) Microsoft Excel™ copy.~~ Bids that are not received in a timely manner by this specific office will not be accepted. **All visitors must report to the lobby of Building 4 to sign in and be issued a visitors badge.** Bids will be opened immediately after this date and time, and will remain binding upon the bidder for a period of 90 days thereafter.

Please find revised drawings for Addendum 1 (Attached) that correct text, font, utility adjustments, coordinates, well relocate, SBS Recirc Pump and Instrumentation References on the PDF. Not all pages required modifications – revised items are marked on the drawings and a note was added to the bottom left corner of the sheets (ADDENDUM 1) that were revised.

Brian Bickhardt
Senior Procurement Specialist III

AD
cc: Lisann Morris

ACKNOWLEDGEMENT OF ADDENDUM #1

BY: _____
DATE

(TYPE/PRINT NAME AND TITLE)

COMPANY NAME

ATTACHMENT 1

REVISED DRAWINGS:


Ad. No. 1 - Text, Font, and Utility Adjustments

**Ad. No. 2 - Coordinates, Well Relocate, SBS Recirc Pump,
Instrumentation References**


22x34

AQUIFER RECHARGE AT FLATFORD SWAMP

PREPARED FOR:
SOUTHWEST FLORIDA WATER MANAGEMENT DISTRICT

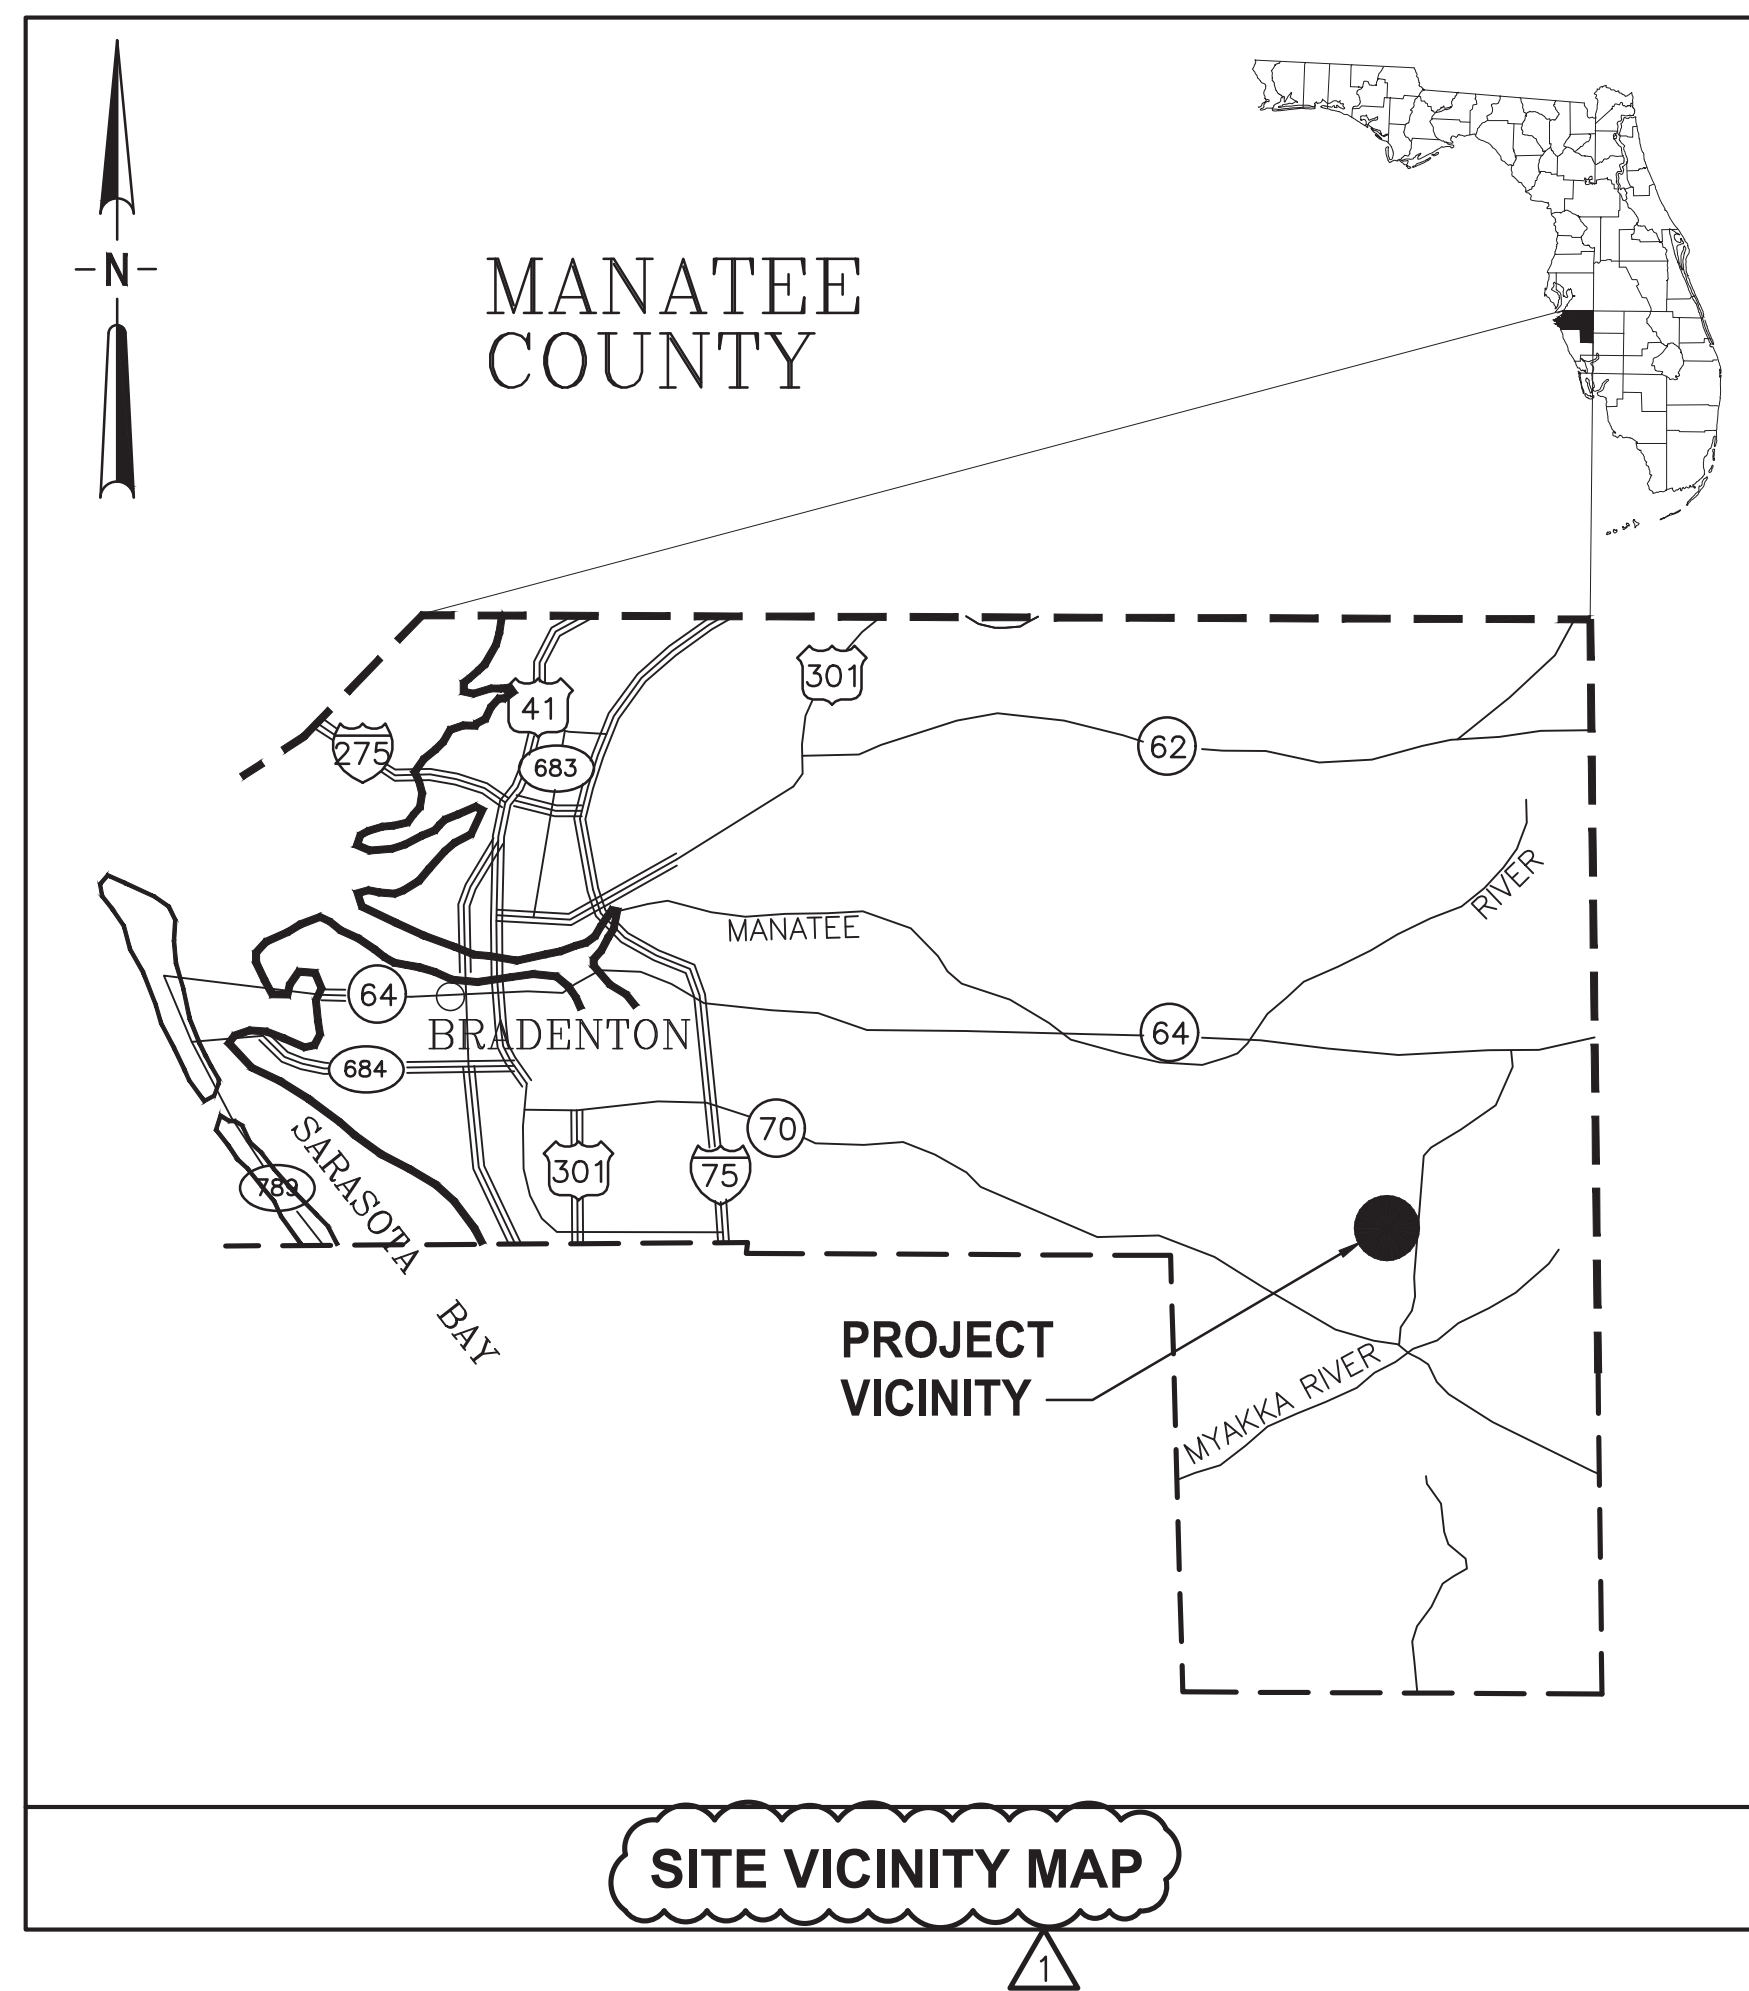

PREPARED BY:
JonesEdmunds
CERTIFICATE OF AUTHORIZATION #1841
730 NE WALDO ROAD, GAINESVILLE, FLORIDA 32641 / (352) 377-5821
324 S HYDE PARK AVE, SUITE 250, TAMPA, FLORIDA 33606 / (813) 258-0703

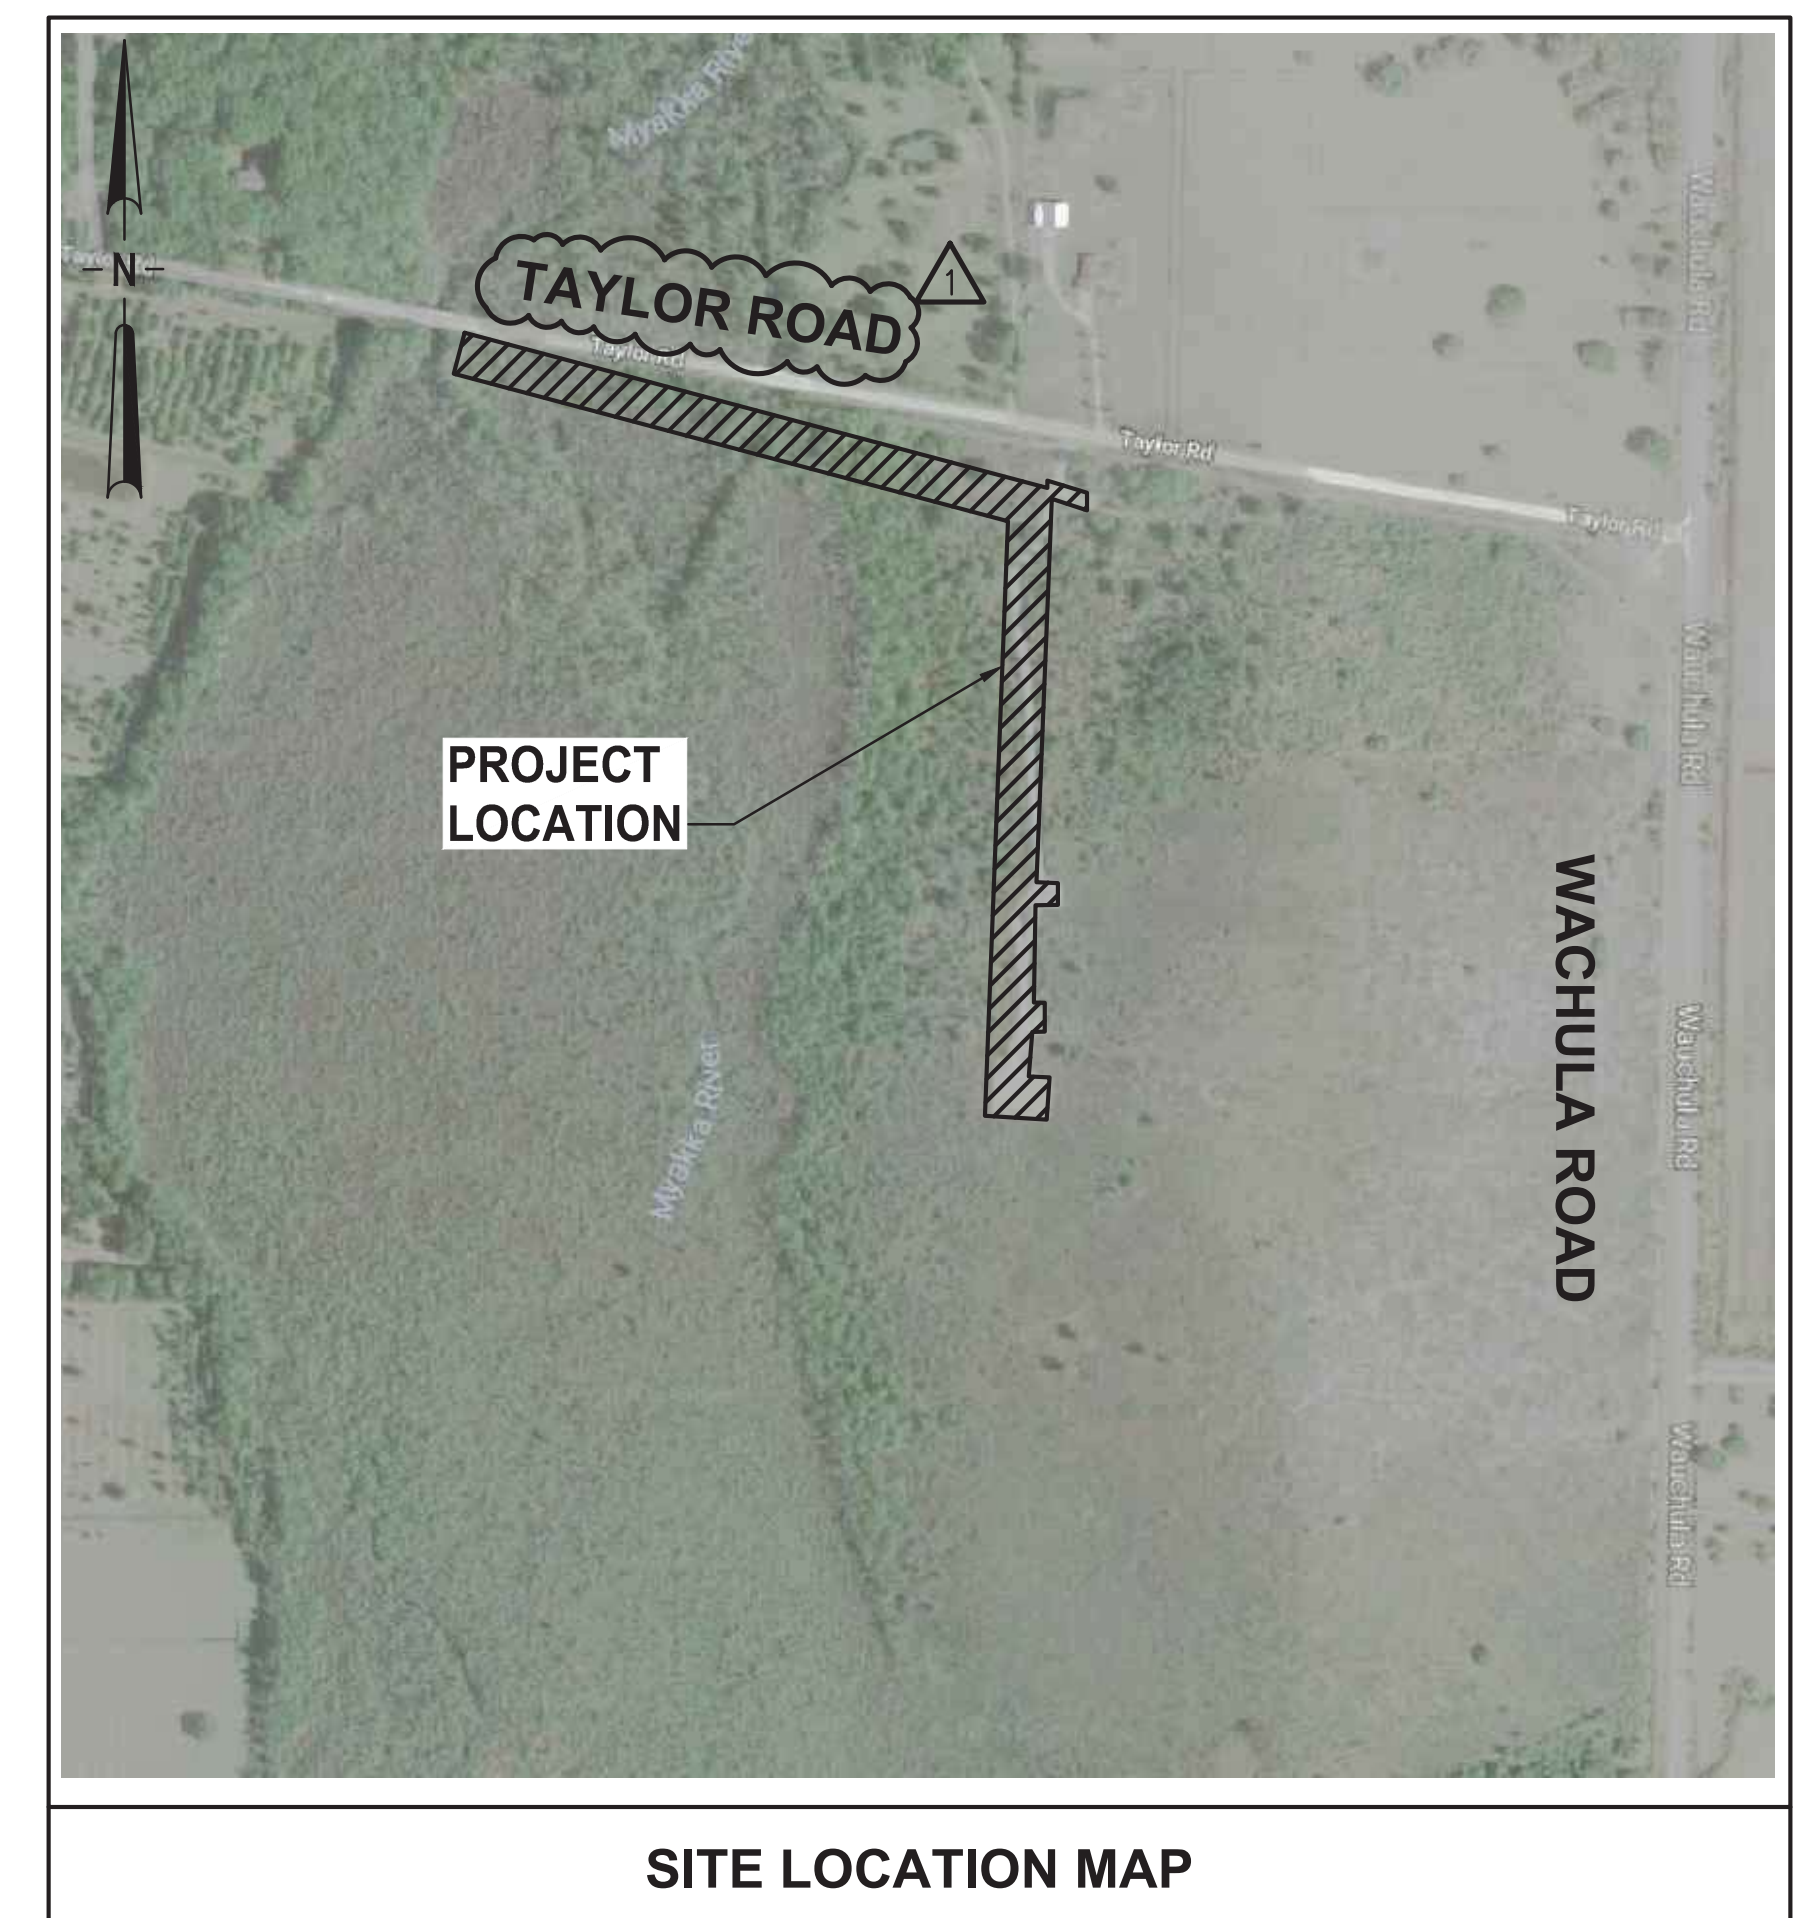

PROJECT NO: 19850-041-01

SEPTEMBER 2019

Y:\19850-SWFWM\PROJECTS\041-01_FLATFORD SWAMP AQUIFER RECHARGE\CAD\DWGS\GENERAL\1985004101-G02.DWG
10/1/2019 6:30 PM CAUTODESK

87654321

PLOTTED: 1/20/2020 10:10 AM JOHN KRAMER

© Jones Edmunds 2234

GENERAL NOTES

1.

TOPOGRAPHIC SURVEY DATED JUNE 6, 2018 PROVED BY DEGROVE SURVEYORS, INC. (904) 722-0400.

2.

ALL ELEVATIONS ARE REFERENCED TO THE NORTH AMERICAN VERTICAL DATUM (1988) AND ARE BASED ON NGS BENCHMARKS "D 562" (PID# DE8679) ELEVATION=56.14' NAVD88.

3.

UNDERGROUND UTILITIES, FOUNDATIONS, OR OTHER IMPROVEMENTS, IF ANY WERE NOT LOCATED EXCEPT AS SHOWN.

4.

JURISDICTIONAL WETLANDS WERE LOCATED BY JONES EDMUNDS AND ASSOCIATES AND RECORDED BY HANDHELD GPS.

5.

FLOODPLAIN ELEVATIONS NOTED ON THE DRAWINGS ARE REFERENCED FROM THE FEMA FIRM PANEL 12081C039E, EFFECTIVE DATE 3/17/2014 AND FLOOD INSURANCE STUDY NUMBER 12081CV00A, MYAKKA RIVER FLOODWAY SECTION AH, EFFECTIVE DATE 3/17/2014,

6.

THE COORDINATES SHOWN HEREON ARE REFERENCE TO THE STATE PLANE COORDINATE SYSTEM (WEST ZONE), NORTH AMERICAN DATUM OF 1983 (NAD83(2011)), U.S.SURVEY FEET. THE PLANE COORDINATES WERE DERIVED USING REAL TIME KINEMATIC (RTK) GPS WITH DIRECT OBSERVATIONS TO THE FLORIDA PERMANENT REFERENCE NETWORK.

7.

CONTRACTOR SHALL VERIFY THE ACCURACY OF THE PROVIDED SURVEY INFORMATION TO HIS/HER SATISFACTION. CONTRACTOR IS SOLELY RESPONSIBLE FOR PROPER VERTICAL AND HORIZONTAL ALIGNMENT OF CONSTRUCTED FACILITIES, PIPELINES, AND FINISHED GRADE. CONTRACTOR SHALL ALSO BE RESPONSIBLE FOR RESTORING PROPERTY CORNERS AND LAND MARKERS WHICH MAY BE DISTURBED BY CONSTRUCTION. ALL STAKING SHALL BE PERFORMED BY A PROFESSIONAL LAND SURVEYOR REGISTERED IN THE STATE OF FLORIDA.

8.

CONTRACTOR SHALL RETAIN ON THE WORK SITE COPIES OF ANY PERMITS REQUIRED FOR CONSTRUCTION.

9.

ALTHOUGH MEASUREMENTS MAY BE SHOWN ON THE DRAWINGS, CONTRACTOR IS SOLELY RESPONSIBLE FOR DETERMINING ALL MATERIAL QUANTITIES IN ACCORDANCE WITH THE CONTRACT DOCUMENTS.

10.

CONTRACTOR SHALL PROVIDE OWNER A "RECORD DRAWING" SURVEY, SIGNED AND SEALED BY A REGISTERED SURVEYOR, FOR DOCUMENTATION OF MODIFICATIONS MADE DURING CONSTRUCTION.

11.

CONTRACTOR SHALL NOTIFY THE ENGINEER IN WRITING IMMEDIATELY WHEN CONFLICTS BETWEEN DRAWINGS AND ACTUAL CONDITIONS ARE DISCOVERED DURING WORK.

12.

ALL REFERENCED FDOT STANDARD INDEX DRAWINGS CAN BE FOUND AT WWW.FDOT.GOV/DESIGN/STANDARDPLANS

13.

FDOT INDICES SHALL REFER TO THE "FY 2019-20 FLORIDA DEPARTMENT OF TRANSPORTATION STANDARD PLANS FOR ROAD CONSTRUCTION."

14.

ALL WORK AND THE QUALITY OF MATERIALS SHALL CONFORM TO THE APPLICABLE SECTIONS OF THE 2019 "FLORIDA DEPARTMENT OF TRANSPORTATION STANDARD SPECIFICATIONS FOR ROAD AND BRIDGE CONSTRUCTION".

15.

IT IS THE RESPONSIBILITY OF CONTRACTOR TO BECOME FAMILIAR WITH THE OSHA EXCAVATION SAFETY STANDARDS AND TO ABIDE BY THEM AS COVERED UNDER THE FLORIDA TRENCH SAFETY ACT (LAWS OF FLORIDA 90-96) EFFECTIVE OCTOBER 1, 1990.

16.

CONTRACTOR SHALL FIELD LOCATE AND VERIFY EXISTING UTILITIES, (SIZE, MATERIAL OF CONSTRUCTION, ELEVATION, ETC.) ESPECIALLY AT CONNECTING POINTS, PRIOR TO SHOP DRAWING PREPARATION AND SUBMITTAL. CONTRACTOR SHALL INCLUDE CONSIDERATION OF SUCH UTILITIES IN PLANNING AND PRIOR TO EXECUTION OF WORK. CONTRACTOR SHALL INCLUDE FIELD MEASUREMENTS ON SHOP DRAWINGS.

17.

LOCATIONS, ELEVATIONS, AND DIMENSIONS OF EXISTING UTILITIES, STRUCTURES, AND OTHER FEATURES ARE SHOWN BASED ON THE BEST INFORMATION AVAILABLE AT THE TIME OF PREPARATION OF THESE DRAWINGS BUT ARE NOT PURPORTED TO BE ABSOLUTELY CORRECT. THERE MAY BE OTHER IMPROVEMENTS, UTILITIES, ETC. WHICH ARE WITHIN THE PROJECT AREA. CONTRACTOR SHALL VERIFY, PRIOR TO CONSTRUCTION, THE LOCATIONS, ELEVATIONS, AND DIMENSIONS OF ALL EXISTING UTILITIES, STRUCTURES, AND OTHER FEATURES (WHETHER OR NOT SHOWN ON THE DRAWINGS) AFFECTING THE PROPOSED WORK.

18.

CONTRACTOR SHALL NOTIFY UTILITY OWNERS THROUGH "SUNSHINE STATE ONE CALL OF FLORIDA, INC." (1-800-432-4770) AT LEAST TWO BUSINESS DAYS IN ADVANCE OF BEGINNING CONSTRUCTION ON THE JOB SITE.

19.

CONTRACTOR SHALL BE RESPONSIBLE FOR ANY DAMAGE TO UTILITIES, STRUCTURES, AND PROPERTY ON AND ADJACENT TO THE SITE CAUSED BY CONSTRUCTION ACTIVITIES.

20.

CONTRACTOR SHALL COORDINATE CONSTRUCTION SCHEDULE WITH INDIVIDUAL COMPANIES

CONCERNING RELOCATION OF UTILITIES AND ANY ADDITIONAL RELOCATIONS RESULTING FROM CONFLICTS NOT DELINEATED ON THE DRAWINGS.

21.

CONTRACTOR IS RESPONSIBLE FOR BRACING, SHORING, OR PROVIDING OTHER MEANS NECESSARY TO PROTECT AND SUPPORT EXISTING UTILITIES EXPOSED OR UNEXPOSED DURING CONSTRUCTION. AS REQUIRED TO COMPLETE THE WORK, THE CONTRACTOR SHALL DEWATER, HAND EXCAVATE, SHORE-UP TRENCHES, STABILIZE UTILITIES INCLUDING UTILITY POLES, AND PROVIDE SHEET PILING AT NO ADDITIONAL COST TO THE OWNER.

22.

CONTRACTOR SHALL HAND EXCAVATE WHEN CONSTRUCTION IS WITHIN 2 FEET OF EXISTING UTILITIES.

23.

THE CONTRACTOR IS HEREBY MADE RESPONSIBLE FOR THE SAFE MAINTENANCE OF PEDESTRIAN AND VEHICULAR TRAFFIC AT ALL TIMES DURING THE DURATION OF THE PROJECT.

24.

CONTRACTOR SHALL MAINTAIN TRAFFIC IN ACCORDANCE WITH FDOT STANDARD PLANS 102 SERIES AND THE TECHNICAL SPECIFICATIONS. ONE TRAFFIC LANE MUST BE MAINTAINED AT ALL TIMES WITH USE OF FLAGGER IF NECESSARY. LANE CLOSURE HOURS SHALL BE BETWEEN 9 AM to 4 PM ON WEEKDAYS. ALL TRAFFIC LANES MUST BE OPEN FOR TRAFFIC AT THE CLOSE OF WORKDAYS. ALL SIGNING, BARRICADES, LIGHTING, AND FLAGGERS SHALL BE INCLUDED IN THE BID PRICE. ALL WORK IS TO BE CARRIED OUT MONDAY THROUGH FRIDAY 9 A.M. TO 4 P.M., WITH NO WEEKEND OR HOLIDAY WORK WITHOUT APPROVAL BY THE OWNER.

25.

EXISTING FEATURES ARE SHOWN LIGHT-LINED AND/OR SCREENED AND PROPOSED FEATURES ARE SHOWN HEAVY-LINED.

26.

CONTRACTOR WILL REQUEST INSPECTIONS BY MANATEE COUNTY STAFF BY CONTACTING (904)748-4501.

27.

CONTRACTOR TO COORDINATE WITH THE OWNER FOR PERMISSION TO REMOVE TREES OVER 8 INCHES.IN DIAMETER AT BREAST HEIGHT WITHIN DESIGNATED LIMITS OF CONSTRUCTION (L.O.C.). FOLLOWING OWNER'S APPROVAL, CONTRACTOR TO CONTACT MANATEE COUNTY FOR INSPECTION PRIOR TO REMOVING TREES. OVER 8 INCHES IN DIAMETER AT BREAST HEIGHT CONTRACTOR TO COORDINATE NUMBER AND TYPE OF TREES FOR MITIGATION.

28.

CONTRACTOR SHALL REMOVE LITTER PER THE 2019 FDOT STANDARD SPECIFICATIONS FOR ROAD AND BRIDGE SECTION 107-1. LITTER SHALL BE REMOVED AS NEEDED BUT NOT LESS THAN ONCE PER MONTH OR AS DIRECTED BY THE OWNER OR ENGINEER, IF REQUIRED. THE CONTRACTOR SHALL PROVIDE AN APPROPRIATE TRASH CONTAINER SUCH AS A DUMPSTER OR A ROLL-OFF. THE CONTRACTOR OR SUBCONTRACTORS SHALL NOT LITTER THE PROJECT AREA WITH PERSONAL TRASH. SUCH TRASH SHALL BE PICKED UP AND PROPERLY DISPOSED OF DAILY. NO TRASH SHALL BE PERMANENTLY DISPOSED OF ONSITE.

29.

THE CONTRACTOR SHALL NOT USE THE RIGHT-OF-WAY TO STAGE EQUIPMENT OR STORE MATERIAL. THE CONTRACTOR MUST PROVIDE THEIR OWN STAGING AREA.

30.

PRIOR TO MOBILIZING TO THE SITE, THE CONTRACTOR SHALL SCHEDULE AN INSPECTION WITH THE OWNER AND MANATEE COUNTY TO DOCUMENT THE CONDITION OF TAYLOR ROAD. THE CONTRACTOR SHALL BE RESPONSIBLE FOR RESTORING TAYLOR ROAD TO ITS ORIGINAL CONDITION AT THE COMPLETION OF THE PROJECT.

Sunshine811

Call 811 or www.sunshine811.com two full business days before digging to have utilities located and marked.

Check positive response codes before you dig!

DRAWING INDEX

DWG	DESCRIPTION
GENERAL	
G1	COVER SHEET
G2	DRAWING INDEX AND GENERAL NOTES
G3	ABBREVIATIONS
G4	LEGENDS
G5	KEY MAP
CIVIL	
C1	CIVIL SITE PLAN
C2	PLAN AND PROFILE
C3	PLAN AND PROFILE
C4	PLAN AND PROFILE
C5	PLAN AND PROFILE
C6	TYPICAL SECTIONS
C7	CIVIL DETAILS
C8	EROSION CONTROL SITE PLAN
C9	EROSION CONTROL NOTES
C10	EROSION CONTROL DETAILS
STRUCTURAL	
S1	GENERAL STRUCTURAL NOTES, ABBREVIATIONS, AND SYSMBOLS
S2	GRAVITY INTAKE STRUCTURE PLANS, SECTION, AND DETAILS
S3	RECHARGE PUMP STATION PLANS AND SECTION
S4	RECHARGE PUMP STATION BUILDING ELEVATIONS
S5	RECHARGE WELL BUILDING PLAN AND ELEVATIONS
S6	CHEMICAL FEED ENCLOSURE PLAN AND DETAILS
S7	BUILDING SCHEDULES AND DETAILS
S8	BUILDING SCHEDULES AND DETAILS
MECHANICAL	
M1	GRAVITY INTAKE STRUCTURE AND RECHARGE PUMP BUILDING PLAN AND SEC
M2	CHEMICAL FEED ENCLOSURE PLAN AND SECTION
M3	RECHARGE WELL BUILDING PLAN AND SECTION
M4	MONITORING WELL PLAN AND SECTION
M5	SUPPLY WELL PLAN AND SECTION
M6	MECHANICAL DETAILS
M7	MECHANICAL DETAILS
ELECTRICAL	
E1	ELECTRICAL SYMBOL LEGEND, ABBREVIATION LEGEND, AND LUMINAIRE SCH
E2	POWER ONE-LINE DIAGRAM
E3	ELECTRICAL SITE PLAN
E4	RECHARGE PUMP BUILDING ELECTRICAL PLANS
E5	CHEMICAL FEED ENCLOSURE ELECTRICAL PLANS
E6	RECHARGE WELL BUILDING ELECTRICAL PLANS
E7	MONITORING WELL DETAIL ELECTRICAL
E8	LIGHTNING PROTECTION PLANS
E9	PANEL SCHEDULES
E10	PANEL SCHEDULES
INSTRUMENTATION	
I1	SYMBOLS & ABBREVIATIONS
I2	NETWORK DIAGRAM
I3	INSTRUMENT DETAILS
I4	PROCESS P&ID

DESIGNED

SMENARD

DRAWN

JKRAMER

CHECKED

DYONGE

JonesEdmunds

CERTIFICATE OF AUTHORIZATION #1841
730 NE WALDO ROAD, GAINESVILLE, FLORIDA 32641 / (352) 377-5821
324 S HYDE PARK AVE, SUITE 250, TAMPA, FLORIDA 33606 / (813) 258-0703

AQUIFER RECHARGE AT FLATFORD SWAMP

SOUTHWEST FLORIDA WATER MANAGEMENT DISTRICT

DRAWING INDEX AND GENERAL NOTES

APPROVED BY

THOMAS W. FRIEDRICH

P.E. 61281

PROJECT NO:

19850-041-01

INDEX NO:

DATE:

SEP. 2019

DWG NO:

G2

BID SET


87654321





Y:\19850-SWFWM\PROJECTS\041-01_FLATFORD SWAMP AQUIFER RECHARGE\CAD\DWGS\GENERAL\1985004101-003.DWG
 5/21/2019 4:44 PM JKRAMER


PLOTTED: 1/20/2020 10:10 AM JOHN KRAMER											
STANDARD ABBREVIATIONS											
&	AND	CP	CONTROL PANEL	GALV	GALVANIZED	MS	MOTOR STARTER	RED	REDUCER	W/O	WITHOUT
@	AT	CPT	CONTROL POWER TRANSFORMER	GEN	GENERATOR	MSC	MANUFACTURER SUPPLIED CABLE	REF	REFERENCE	WCJ	WALL CONTROL JOINT
A	AUTOMATIC	CRE	CORROSION RESISTANT	GFCI	GROUND FAULT CIRCUIT INTERRUPTER	MT, MTD	MOUNT(ED)	REINF	REINFORCEMENT, REINFORCING	WF	WALL FOOTING
AA STD	ALUMINUM ASSOCIATION STANDARD	CRSI	CONCRETE REINFORCING STEEL INSTITUTE	GND	GROUND	MTL	METAL	REQ,	REQUIRED	WGT	WEIGHT
AASHTO	AMERICAN ASSOCIATION OF STATE HIGHWAY AND TRANSPORTATION OFFICIALS	CS	CARBON STEEL	GPM	GALLONS PER MINUTE	MV	MEDIUM VOLTAGE	REQ'D		WP	WORK POINT, WEATHERPROOF
AC	ASBESTOS CEMENT	CT	CURRENT TRANSFORMER, CABLE TRAY	GR	GRADE	N	NORTH(ING), NEUTRAL, NORMAL	RGS	RIGID GALVANIZED STEEL	WSE,	WATER SURFACE ELEVATION
AC	ALTERNATING CURRENT	CTR'D	CENTERED	GRTG	GRATING	N/A	NOT APPLICABLE	RJ	RESTRAINED JOINT	WSEL	
AC	AIR CONDITIONER	CV	CHECK VALVE	GS	GALVANIZED STEEL	NAD	NORTH AMERICAN DATUM	RM	REMOTE MULTIPLEXING MODULE	WT	WEIGHT
ACI	AMERICAN CONCRETE INSTITUTE	D	DRAIN	GSP	GALVANIZED STEEL PIPE	NAVD	NORTH AMERICAN VERTICAL DATUM	RMS	ROOT MEAN SQUARE	WV	WATER VALVE
ADJ	ADJUSTABLE	DB	DUCT BANK	GST	GROUND STORAGE TANK	NC	NORMALLY CLOSED	RPZ	REDUCED PRESSURE ZONE	WWF	WELDED WIRE FABRIC
AFF	ABOVE FINISHED FLOOR	DBI	DITCH BOTTOM INLET	GV	GATE VALVE	NE	NORTH EAST	RT	RIGHT	XFMR	TRANSFORMER
AFG	ABOVE FINISHED GRADE	DC	DIRECT CURRENT	H	HIGH	NEC	NATIONAL ELECTRICAL CODE	RTU	REMOTE TELEMETRY UNIT	XS	EXTRA STRONG
AIP	ABANDONED IN PLACE	DES	DESIGNATION	HD	HAND	NEMA	NATIONAL ELECTRICAL MANUFACTURERS ASSOCIATION	S	SOUTH		
AISI	AMERICAN IRON STEEL INSTITUTE	DET	DETAIL	HDD	HORIZONTAL DIRECTIONAL DRILL	NEUT	NEUTRAL	SARV	SURGE ANTICIPATOR RELIEF VALVE		
AIT	ANALYTICAL INDICATING TRANSMITTER	DI	DUCTILE IRON	HDNS	HARDNESS	NGVD	NATIONAL GEODETIC VERTICAL DATUM	SBC	STANDARD BUILDING CODE		
ALT	ALTERNATIVE	DIA	DIAMETER	HDPE	HIGH DENSITY POLYETHYLENE	NIC	NOT IN CONTRACT	SCH	SCHEDULE		
ALUM	ALUMINUM	DIP	DUCTILE IRON PIPE	HHWL	HIGH HIGH WATER LEVEL	No.	NUMBER	SCJ	SAW CUT JOINT		
AM	AUTO-MANUAL	DIPS	DUCTILE IRON PIPE SIZE	HK	HOOK	NO	NORMALLY OPEN	SDI	STEEL DECK INSTITUTE		
AMPS	AMPERES	DIV	DIVISION	HOA	HAND-OFF-AUTO	NOM	NOMINAL	SE	SOUTH EAST		
ANSI	AMERICAN NATIONAL STANDARDS INSTITUTE	DN	DOWN, DAMPER	HOR	HAND-OFF-REMOTE	NPDES	NATIONAL POLLUTANT DISCHARGE ELIMINATION SYSTEM	SEC	SECOND		
AP	ANALYZER PANEL	DR	DIMENSION RATIO	HORIZ	HORIZONTAL	NPT	NATIONAL PIPE THREAD	SF	SLOWER-FASTER		
APP	APPROVE, APPROVED	DR	DRAIN	HP	HORSEPOWER OR HIGH POINT	NRS	NONRISING STEM	SHEC	SHOULDERED-END COUPLING		
APPROX	APPROXIMATE	DWG	DRAWING	HPS	HIGH PRESSURE SODIUM	NS	NEAR SIDE	SHT	SHEET		
AR	AIR RELEASE	DXS	DOUBLE EXTRA STRONG	HR	HANDRAIL	NSF	NATIONAL SANITATION FOUNDATION	SIM	SIMILAR		
ARV	AIR RELEASE VALVE	E	EAST	HSP	HIGH SERVICE PUMP	NTS	NOT TO SCALE	SJI	STEEL JOINT INSTITUTE		
ASCE	AMERICAN SOCIETY OF CIVIL ENGINEERS	E	ELECTRIC ACTUATOR	HT	HEIGHT	NW	NORTH WEST	SM	STATIC MIXER		
ASD	ADJUSTABLE SPEED DRIVE	EA	EACH	HWL	HIGH WATER LEVEL	OC	ON CENTER(S), OPEN-CLOSE(D)	SP	SPACING, SPACED		
ASTM	AMERICAN SOCIETY FOR TESTING AND MATERIALS	ECC	ECCENTRIC	I&C	INSTRUMENTATION AND CONTROL	OCA	OPEN-CLOSE-AUTO	SPD	SURGE PROTECTIVE DEVICE		
ATS	AUTOMATIC TRANSFER SWITCH	EES	EMERGENCY EYEWASH AND SHOWER	IC	INTERRUPTING CAPACITY	OCR	OPEN-CLOSE-REMOTE	SQ	SQUARE		
AUTO	AUTOMATIC	EF	EACH FACE, EXHAUST FAN	ID	INSIDE DIAMETER	OD	OUTSIDE DIAMETER	SR	STATE ROAD, SURGE RELIEF		
AUX	AUXILIARY	EG	SUCH AS	ID	IDENTIFICATION	OF	OVERFLOW	SRV	SURGE RELIEF VALVE		
AVE	AVENUE	EJ	EXPANSION JOINT	IE	INVERT ELEVATION	OO	ON-OFF	SS	START-STOP		
AWG	AMERICAN WIRE GUAGE	EL, ELEV	ELEVATION	IEE	INSTITUTE OF ELECTRICAL AND ELECTRONIC ENGINEERS	OOA	ON-OFF-AUTO	SS, SST	STAINLESS STEEL		
AWS	AMERICAN WELDING SOCIETY	ELB	ELBOW	IF	INSULATED FLANGE	OOR	ON-OFF-REMOTE	SSC	SUPERVISORY SET POINT CONTROL		
AWWA	AMERICAN WATER WORKS ASSOCIATION	ELEC	ELECTRICAL	IJ	ISOLATION JOINT	OPP	OPPOSITE	SSRV	SOLID STATE REDUCED VOLTAGE		
B/	BOTTOM OF	EOP	EDGE OF PAVEMENT	INC	INCORPORATED	OS&Y	OUTSIDE STEM AND YOKE	ST	SHUNT TRIP		
B/L	BASELINE OF CONSTRUCTION	EQ	EQUAL	IPS	IRON PIPE SIZE	OSC	OPEN-STOP-CLOSE	STA	STATION		
BC	BARE COPPER	ERCP	ELLIPTICAL REINFORCED CONCRETE PIPE	J, JB	JUNCTION BOX	OSHA	OCCUPATIONAL SAFETY AND HEALTH ADMINISTRATION	STD	STANDARD		
BF	BLIND FLANGE	EST	ELEVATED STORAGE TANK	JT	JOINT	P&ID	PIPING AND INSTRUMENTATION DIAGRAM	STL	STEEL		
BFP	BACKFLOW PREVENTER	ETC	ETCETERA	KA	KILOAMPERES	P/L	PROPERTY LINE	STS	STORMWATER SEWER		
BFV	BUTTERFLY VALVE	EW	EACH WAY	KB	KNEE BRACE	PB	PULL BOX	SW	SOUTH WEST, SWITCH		
BKR	BREAKER	EXIST	EXISTING	KCMIL	THOUSAND CIRCULAR MILS	PCCP	PRESTRESSED CONCRETE CYLINDER PIPE	SWD	SIDE WATER DEPTH		
BLD	BLIND	FBC	FLORIDA BUILDING CODE	KV	KILOVOLT	PCV	PRESSURE CONTROL VALVE	SWJ	SOLVENT WELD JOINT		
BLDG	BUILDING	F, FU	FUSE	KVA	KILOVOLT AMPERES	PE	PLAIN END, POLYETHYLENE	SWPPP	STORM WATER POLLUTION PREVENTION PLAN		
BLVD	BOULEVARD	F/F	FINISHED FLOOR	KW	KILOWATTS	PET	POLYETHYLENE TUBING	SY	SQUARE YARD		
BM	BENCH MARK	FAB	FABRICATED	KWH	KILOWATT HOUR	PF	POWER FACTOR	T, THK	THICK		
BO	BLOW-OFF	FAC	FLORIDA ADMINISTRATIVE CODE	L	LOWER	PH	HYDROGEN ION CONCENTRATION	T/	TOP OF		
BTM	BOTTOM	FCA	FLANGED COUPLING ADAPTER	LB, LBS	POUND(S)	PI	PRESSURE INDICATOR/GAUGE	T/B,T&B	TOP AND BOTTOM		
BTM/	BOTTOM OF	FCV	FLOW CONTROL VALVE	LE	LEVEL ELEMENT	PID	PROPORTIONAL INTEGRAL DERIVATIVE	TBM	TEMPORARY BENCHMARK		
BV	BALL VALVE	FDEP	FLORIDA DEPARTMENT OF ENVIRONMENTAL PROTECTION	LEL	LOWER EXPLOSIVE LIMIT	PIT	PRESSURE INDICATING TRANSMITTER	TEMP	TEMPERATURE		
BYP	BYPASS	FDN	FOUNDATION	LF	LINEAR FEET	PIV	POST INDICATOR VALVE	TGS	THREADED GALVANIZED STEEL		
C	CONDUIT, CONDUCTOR, CLOSE	FDOT	FLORIDA DEPARTMENT OF TRANSPORTATION	LG	LONG	PL	PLATE	TGSP	THREADED GALVANIZED STEEL PIPE		
C/L, CL	CENTERLINE	FDR	FEEDER	LIT	LEVEL INDICATING TRANSMITTER	PLC	PROGRAMMABLE LOGIC CONTROLLER	TH	TOTAL HEAD		
CAM	COMPUTER-AUTO-MANUAL	FE	FLOW ELEMENT	LIU	LIGHT INTERFACE UNIT	PLCS	PLACES	THD	THREADED		
CAT	CATALOGUE	FF	FINISHED FLOOR	LLH	LONG LEG HORIZONTAL	POC	POINT OF CONNECTION	TJB	TERMINAL JUNCTION BOX		
CB	CIRCUIT BREAKER	FFE	FINISHED FLOOR ELEVATION	LLV	LONG LEG VERTICAL	POE	POINT OF ENTRY	TK	TANK		
CC	CENTER TO CENTER	FG	FINISHED GRADE, FIBERGLASS	LLWL	LOW LOW WATER LEVEL	POJ	PUSH ON JOINT	TOC	TOP OF CONCRETE		
CCS	CENTRAL CONTROL SYSTEM	FH	FIRE HYDRANT	LOS	LOCKOUT STOP	PP	POWER POLE	TOS	TOP OF STEEL		
CF	COLUMN FOUNDATION	FIG	FIGURE	LR	LONG RADIUS, LOCAL-REMOTE	PPE	PERSONAL PROTECTIVE EQUIPMENT	TOSJ	TOP OF STEEL JOIST		
CFWE	CABLE FURNISHED WITH EQUIPMENT	FIN	FINISHED	LS	LIFT STATION	PRV	PRESSURE REDUCING VALVE	TOW	TOP OF WALL		
CI	CAST IRON	FIT	FLOW INDICATING TRANSMITTER	LSIG	LONG SHORT INSTANTANEOUS GROUND	PSF	POUNDS PER SQUARE FOOT	TS	TUBULAR STEEL		
CIP	CAST IN PLACE, CAST IRON PIPE	FJ	FLANGED JOINT	LWL	LOW WATER LEVEL	PSI	POUNDS PER SQUARE INCH	TSF	THICKENED SLAB FOOTING		
CISP	CAST IRON SLIP PIECE	FL	FLOOR	M	MAGNETIC CONTACTOR COIL, MOTOR, MANUAL	PSIA	POUNDS PER SQUARE INCH ABSOLUTE	TSP	TWISTED SHIELDED PAIR		
CJ	CONSTRUCTION/CONTRACTION JOINT	FLEX	FLEXIBLE	M/F	MALE/FEMALE	PSID	POUNDS PER SQUARE INCH DIFFERENTIAL	TURB	TURBIDITY		
CLF	CHAIN LINK FENCE	FLG	FLANGE(D)	MAX	MAXIMUM	PSIG	POUNDS PER SQUARE INCH GAUGE	TYP	TYPICAL		
CLR	CLEAR	FND	FOUNDATION	MC	MODULATE-CLOSE	PSV	PRESSURE SUSTAINING VALVE	UG	UNDERGROUND		
CM	COMPUTER-MANUAL	FNPT	FEMALE NATIONAL PIPE THREAD	MCC	MOTOR CONTROL CENTER	PT	PRESSURE TREATED, POTENTIAL TRANSFORMER	UL	UNDERWRITER'S LABORATORIES		
CMP	CORRUGATED METAL PIPE	FO	FIBER OPTIC	MCJ	MASONRY CONTROL JOINT	PV	PLUG VALVE	ULC	ULTRASONIC LEVEL CONTROLLER		
CMU	CONCRETE MASONRY UNIT	FOS	FAST-OFF-SLOW	MECH	MECHANICAL	PVC	POLYVINYL CHLORIDE	UNO	UNLESS NOTED OTHERWISE		
CO	CLEANOUT	FOSA	FAST-OFF-SLOW-AUTO	MES	MITERED END SECTION	PVMT	PAVEMENT	UPS	UNINTERRUPTIBLE POWER SUPPLY		
CO	COMPANY	FOSR	FAST-OFF-SLOW-REMOTE	MFR	MANUFACTURER	PWR	POWER	V	VOLTAGE, VOLTS		
COL	COLUMN	FP	FULL PENETRATION, FIELD PANEL	MH	MANHOLE	R	RADIUS	VERT	VERTICAL		
COM	COMMUNICATION	FR	FORWARD-REVERSE	MIN	MINIMUM	R/W, ROW	RIGHT-OF-WAY	VFD	VARIABLE FREQUENCY DRIVE		
CON	CONCENTRIC	FREQ	FREQUENCY	MISC	MISCELLANEOUS	RCPT	REINFORCED CONCRETE PIPE RECEPTACLE	VH	VAPOR HEATER		
CONC	CONCRETE	FRP	FIBER REINFORCED PLASTIC	MJ	MECHANICAL JOINT			VIB	VIBRATION		
CONSTR	CONSTRUCTION	FS	FLORIDA STATUTES, FAR SIDE, FLOW SWITCH	MNPT	MALE NATIONAL PIPE THREAD			VIF	VERIFY IN FIELD		
CONT	CONTINUOUS	FT	FOOT	MO	MOTOR OPERATOR			VP	VAPORIZER		
CORP	CORPORATION	G	GROUND	MP	METERING PUMP			W	WIDE, WATT		
		GAL	GALLON	MPH	MILES PER HOUR			W/	WITH		
DESIGNED SMENARD											
DRAWN JKRAMER											
CHECKED DYONGE											
730 NE WALDO ROAD, GAINESVILLE, FLORIDA 32641 / (352) 377-5821 324 S HYDE PARK AVE, SUITE 250, TAMPA, FLORIDA 33606 / (813) 258-0703											
AQUIFER RECHARGE AT FLATFORD SWAMP SOUTHWEST FLORIDA WATER MANAGEMENT DISTRICT											
ABBREVIATIONS											
APPROVED BY THOMAS W. FRIEDRICH P.E. 61281											
PROJECT NO: 19850-041-01											
DATE: SEP. 2019											
INDEX NO:											
DWG NO: G3											

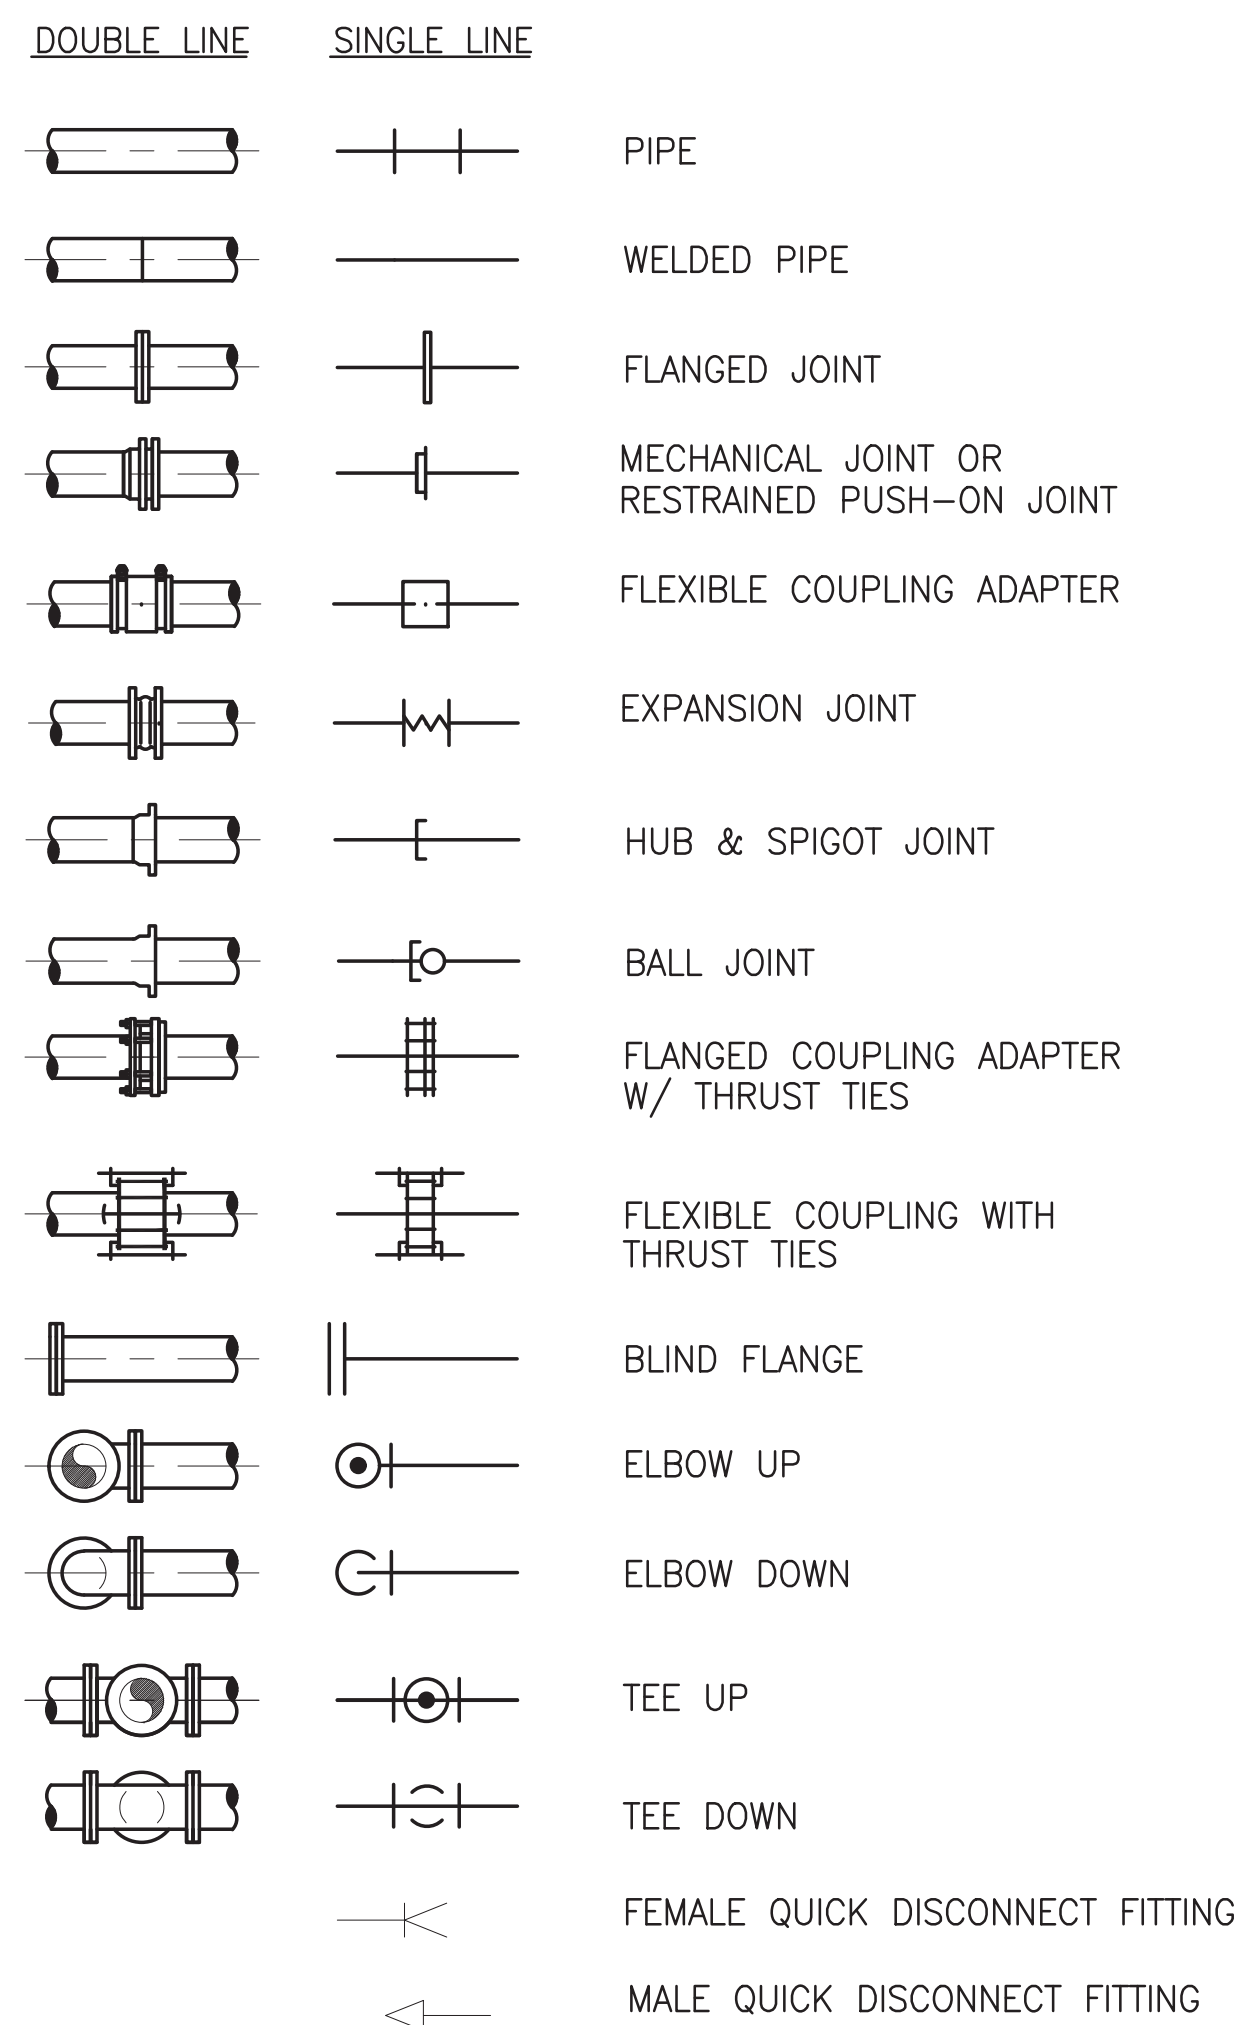BID SET



MECHANICAL LEGEND




 OR  EXISTING PIPE (ABOVE GRADE)
 OR  NEW PIPE (BELOW GRADE)

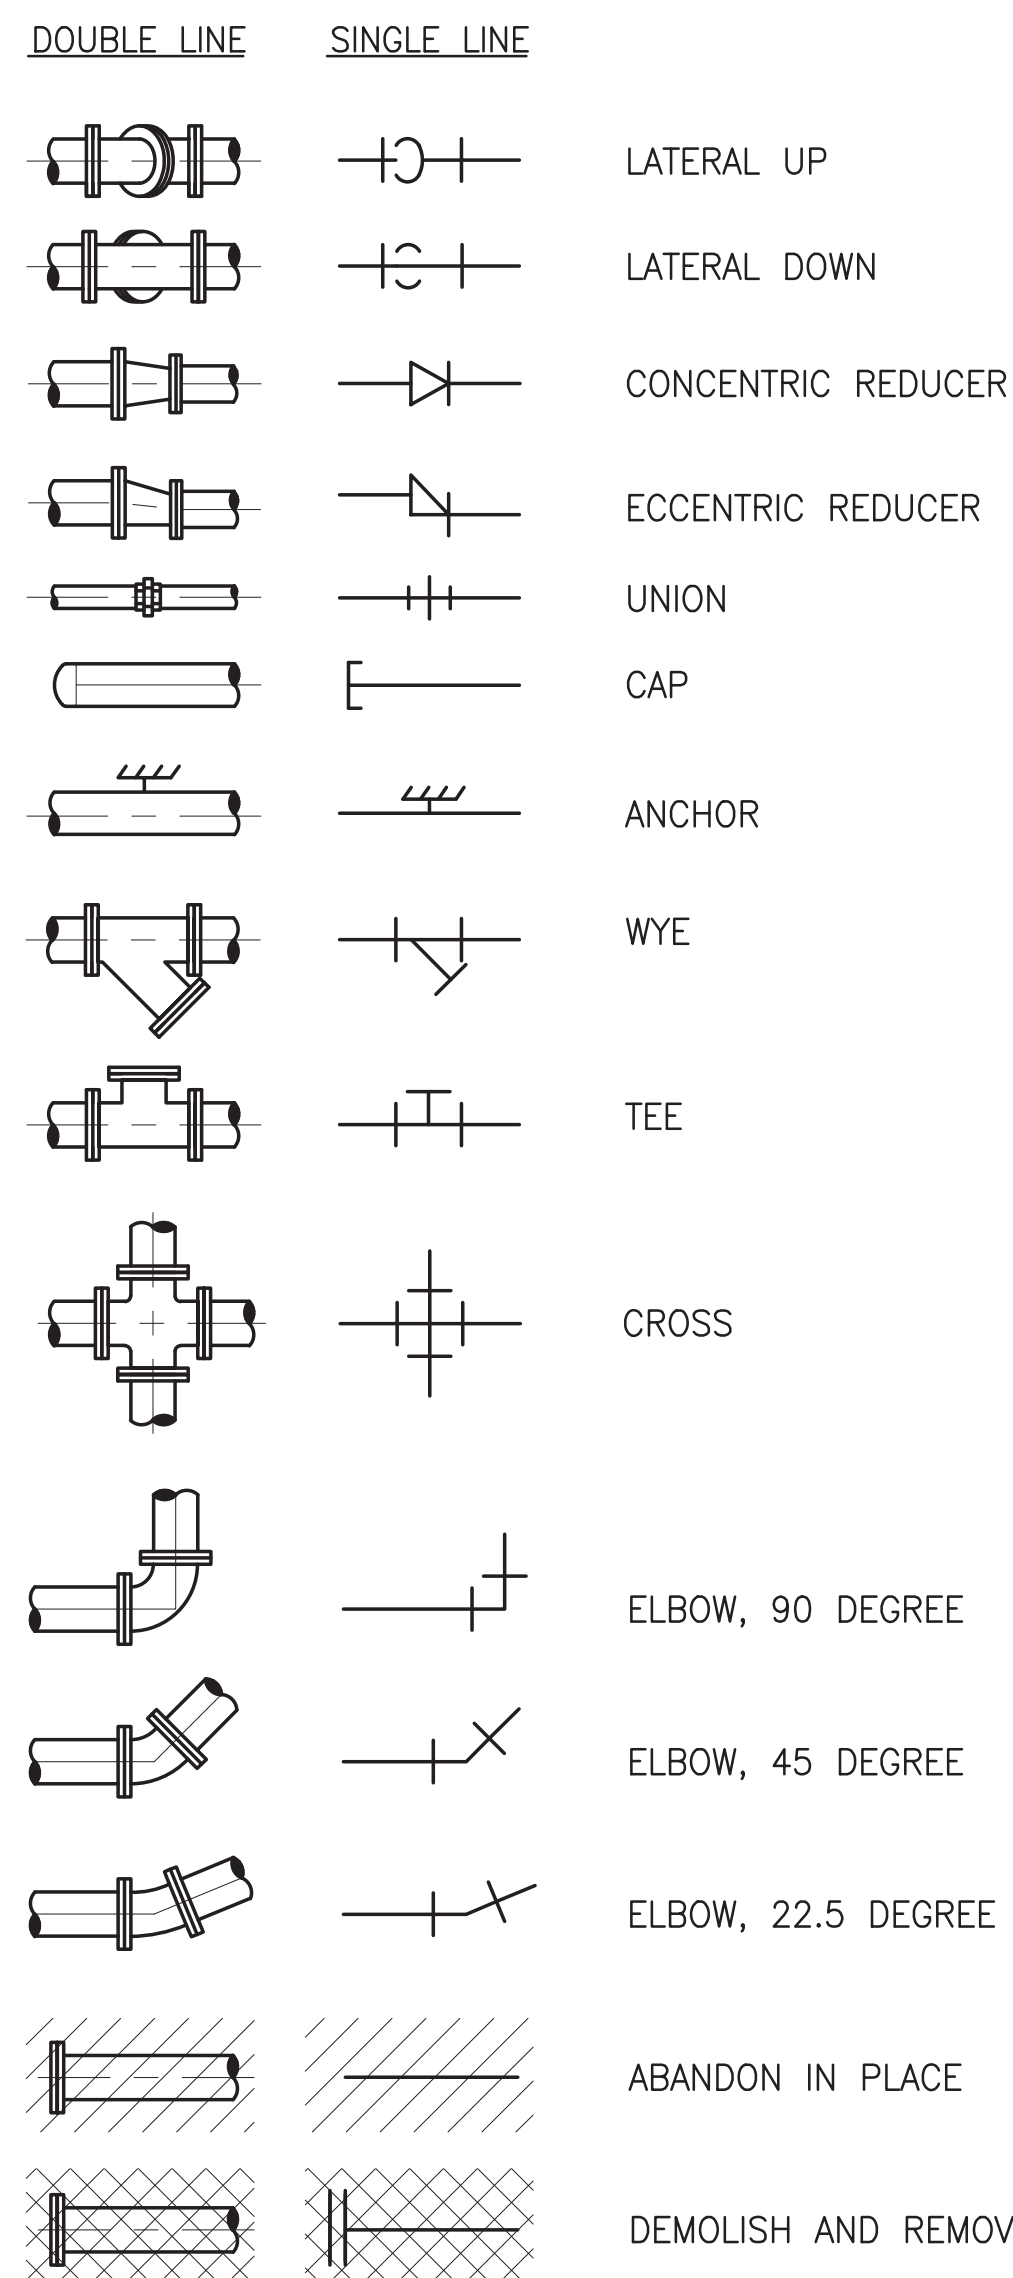

PIPE SUPPORT SYMBOLS

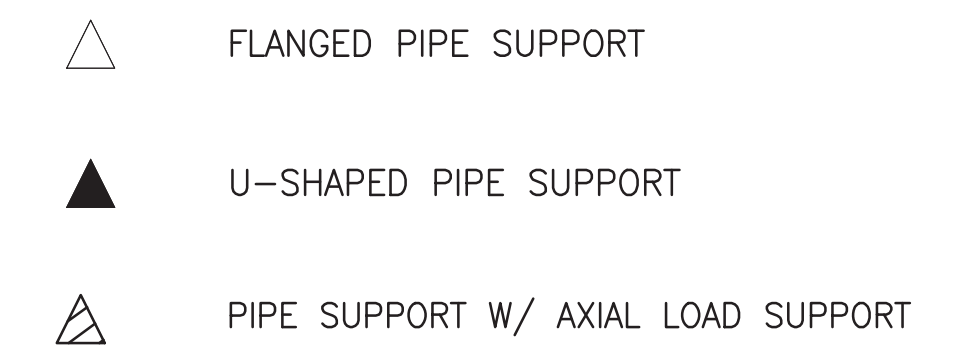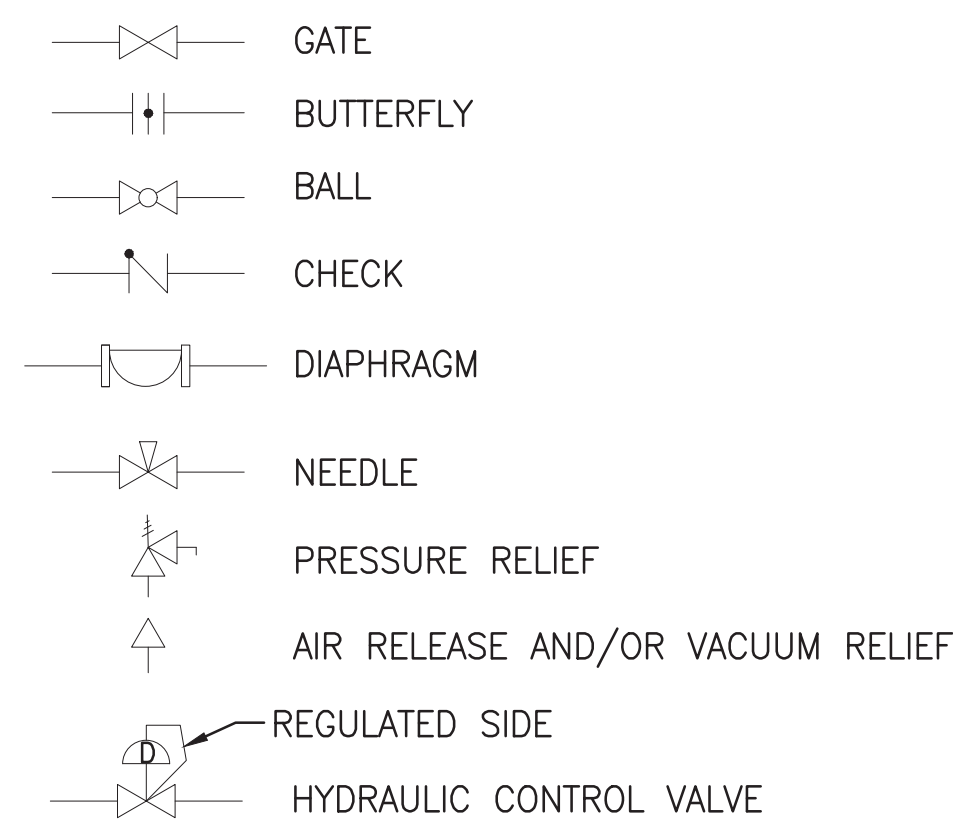

PIPING DESIGNATION

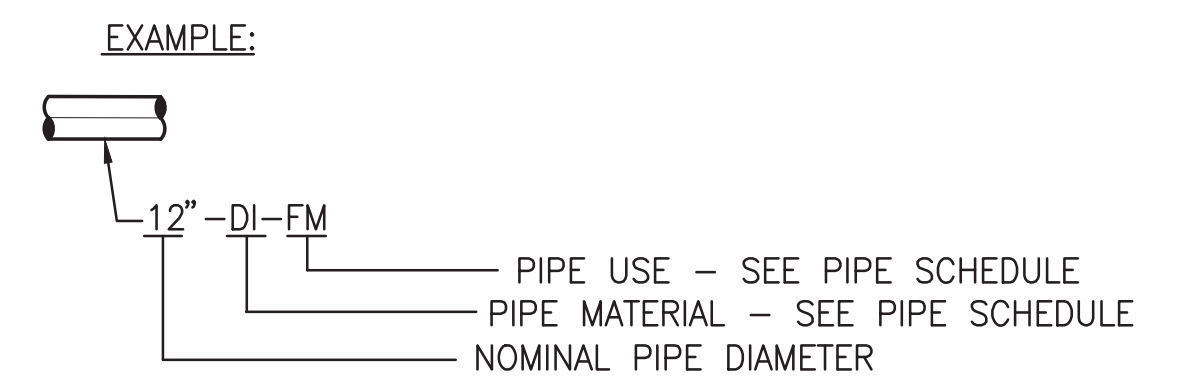


PIPE SCHEDULE

- (1) RESTRAIN ALL JOINTS, FITTINGS, AND VALVES IN ACCORDANCE WITH RESTRAINED JOINT SCHEDULE
- (2) RESTRAIN ALL JOINTS, FITTINGS, AND VALVES INCLUDING NEW TO EXISTING


ABBREVIATION	FLOW STREAM IDENTIFICATION	PIPE/DUCT MATERIAL	PIPE MATERIAL ABBREV	SPECIFICATION NUMBER	PIPE LINING	NORMAL MAX OPERATING PRESSURE (PSIG)	FIELD TEST PRESSURE (PSIG)	RESTRAINT SYSTEM NOTES
24" –FPVC–GR	GRAVITY	DR 25 FUSABLE POLYVINYL CHLORIDE	FPVC	15148	N/A	5	10	(2)
12" –FPVC–FM	FORCE MAIN	DR 18 FUSABLE POLYVINYL CHLORIDE	FPVC	15148	N/A	50	150	(2)
6" /10" /12" –DI–FM	FORCE MAIN	DUCTILE IRON	DI	15155	CERAMIC EPOXY	50	150	(2)
3" /10" –SS–WELL	RECHARGE WELL	TYPE 304L SCH 40 STAINLESS STEEL	SS	15276	N/A	50	150	(2)
2" –PVC–DRAIN	WELL BUILDING	POLYVINYL CHLORIDE	PVC	15290	N/A	5	10	N/A
10" –PVC–VENT	VENT	SCH 40 POLYVINYL CHLORIDE	PVC	15291	N/A	50	N/A	N/A
2" –PVC–FM	MONITORING WELL	SCH 80 POLYVINYL CHLORIDE	PVC	15290	N/A	50	150	N/A

					DESIGNED SMENARD		<div><p>JonesEdmunds</p><p>CERTIFICATE OF AUTHORIZATION #1841</p><p>730 NE WALDO ROAD, GAINESVILLE, FLORIDA 32641 / (352) 377-5821</p><p>324 S HYDE PARK AVE, SUITE 250, TAMPA, FLORIDA 33606 / (813) 258-0703</p></div>	<div><p>AQUIFER RECHARGE AT FLATFORD SWAMP</p><p>SOUTHWEST FLORIDA WATER MANAGEMENT DISTRICT</p></div>	<div><p>LEGENDS</p></div>	APPROVED BY		PROJECT NO:	DATE:				
					DRAWN JKRAMER					19850-041-01	SEP. 2019						
					CHECKED DYONGE					INDEX NO:	DWG NO:						
										THOMAS W. FRIEDRICH	G4						
LTR.		DATE		REVISIONS		BY		APPROD.									

SAVED: 1/20/2020 9:24 AM JKRAMER Y:\19850-SWFMD\PROJECTS\041-01_FLATFORD SWAMP AQUIFER RECHARGE\CAD\DWGS\GENERAL\1985004101-G05.DWG

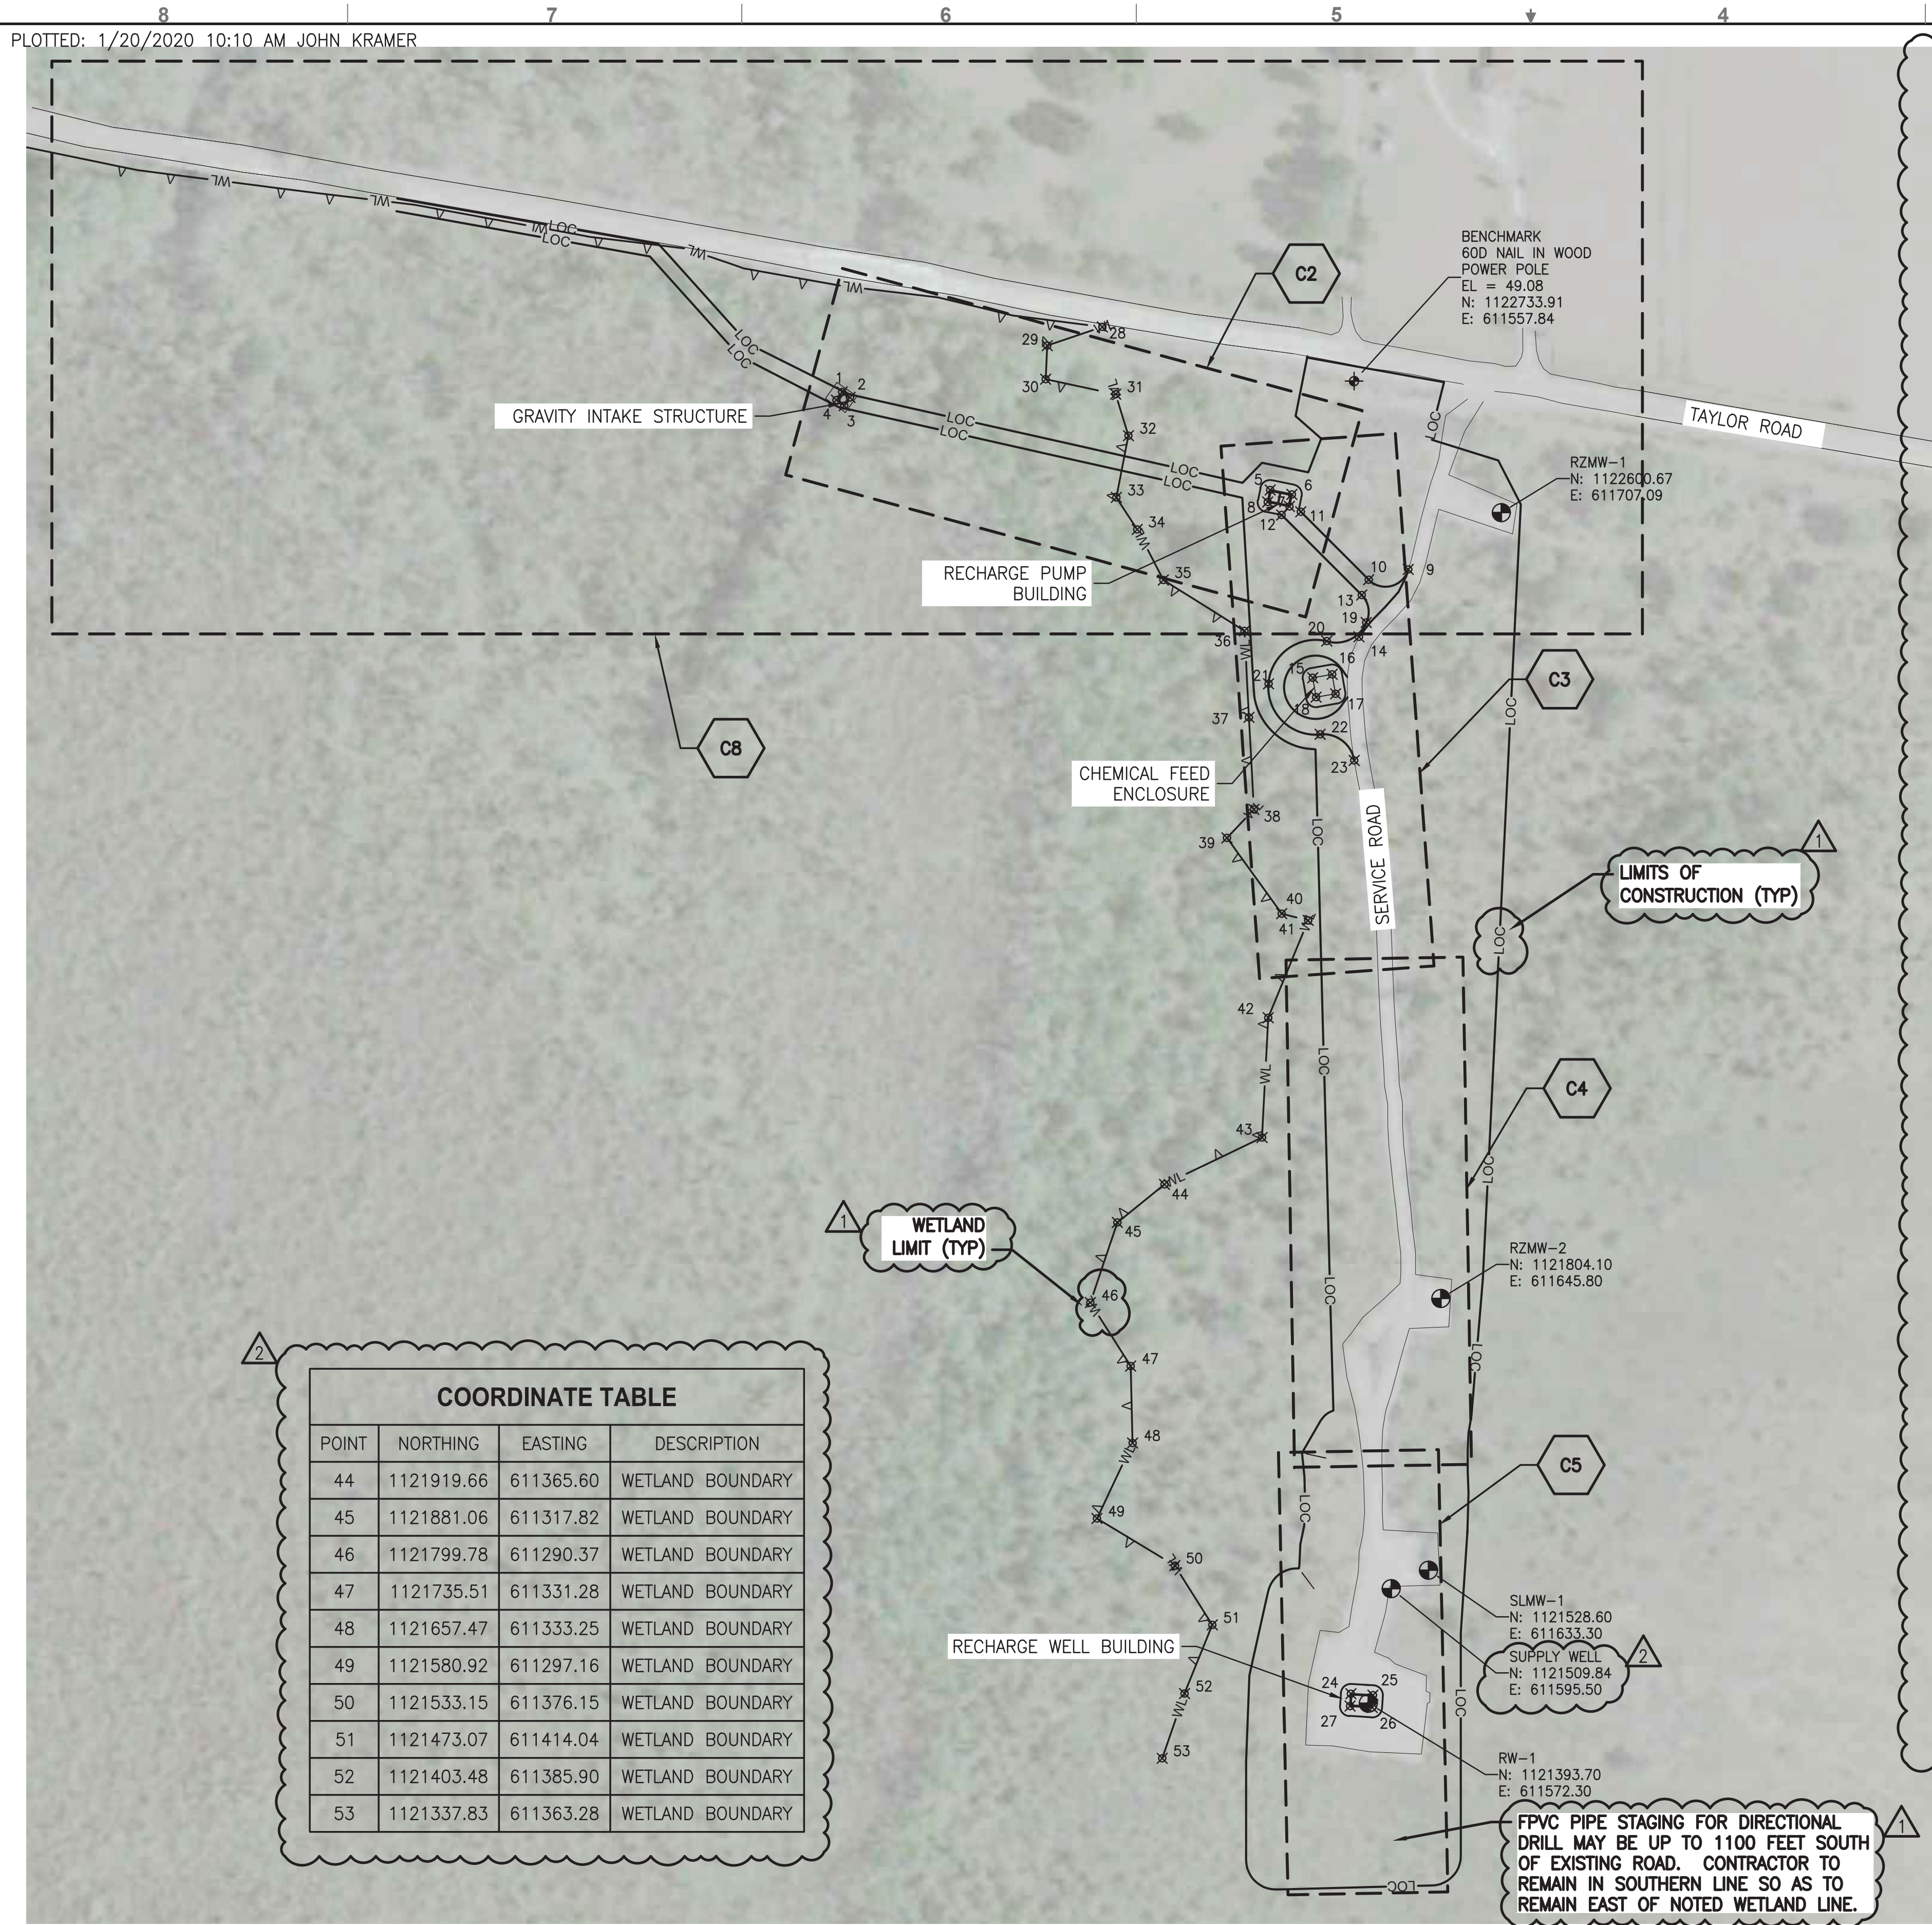

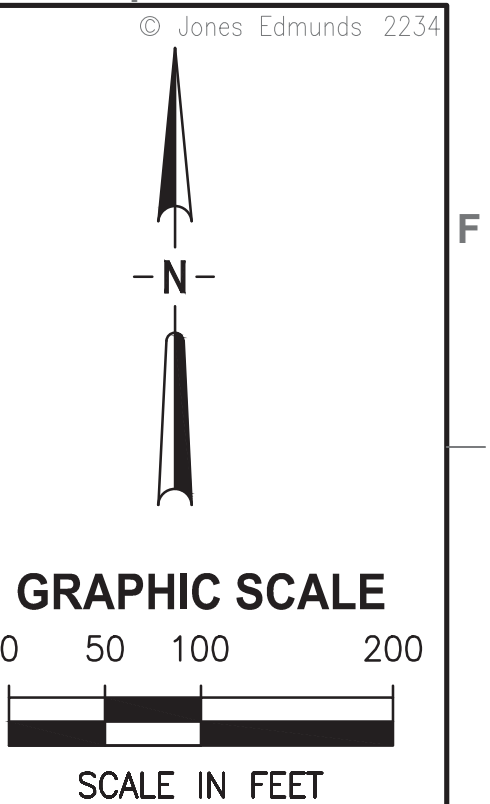

COORDINATE TABLE			
POINT	NORTHING	EASTING	DESCRIPTION
1	1122722.90	611038.82	N CORNER GRAVITY INTAKE STRUCTURE
2	1122717.34	611046.68	E CORNER GRAVITY INTAKE STRUCTURE
3	1122709.11	611040.86	S CORNER GRAVITY INTAKE STRUCTURE
4	1122714.67	611033.00	W CORNER GRAVITY INTAKE STRUCTURE
5	1122623.60	611472.71	NW CORNER RECHARGE PUMP BUILDING
6	1122619.12	611494.76	NE CORNER RECHARGE PUMP BUILDING
7	1122606.87	611492.27	SE CORNER RECHARGE PUMP BUILDING
8	1122611.35	611470.22	SW CORNER RECHARGE PUMP BUILDING
9	1122543.06	611612.71	SE CONNECTION TO EXISTING ROAD AND ACCESS ROAD
10	1122532.60	611572.64	ARC ENDPOINT OF ACCESS ROAD
11	1122601.45	611503.81	NE CONNECTION TO BUILDING RAISED GRADE AND ACCESS ROAD
12	1122598.28	611484.33	S CONNECTION TO BUILDING RAISED GRADE AND ACCESS ROAD
13	1122517.03	611565.58	SE ARC ENDPOINT OF ACCESS ROAD
14	1122474.73	611562.71	SW CONNECTION TO EXISTING ROAD AND ACCESS ROAD
15	1122433.21	611515.84	NW CORNER CHEMICAL FEED ENCLOSURE
16	1122436.67	611535.54	NE CORNER CHEMICAL FEED ENCLOSURE
17	1122416.98	611539.00	SE CORNER CHEMICAL FEED ENCLOSURE
18	1122413.51	611519.30	SW CORNER CHEMICAL FEED ENCLOSURE
19	1122489.25	611570.04	NE CONNECTION TO ACCESS ROADS
20	1122470.42	611530.15	NORTHERN QUADRANT OF ACCESS ROAD
21	1122427.12	611471.12	WESTERN QUADRANT OF ACCESS ROAD
22	1122375.93	611523.45	SOUTHERN QUADRANT OF ACCESS ROAD
23	1122349.47	611557.95	SE CONNECTION TO EXISTING ROAD AND ACCESS ROAD
24	1121403.26	611554.50	NW CORNER RECHARGE WELL BUILDING
25	1121401.84	611576.96	NE CORNER RECHARGE WELL BUILDING
26	1121389.37	611576.17	SE CORNER RECHARGE WELL BUILDING
27	1121390.79	611553.71	SW CORNER
28	1122788.87	611302.61	WETLAND BOUNDARY
29	1122769.96	611246.74	WETLAND BOUNDARY
30	1122735.85	611245.13	WETLAND BOUNDARY
31	1122720.69	611316.16	WETLAND BOUNDARY
32	1122678.63	611329.03	WETLAND BOUNDARY
33	1122615.99	611316.74	WETLAND BOUNDARY
34	1122583.61	611337.90	WETLAND BOUNDARY
35	1122532.33	611364.45	WETLAND BOUNDARY
36	1122480.74	611446.68	WETLAND BOUNDARY
37	1122393.06	611451.17	WETLAND BOUNDARY
38	1122299.69	611456.26	WETLAND BOUNDARY
39	1122270.94	611428.93	WETLAND BOUNDARY
40	1122194.05	611484.42	WETLAND BOUNDARY
41	1122187.24	611511.23	WETLAND BOUNDARY
42	1122088.52	611470.73	WETLAND BOUNDARY
43	1121967.11	611464.49	WETLAND BOUNDARY



COORDINATE TABLE			
POINT	NORTHING	EASTING	DESCRIPTION
44	1121919.66	611365.60	WETLAND BOUNDARY
45	1121881.06	611317.82	WETLAND BOUNDARY
46	1121799.78	611290.37	WETLAND BOUNDARY
47	1121735.51	611331.28	WETLAND BOUNDARY
48	1121657.47	611333.25	WETLAND BOUNDARY
49	1121580.92	611297.16	WETLAND BOUNDARY
50	1121533.15	611376.15	WETLAND BOUNDARY
51	1121473.07	611414.04	WETLAND BOUNDARY
52	1121403.48	611385.90	WETLAND BOUNDARY
53	1121337.83	611363.28	WETLAND BOUNDARY

FPVC PIPE STAGING FOR DIRECTIONAL DRILL MAY BE UP TO 1100 FEET SOUTH OF EXISTING ROAD. CONTRACTOR TO REMAIN IN SOUTHERN LINE SO AS TO REMAIN EAST OF NOTED WETLAND LINE.


					DESIGNED	<u>SMENARD</u>
					DRAWN	<u>JKRAMER</u>
	JAN/2020	ADDENDUM 1--COORD./WELL. RELOCATE	JTK	SPM		
	JAN/2020	ADDENDUM 1--TEXT FONT ADJUSTMENTS	JTK	SPM		
LTR.	DATE	REVISIONS	BY	APPRD.	CHECKED	<u>DYONGE</u>

JonesEdmunds
CERTIFICATE OF AUTHORIZATION #1841
730 NE WALDO ROAD, GAINESVILLE, FLORIDA 32641 / (352) 377-5821
324 S HYDE PARK AVE, SUITE 250, TAMPA, FLORIDA 33606 / (813) 258-0703


AQUIFER RECHARGE AT FLATFORD SWAMP
SOUTHWEST FLORIDA WATER MANAGEMENT DISTRICT


KEY MAP

APPROVED BY	PROJECT NO:	DATE:
THOMAS W. FRIEDRICH	19850-041-01	SEP. 2019
P.E. 61281	INDEX NO:	DWG NO:
		G5

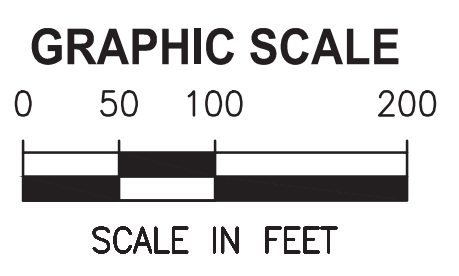
**BID SET**


						DESIGNED	SMENARD		<div><div><div><div><div></div><div></div></div><div><div></div><div></div></div></div><div><div></div><div></div></div><div><div></div><div></div></div></div><div>JonesEdmunds</div><div>CERTIFICATE OF AUTHORIZATION #1841 730 NE WALDO ROAD, GAINESVILLE, FLORIDA 32641 / (352) 377-5821 324 S HYDE PARK AVE, SUITE 250, TAMPA, FLORIDA 33606 / (813) 258-0703</div></div> <div>AQUIFER RECHARGE AT FLATFORD SWAMP SOUTHWEST FLORIDA WATER MANAGEMENT DISTRICT</div> <div>CIVIL SITE PLAN</div> <div>APPROVED BY THOMAS W. FRIEDRICH P.E. 61281</div> <div>PROJECT NO: 19850-041-01</div> <div>DATE: SEP. 2019</div>										INDEX NO:		DWG NO: C1					
						DRAWN	JKRAMER																			
<div><div><div><div><div></div><div></div></div><div><div></div><div></div></div></div><div><div></div><div></div></div><div><div></div><div></div></div></div><div>JAN/2020</div><div>ADDENDUM 1-COORD./WELL RELOCATE</div><div>JTK</div><div>SPM</div></div> <div><div><div><div><div></div><div></div></div><div><div></div><div></div></div></div><div><div></div><div></div></div><div><div></div><div></div></div></div><div>JAN/2020</div><div>ADDENDUM 1-TEXT AND UTILITY ADJUST.</div><div>JTK</div><div>SPM</div></div>																										
LTR.	DATE	REVISIONS		BY	APPRD.	CHECKED	DYONGE												P.E. 61281				C1			

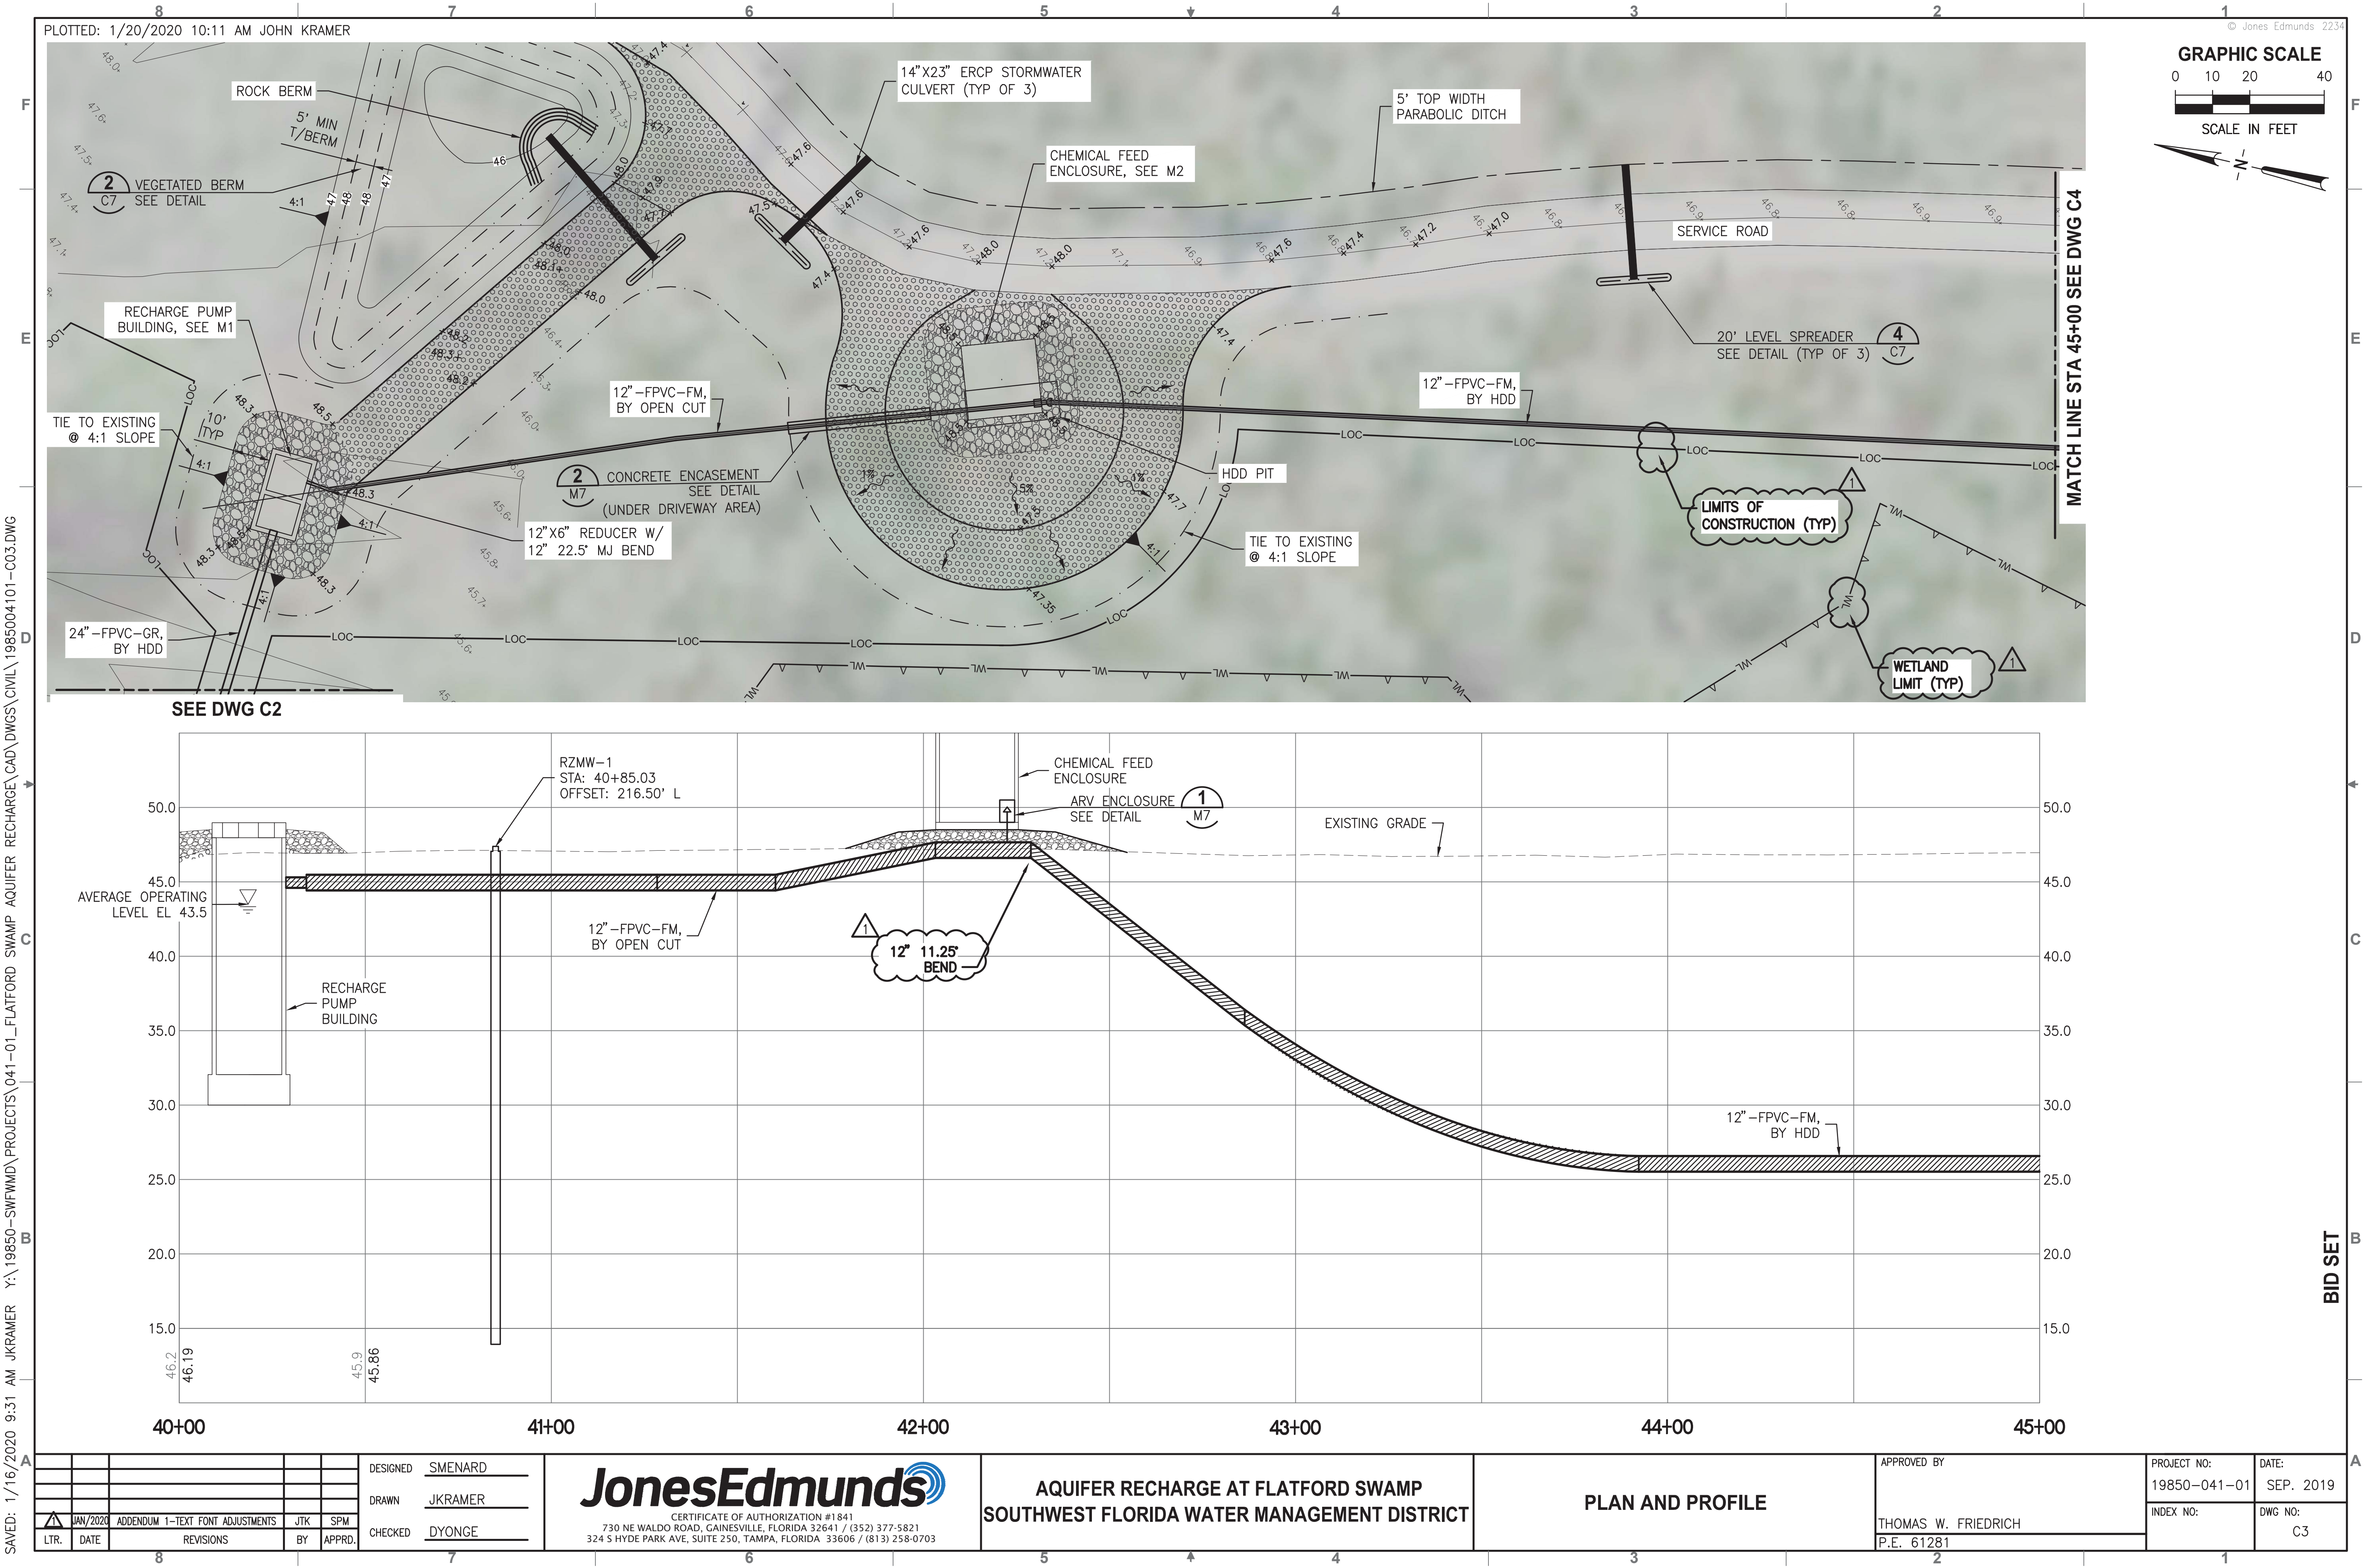



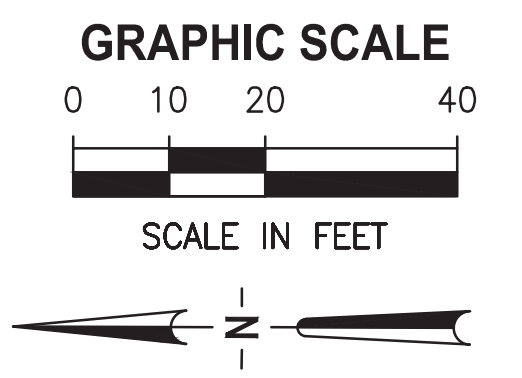


SAVED: 1/14/2020 11:30 AM SMENARD Y:\19850-SWFWMD\PROJECTS\041-01_FLATFORD SWAMP AQUIFER RECHARGE\CAD\DWGS\CIVIL\1985004101-C04.DWG

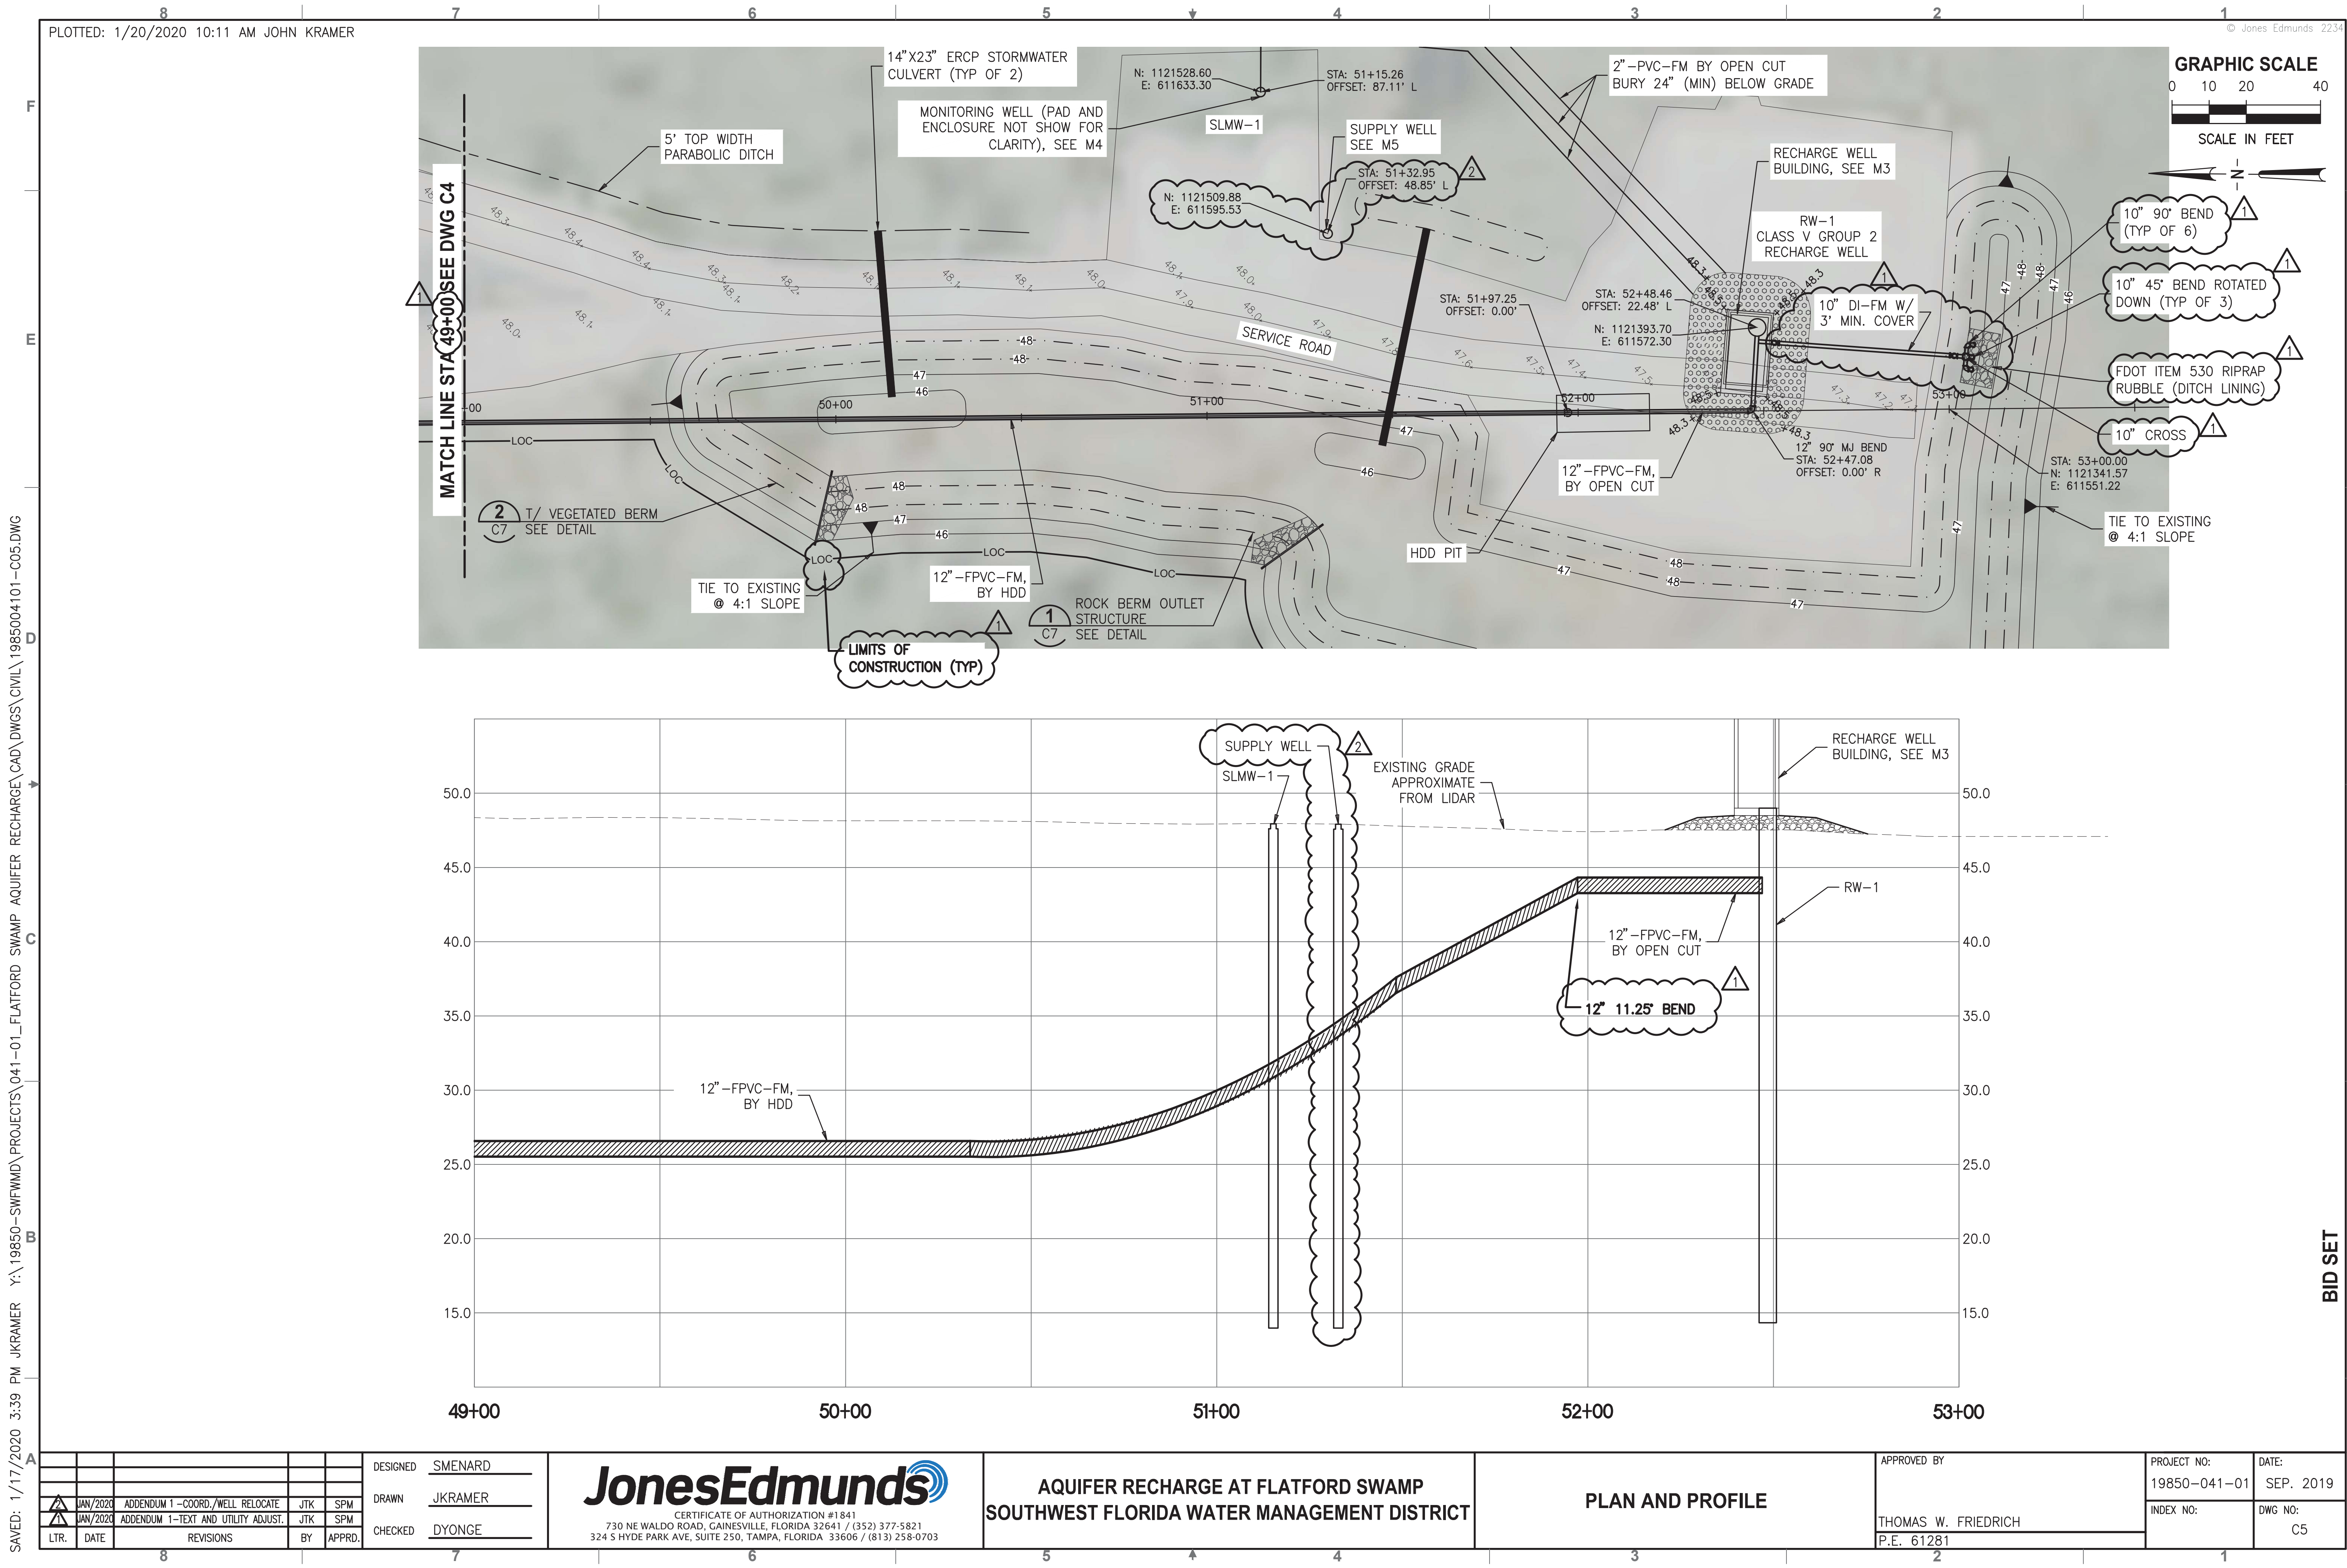


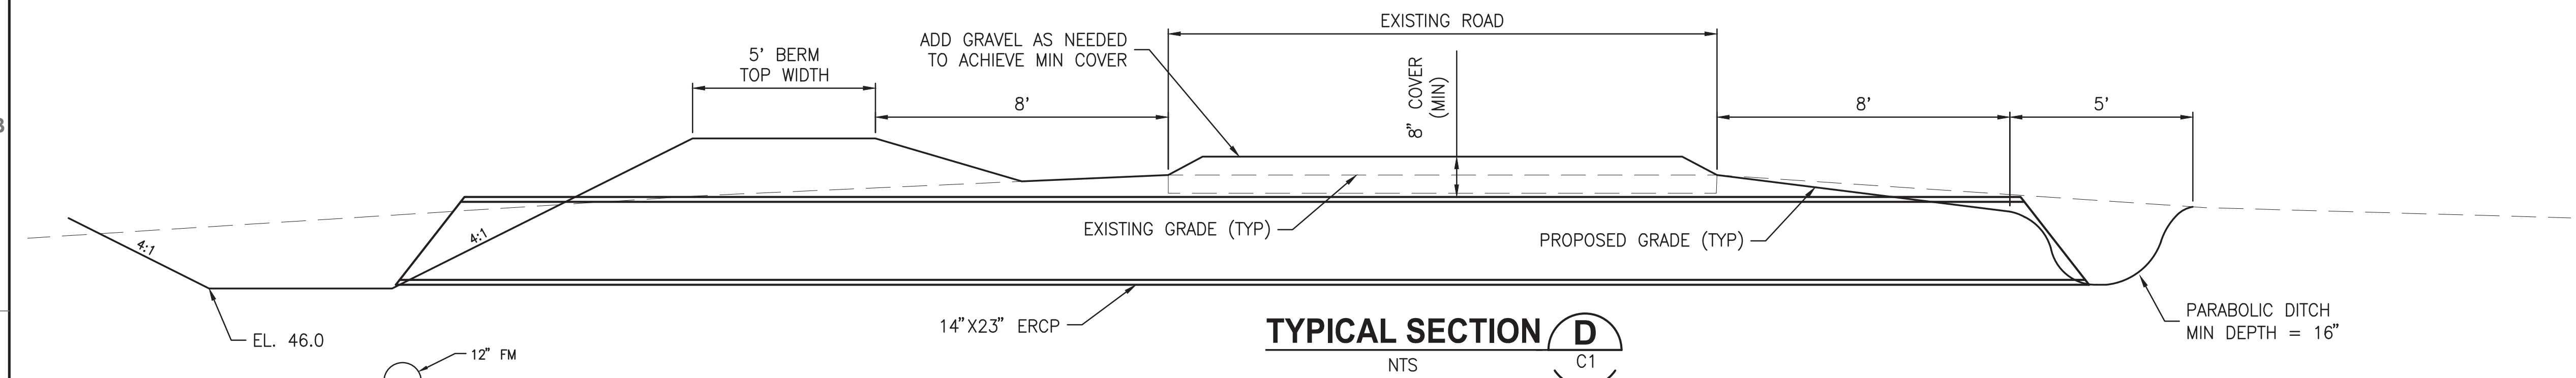[illegible]

SAVED: 1/14/2020 8:53 AM JKRAMER Y:\19850-SWFWM\PROJECTS\041-01_FLATFORD SWAMP AQUIFER RECHARGE\CAD\DWGS\CIVIL\1985004101-C07.DWG

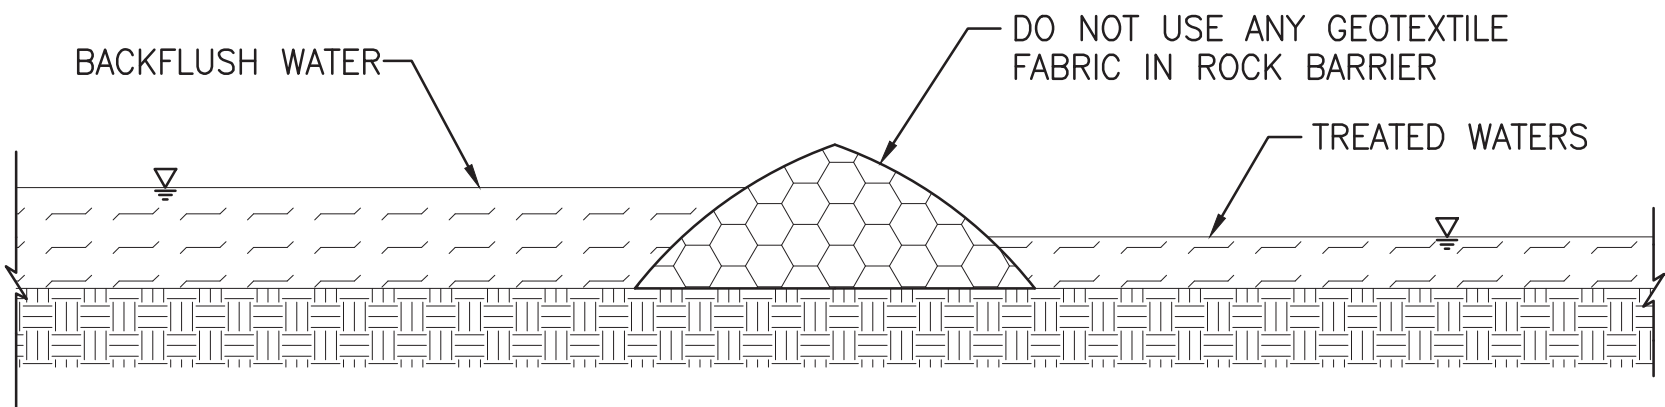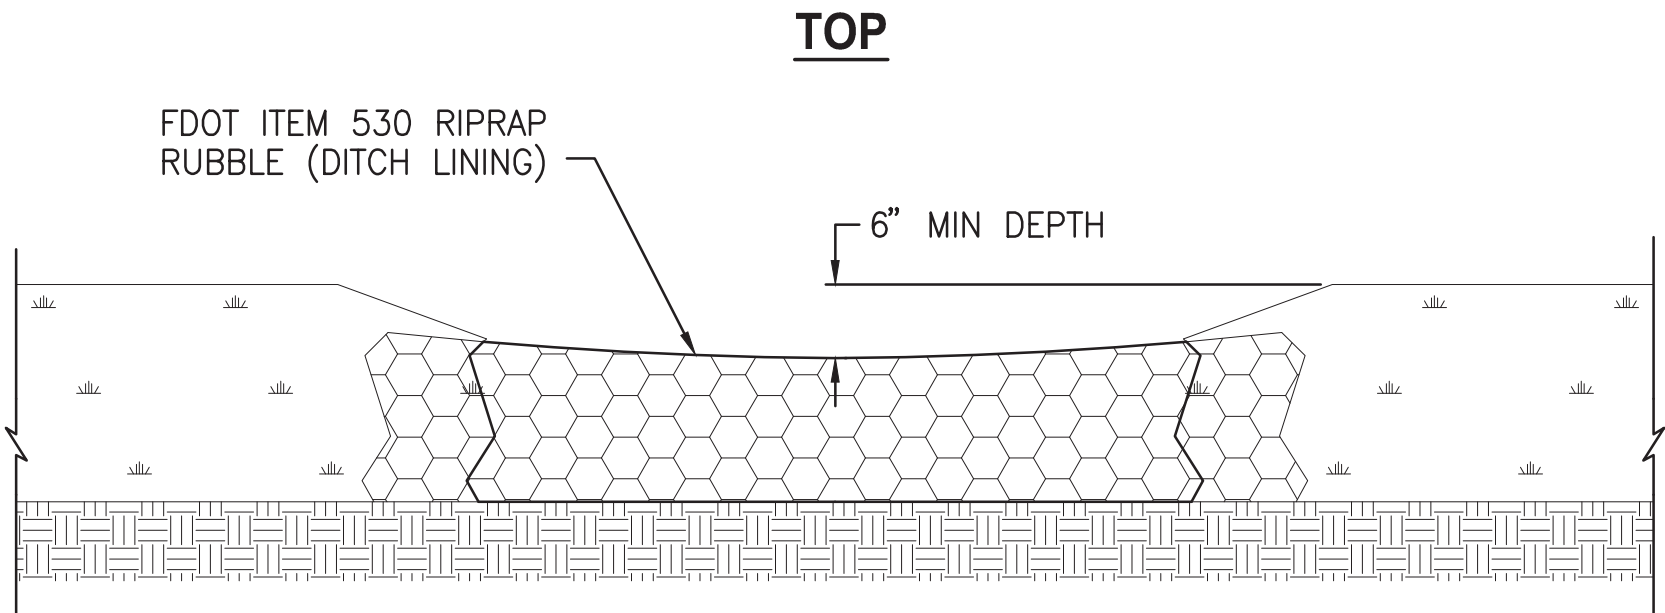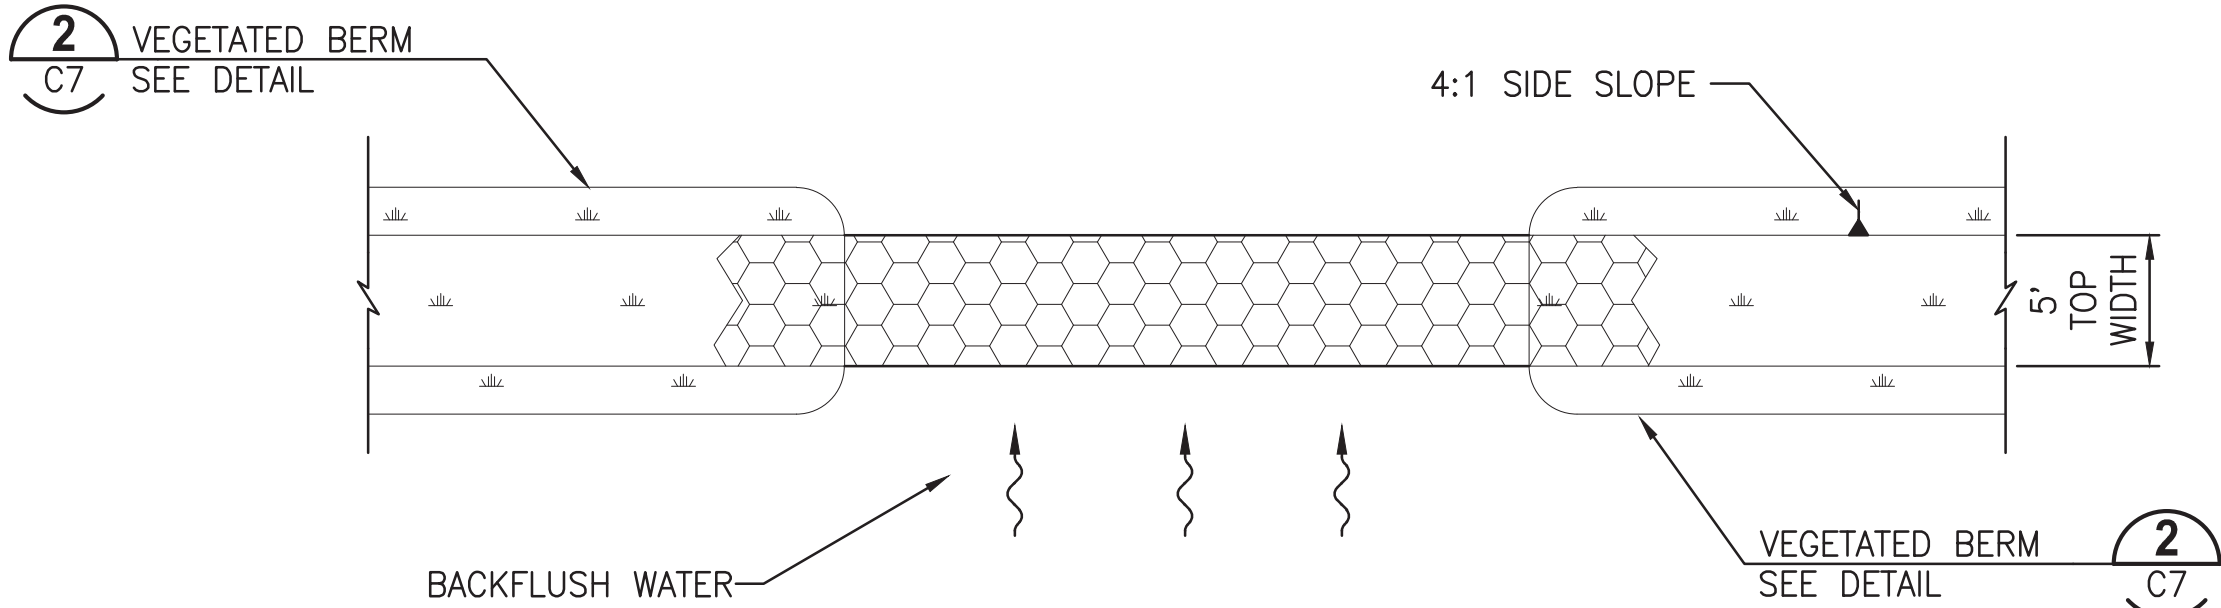


ROCK BERM OUTLET STRUCTURE DETAIL 1

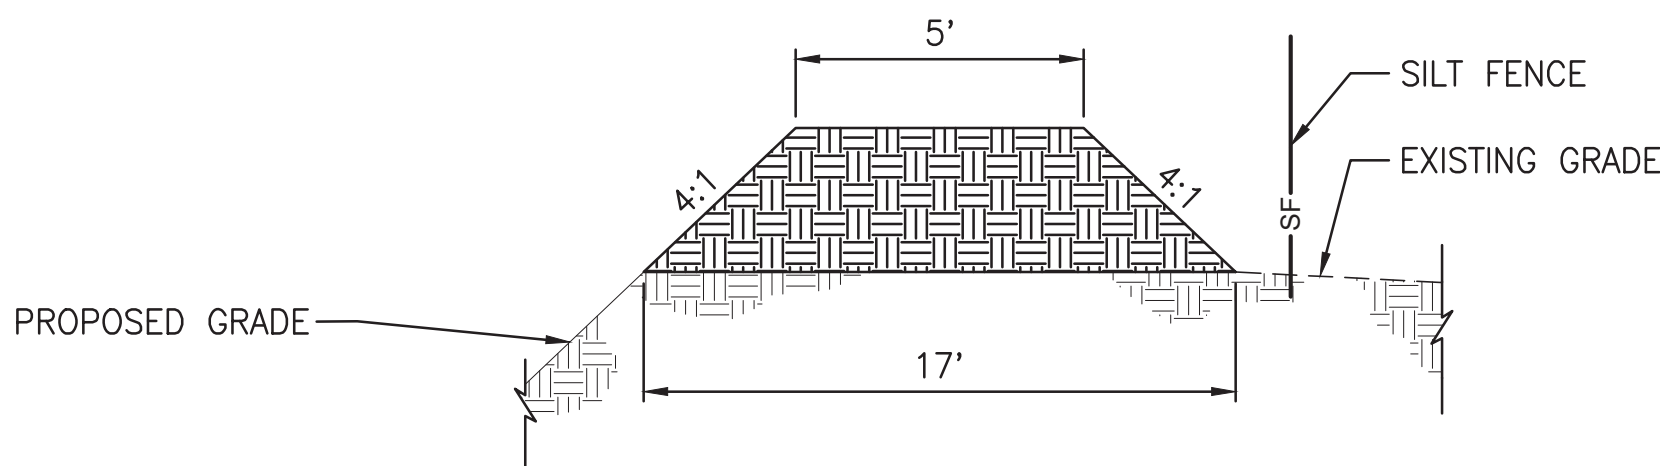



NOTES:

1. BERM SHALL BE COMPACTED TO PREVENT FAILURE.
2. WITHIN 7 DAYS OF CONSTRUCTION, BERM SHALL BE STABILIZED BY SEEDING AND MULCHING SLOPES AND BERM CREST WITH SEED MIX, PER SPECIFICATION 02920.
3. AREAS THAT FAIL TO ESTABLISH VEGETATIVE COVER TO PREVENT EROSION WILL BE FILLED WITH TOPSOIL AND RESEEDED AS SOON AS THEY ARE IDENTIFIED.
4. DAMAGE CAUSED BY CONSTRUCTION TRAFFIC OR OTHER ACTIVITY MUST BE REPAIRED BEFORE THE END OF EACH WORKING DAY.

VEGETATED BERM 2

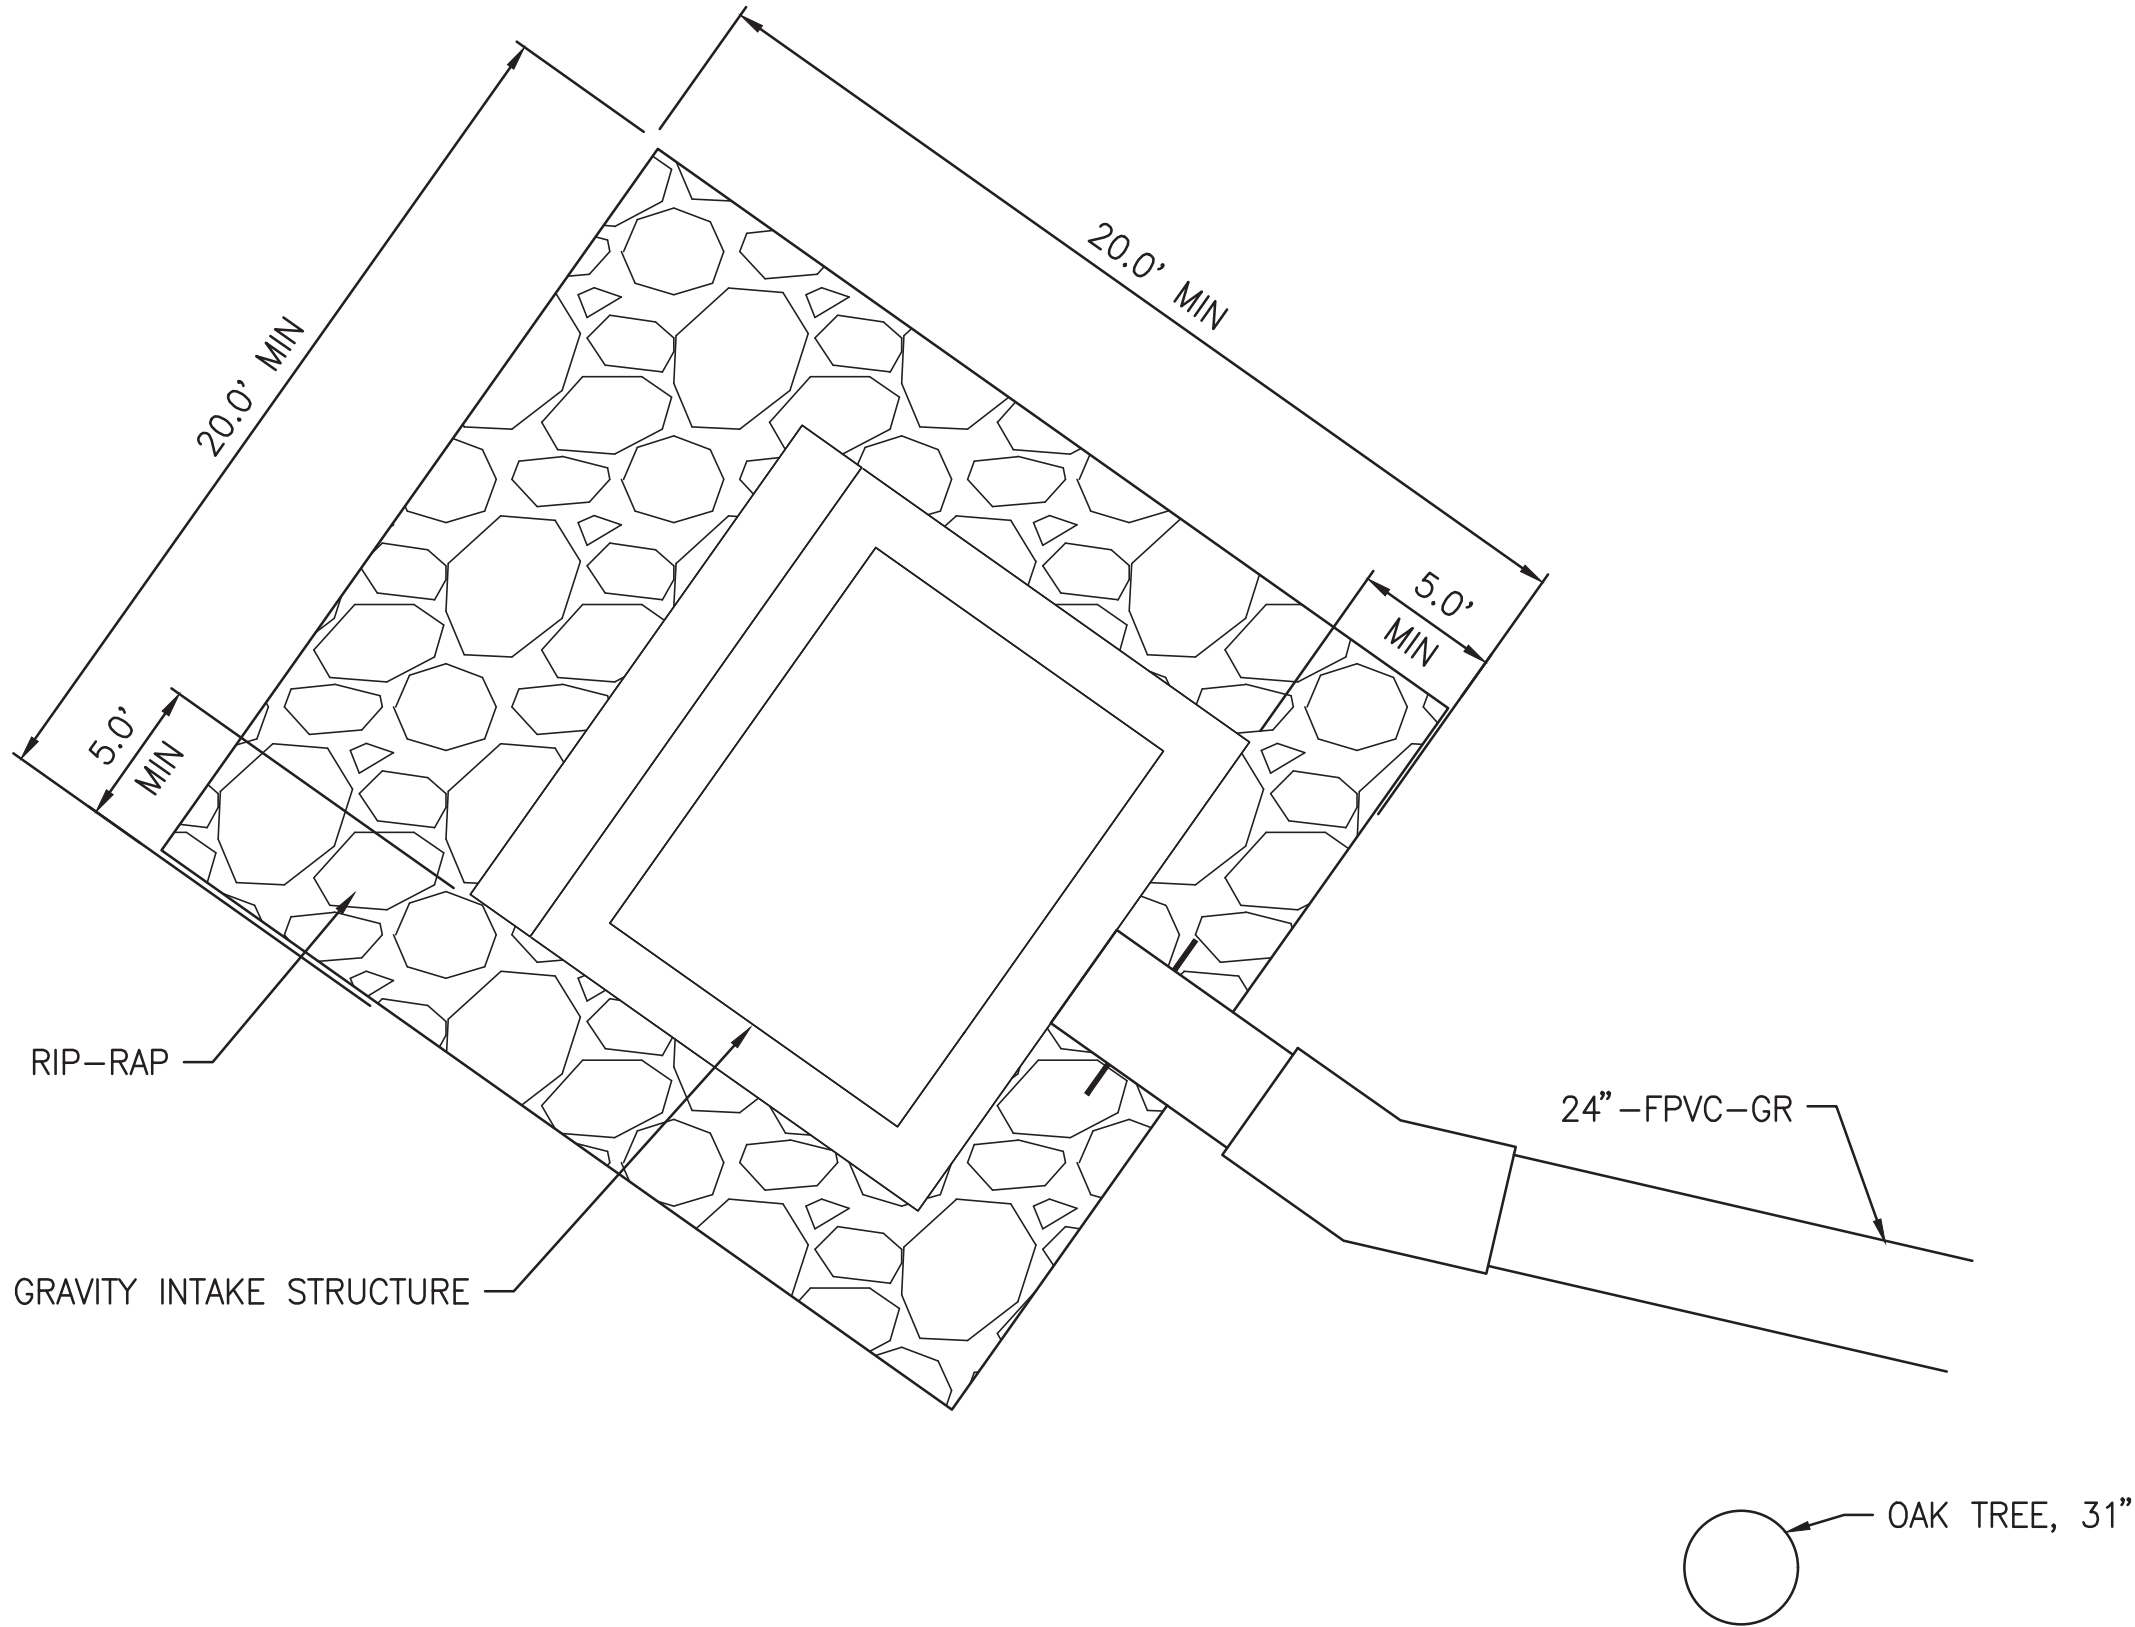


GRAVITY INTAKE STRUCTURE DETAIL 3

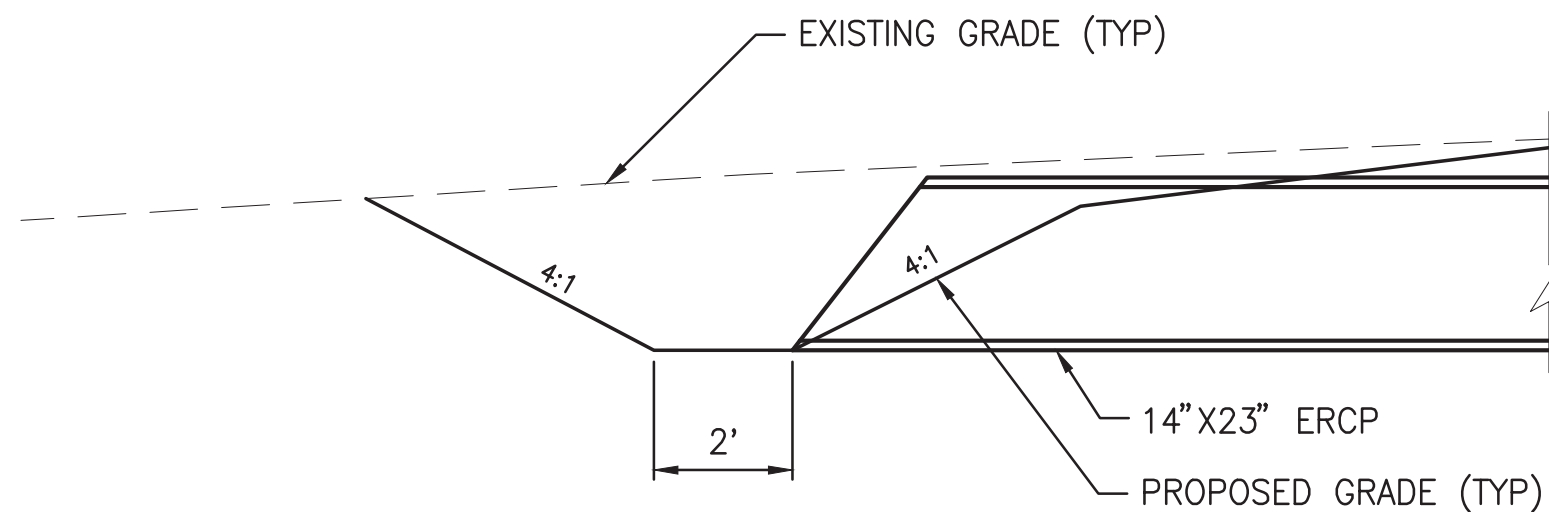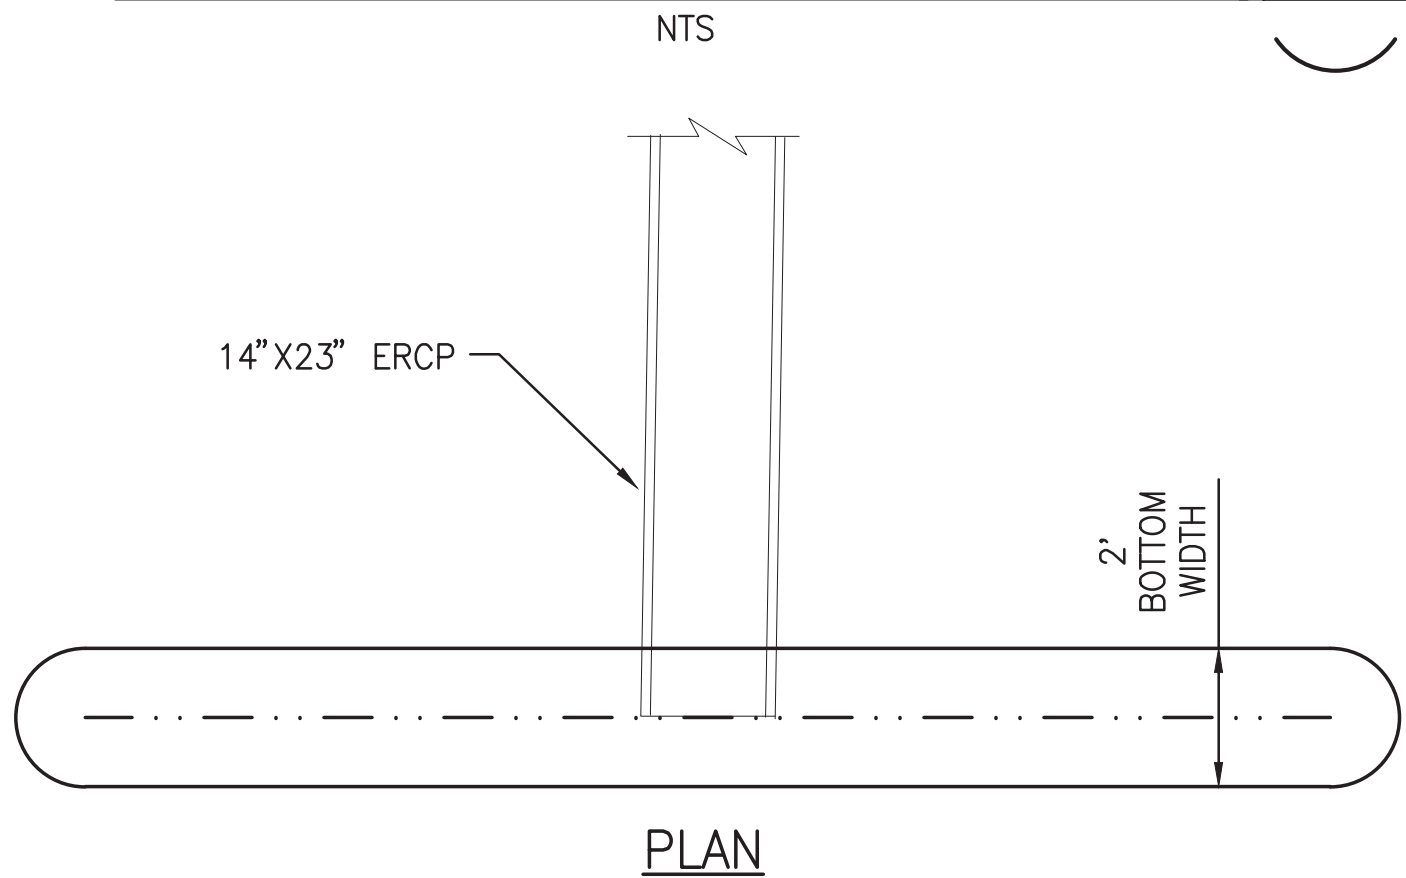

20' LEVEL SPREADER DETAIL 4

						DESIGNED	<u>AGOODDEN</u>	<div><div>JonesEdmunds</div><div>CERTIFICATE OF AUTHORIZATION #1841 730 NE WALDO ROAD, GAINESVILLE, FLORIDA 32641 / (352) 377-5821 324 S HYDE PARK AVE, SUITE 250, TAMPA, FLORIDA 33606 / (813) 258-0703</div></div>	AQUIFER RECHARGE AT FLATFORD SWAMP SOUTHWEST FLORIDA WATER MANAGEMENT DISTRICT	CIVIL DETAILS	APPROVED BY AMY LIANE GOODDEN P.E. # 60097	PROJECT NO:	DATE:
						19850-041-01	SEP. 2019						
						INDEX NO:	DWG NO:						
LTR.	DATE	REVISIONS	BY	APPRD.	CHECKED	<u>WNICKEL</u>	C7						

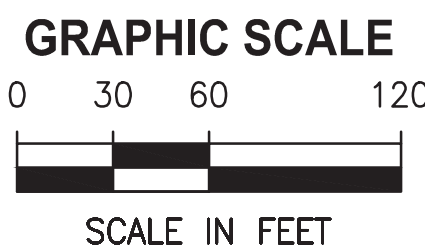

PLAN VIEW

$$1' = 60'$$

EROSION PREVENTION AND CONTROL CONSTRUCTION NOTES:

-
- TEMPORARY STREAM DIVERSION MEASURE
DETERMINED BY CONTRACTOR
- 10' MIN.
- 100 YEAR FLOOD
EL. 46.5
- AVERAGE OPERATING LOW
EL. 43.5
- GRAVITY INTAKE
STRUCTURE
- 24" -FPVC-GR
- MATS OR OTHER
METHOD OF PROTECTING
BANK FROM RUTTING
AND EROSION DAMAGE
- BOTTOM OF STREAM

NTS

JonesEdmunds
 CERTIFICATE OF AUTHORIZATION #1841
 730 NE WALDO ROAD, GAINESVILLE, FLORIDA 32641 / (352) 377-5821
 324 S HYDE PARK AVE, SUITE 250, TAMPA, FLORIDA 33606 / (813) 258-0703

EROSION CONTROL SITE PLAN

PROJECT NO:	DATE:
19850-041-01	SEP. 2019
INDEX NO:	DWG NO:
	C8

SEDIMENT AND EROSION CONTROL NOTES

STORMWATER POLLUTION PREVENTION PLAN

INSPECTIONS MUST OCCUR AT LEAST ONCE A WEEK AND WITHIN 24 HOURS OF THE END OF A STORM EVENT THAT IS 0.50 INCHES OR GREATER

INSPECTOR: _____ FDEP NPDES STORMWATER IDENTIFICATION NUMBER: _____

LOCATION	RAIN DATA	TYPE OF CONTROL (SEE BELOW)	DATE INSTALLED / MODIFIED	CURRENT CONDITION (SEE BELOW)	CORRECTIVE ACTION / OTHER REMARKS

CONDITION CODE:
G = GOOD
C = NEEDS TO BE CLEARED
M = MARGINAL, NEEDS MAINTENANCE OR REPLACEMENT SOON
P = POOR, NEEDS IMMEDIATE MAINTENANCE OR REPLACEMENT
O = OTHER

CONTROL TYPE CODES

1. SILT FENCE	10. STORM DRAIN INLET PROTECTION	19. REINFORCED SOIL RETAINING SYSTEM	28. TREE PROTECTION
2. EARTH DIKES	11. VEGETATIVE BUFFER STRIP	20. GABION	29. DETENTION POND
3. STRUCTURAL DIVISION	12. VEGETATIVE PRESERVATION AREA	21. SEDIMENT BASIN	30. RETENTION POND
4. SWALE	13. RETENTION POND	22. TEMPORARY SEED / SOD	31. WASTE DISPOSAL / HOUSEKEEPING
5. SEDIMENT TRAP	14. CONSTRUCTION ENTRANCE STABILIZATION	23. PERMANENT SEED / SOD	32. DAM
6. CHECK DAM	15. PERIMETER DITCH	24. MULCH	33. SAND BAG
7. PIPE SLOPE DRAIN	16. CURB AND GUTTER	25. HAY BALES	34. OTHER
8. LEVEL SPREADERS	17. PAVED ROAD SURFACE	26. GEOTEXTILE	
9. NOT USED	18. ROCK OUTLET PROTECTION	27. RIP-RAP	


INSPECTOR INFORMATION:

NAME: _____ QUALIFICATION _____ DATE _____


THE ABOVE SIGNATURE ALSO SHALL CERTIFY THAT THIS FACILITY IS IN COMPLIANCE WITH THE STORMWATER POLLUTION PREVENTION PLAN AND THE STATE OF FLORIDA GENERIC PERMIT FOR STORMWATER DISCHARGE FROM LARGE AND SMALL CONSTRUCTION ACTIVITIES IF THERE ARE NOT ANY INCIDENTS OF NON-COMPLIANCE IDENTIFIED ABOVE.

"I CERTIFY UNDER PENALTY OF LAW THAT THIS DOCUMENT AND ALL ATTACHMENTS WERE PREPARED UNDER MY DIRECTION OR SUPERVISION IN ACCORDANCE WITH A SYSTEM DESIGNED TO ASSURE THAT QUALIFIED PERSONNEL PROPERLY GATHERED AND EVALUATED THE INFORMATION SUBMITTED. BASED ON MY INQUIRY OF THE PERSON OR PERSONS WHO MANAGE THE SYSTEM, OR THOSE PERSONS DIRECTLY RESPONSIBLE FOR GATHERING THE INFORMATION, THE INFORMATION SUBMITTED IS, TO THE BEST OF MY KNOWLEDGE AND BELIEF, TRUE, ACCURATE, AND COMPLETE. I AM AWARE THAT THERE ARE SIGNIFICANT PENALTIES FOR SUBMITTING FALSE INFORMATION, INCLUDING THE POSSIBILITY OF FINE AND IMPRISONMENT FOR KNOWING VIOLATIONS."


NAME (RESPONSIBLE AUTHORITY) _____ DATE _____

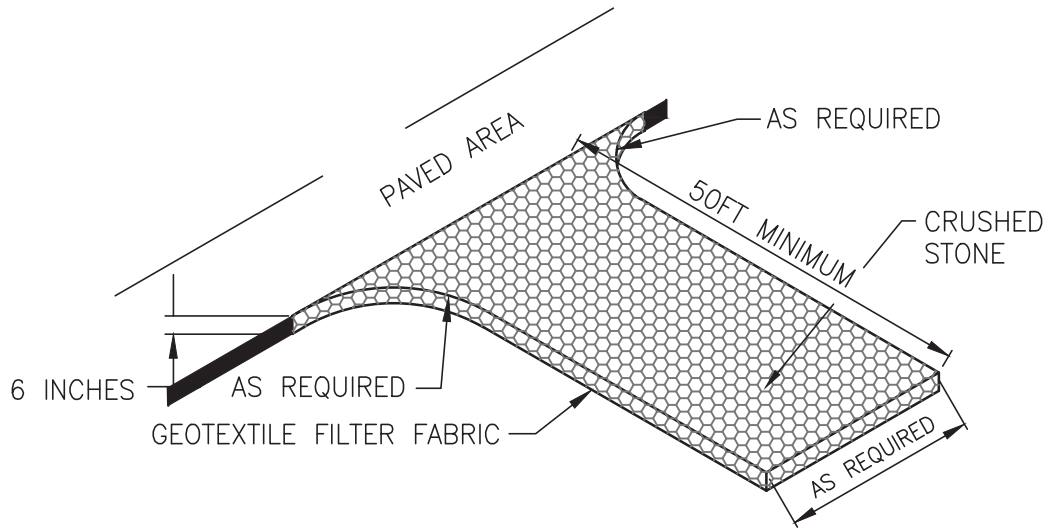

STABILIZED CONSTRUCTION ENTRANCE Co

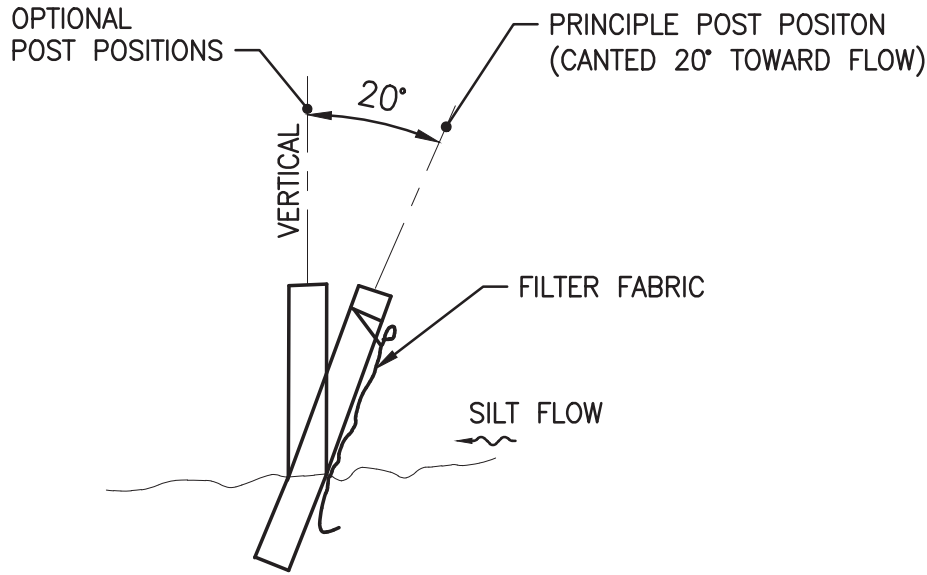


SECTION

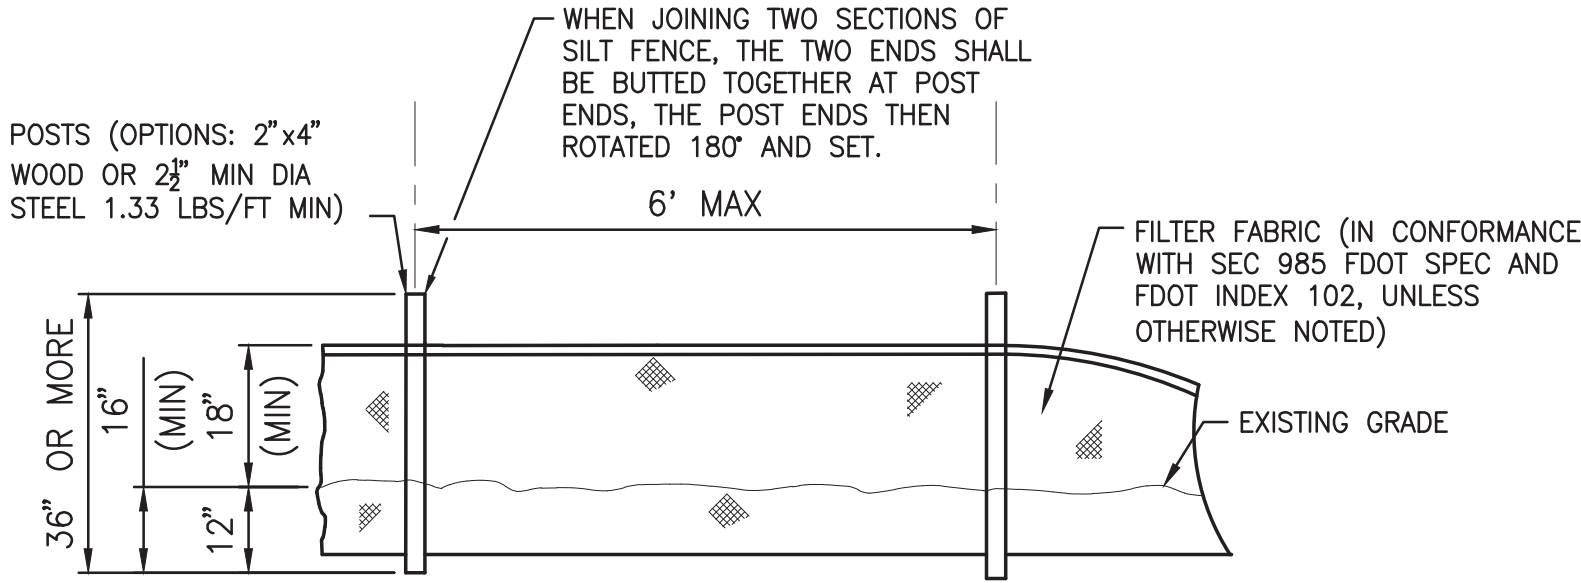


ELEVATION


TYPICAL SILT FENCE Sd1

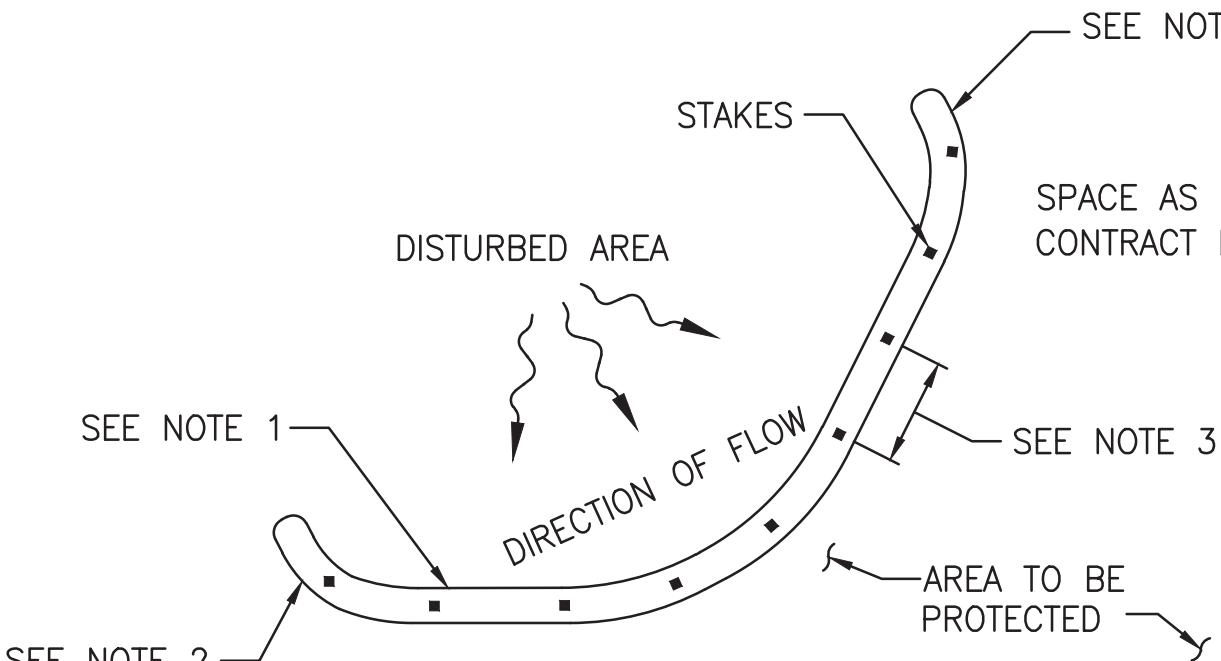

PLAN

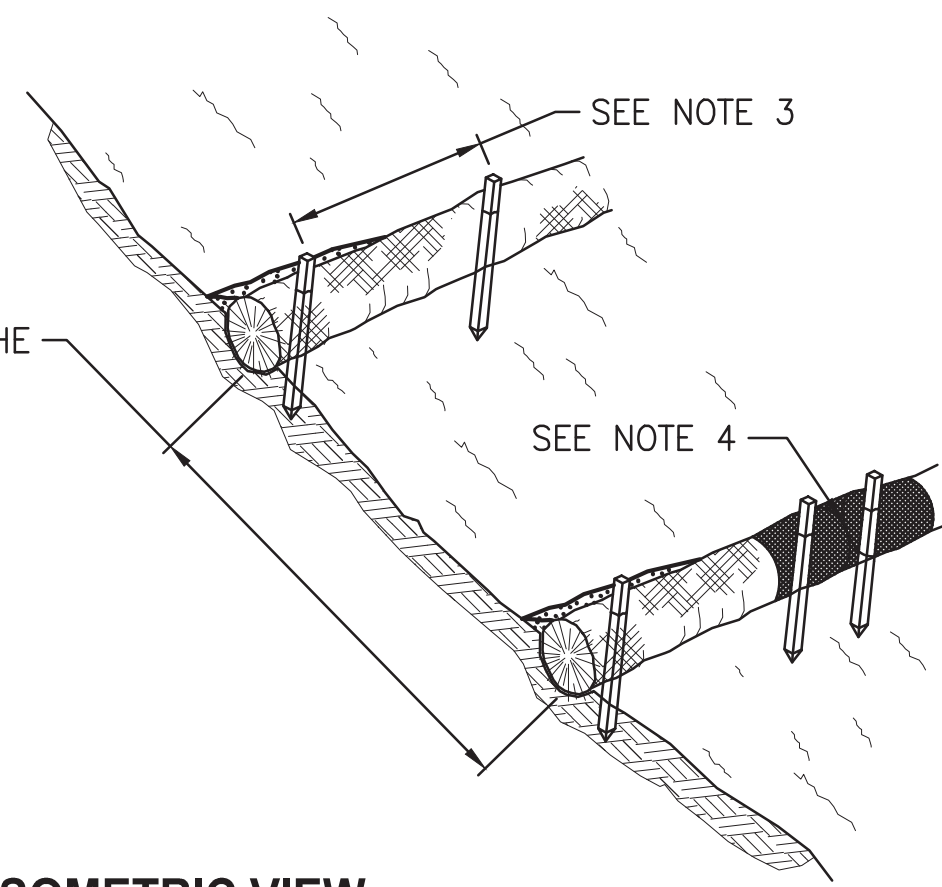

ISOMETRIC VIEW

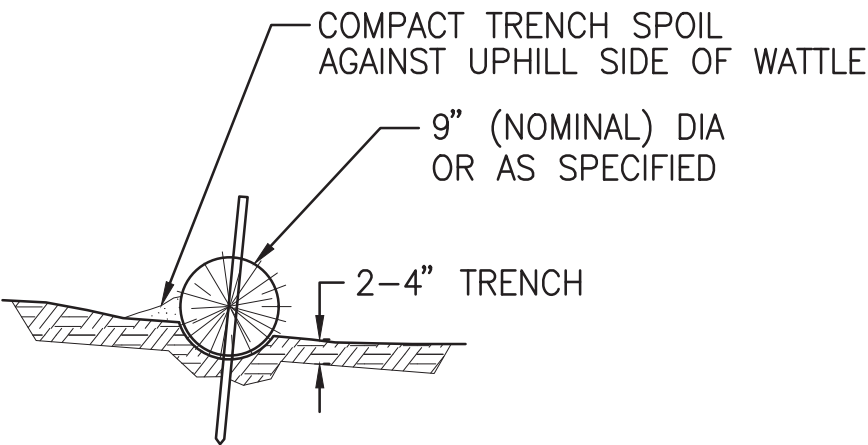

SIDE

- NOTES:
- INSTALL WATTLE ALONG CONTOUR OF SLOPE.
 - TURN ENDS OF WATTLE UPHILL TO PREVENT WATER FROM FLOWING AROUND ENDS.
 - SPACE STAKES AT 4 FT. MAX. INSTALL ADDITIONAL STAKES AS NECESSARY TO PREVENT MOVEMENT AND UNDERMINING.
 - ABUT ENDS OF ADJACENT WATTLES TIGHTLY. WRAP JOINT WITH 36 IN. WIDE SECTION OF SILT FENCE AND SECURE WITH STAKES.

WATTLE Sd2

STRUCTURAL ABBREVIATIONS

- | | | | | | |
|----------|--------------------|-------|--------------------|-------|--------------------|
| @ | AND | EXP | EXPANSION | PEMB | PRE-ENGINEERED |
| # | AT | FE | FIRE EXTINGUISHER | | METAL BUILDING |
| ADDTL | NUMBER | FF | FAR FACE, FINISHED | PERP | PERPENDICULAR |
| ALUM | ADDITIONAL | | FLOOR | PL | PLATE |
| AEWS | ALUMINUM | FG | FINISHED GRADE | PLF | POUND PER LINEAR |
| | AUTOMATIC END | FRP | FIBER REINFORCED | | FOOT |
| | WELDED STUD(S) | | PLASTIC | PT | PRESSURE TREATED |
| ALT | ALTERNATE | FT | FOOT | PROJ | PROJECTION |
| APROX | APPROXIMATE(LY) | FTV | FOOTING | PSF | POUNDS PER SQUARE |
| BLD | BUILDING | FG | FIELD VERIFY | | FOOT |
| BM | BEAM | GA | GAGE | PSI | POUNDS PER SQUARE |
| BOT | BOTTOM | GALV | GALVANIZED | | INCH |
| CJ | CONTROL JOINT | HOOK | HOOK | PVC | POLYVINYL CHLORIDE |
| CL | CENTER LINE | HORIZ | HORIZONTAL | R | RADIUS |
| CLR | CLEAR | HSS | HOLLOW STRUCTURAL | REINF | REINFORCING |
| CMU | CONCRETE MASONRY | | SECTION | REQD | REQUIRED |
| | UNIT | HP | HIGH POINT | RO | ROUGH OPENING |
| COL | COLUMN | ID | INSIDE DIAMETER | SCHED | SCHEDULE(D) |
| CONC | CONCRETE | JT | JOINT | SIM | SIMILAR |
| CONN | CONNECTION | LB(S) | POUND(S) | SJ | SAWCUT JOINT |
| CONST JT | CONSTRUCTION JOINT | LONG | LONGITUDINAL | SMS | SHEET METAL SCREW |
| CONT | CONTINUOUS | LP | LOW POINT | SPECS | SPECIFICATIONS |
| DIA | DIAMETER | MANUF | MANUFACTURER | SQ | SQUARE |
| DEG | DEGREE(S) | MATL | MATERIAL | SS | STAINLESS STEEL |
| DO | DITTO | MAX | MAXIMUM | STD | STANDARD |
| DWG | DRAWING | MECH | MECHANICAL | STL | STEEL |
| DWL | DOWEL(S) | MFR | MANUFACTURER | TL | TOP OF |
| (E) | EXISTING | MIN | MINIMUM | TB | TIE BEAM |
| E/A | EACH | MISC | MISCELLANEOUS | TOP | TOP AND BOTTOM |
| EF | EACH FACE | MO | MASONRY OPENING | THICK | THICK |
| EJ | EXPANSION JOINT | MTL | METAL | THRU | THROUGH |
| EL | ELEVATION | NO | NUMBER | TOC | TOP OF CONCRETE |
| ELEC | ELECTRICAL | NTS | NOT TO SCALE | TOS | TOP OF STEEL |
| EMBED | EMBEDMENT | OC | ON CENTER | TPY | TYPICAL |
| EOC | EDGE OF CONCRETE | OD | OUTSIDE DIAMETER | UNO | UNLESS NOTED |
| EQ | EQUAL | OH | OPPOSITE HAND | | OTHERWISE |
| EW | EACH WAY | OPNG | OPENING | VERT | VERTICAL |
| EXIST | EXISTING | PCS | PIECES | WWF | WELDED WIRE FABRIC |

ALUMINUM

MINIMUM REINFORCING						
THICKNESS	6"	8"	10"	12" - 16"	18" - 22"	24"
REINF. EACH WAY	#4 @ 12"	#5 @ 12"	#5 @ 12"	#5 @ 12"	#6 @ 12"	#7 @ 12"
LOCATION	CTR	CTR	EF	EF	EF	EF

- ## **ALUMINUM**
1. ALUMINUM DESIGN, DETAILING, FABRICATION, AND ERECTION SHALL CONFORM TO THE LATEST EDITION OF THE ALUMINUM DESIGN MANUAL.
 2. ALUMINUM IN CONTACT WITH OR EMBEDDED IN CONCRETE OR MASONRY SURFACES SHALL BE COATED WITH A HEAVY COATING OF ALKALI RESISTANCE BITUMINOUS PAINT.
 3. ALL BOLTS USED IN CONNECTIONS WITH ALUMINUM MEMBERS SHALL BE STAINLESS STEEL A316, UNLESS NOTED OTHERWISE.
 4. ALL WELDING OF ALUMINUM STRUCTURES SHALL CONFORM TO "STRUCTURAL WELDING CODE - ALUMINUM", AWS D1.2, LATEST EDITION.

STAINLESS STEEL

1. STAINLESS STEEL PLATES, SHEETS AND STRUCTURAL SHAPES SHALL BE IN ACCORDANCE TO ASTM A240.
2. STAINLESS STEEL MATERIALS SHALL BE AS FOLLOWS UNLESS NOTED OTHERWISE:
 - a. EXTERIOR AND SUBMERGED USE: TYPE 316
TYPE 316L (WHERE WELDED)
3. ALL WELDING OF STRUCTURAL STAINLESS STEEL SHALL CONFORM TO "STRUCTURAL WELDING CODE - STAINLESS STEEL", AWS D1.6, LATEST EDITION.
4. STAINLESS STEEL BOLTS, NUTS AND WASHERS SHALL BE TYPE 316 IN ACCORDANCE TO ASTM F593 UNLESS NOTED OTHERWISE.



STRUCTURAL STEEL

1. DESIGN, FABRICATION, ERECTION MATERIALS AND WORKMANSHIP SHALL BE IN ACCORDANCE WITH THE LATEST AISC SPECIFICATIONS AND THE DESIGN DRAWINGS.
2. STEEL MATERIAL:
 - a. W-SHAPED SECTIONS : ASTM A992, GRADE 50
 - b. HOLLOW STRUCTURAL SECTIONS: ASTM A500, GRADE B
 - c. ALL OTHER STRUCTURAL STEEL: ASTM A36
 - d. ALL PIPE: ASTM A53, GRADE B
3. WELDED CONNECTIONS SHALL BE IN ACCORDANCE WITH THE LATEST AWS STRUCTURAL WELDING CODE REQUIREMENTS. ELECTRODES SHALL BE E-70XX.
4. BOLTED CONNECTIONS:
 - a. MAIN CONNECTIONS: 3/4" DIA, ASTM A325 BOLTS. HOLES: 13/16" DIA CONNECTION SHALL BE "BEARING" TYPE WITH THREADS EXCLUDED FROM THE SHEAR PLANE.
 - b. ALL CONNECTION SHALL HAVE A MINIMUM OF TWO BOLTS. GUSSET PLATES SHALL BE A MINIMUM OF 3/8" THICK.

STRUCTURAL LEGEND APPLIES TO "S" SHEETS ONLY



SYMBOLS APPLY TO "S" SHEETS ONLY

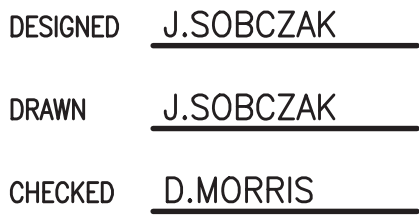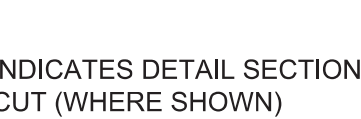

GENERAL STRUCTURAL NOTES, ABBREVIATIONS & SYMBOLS

APPROVED BY

JOHN V. SOBCZAK
P.E. #71407

PROJECT NO:

19850-041-01


INDEX NO:

DATE:


AUG. 2019

DWG NO:

S1

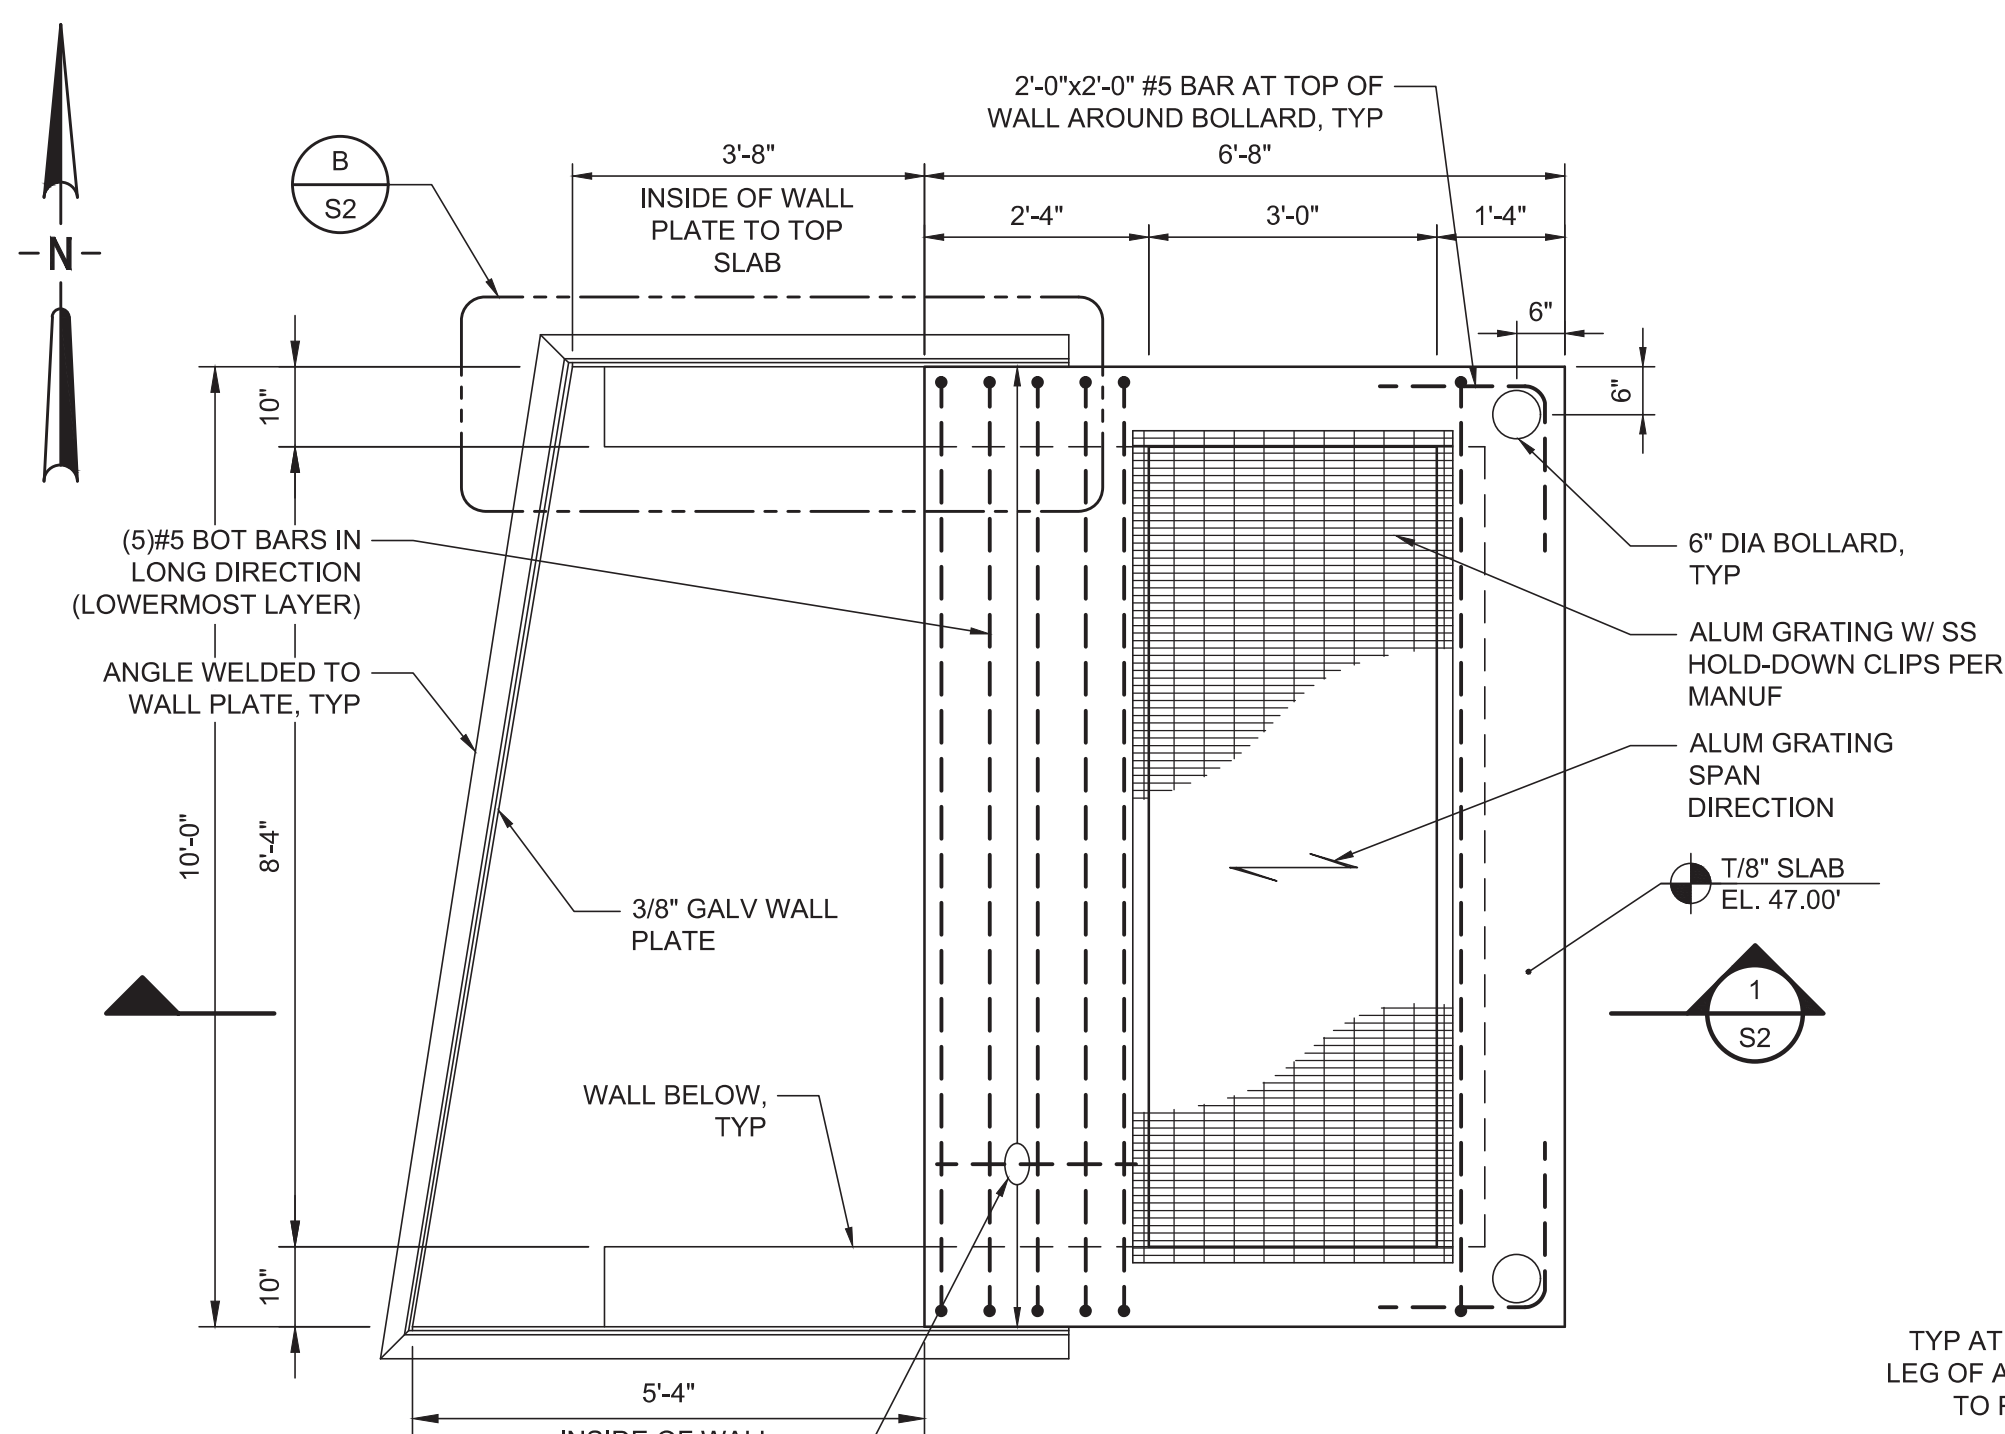


TOP OF STRUCTURE
PLAN
1/2"=1'-0"

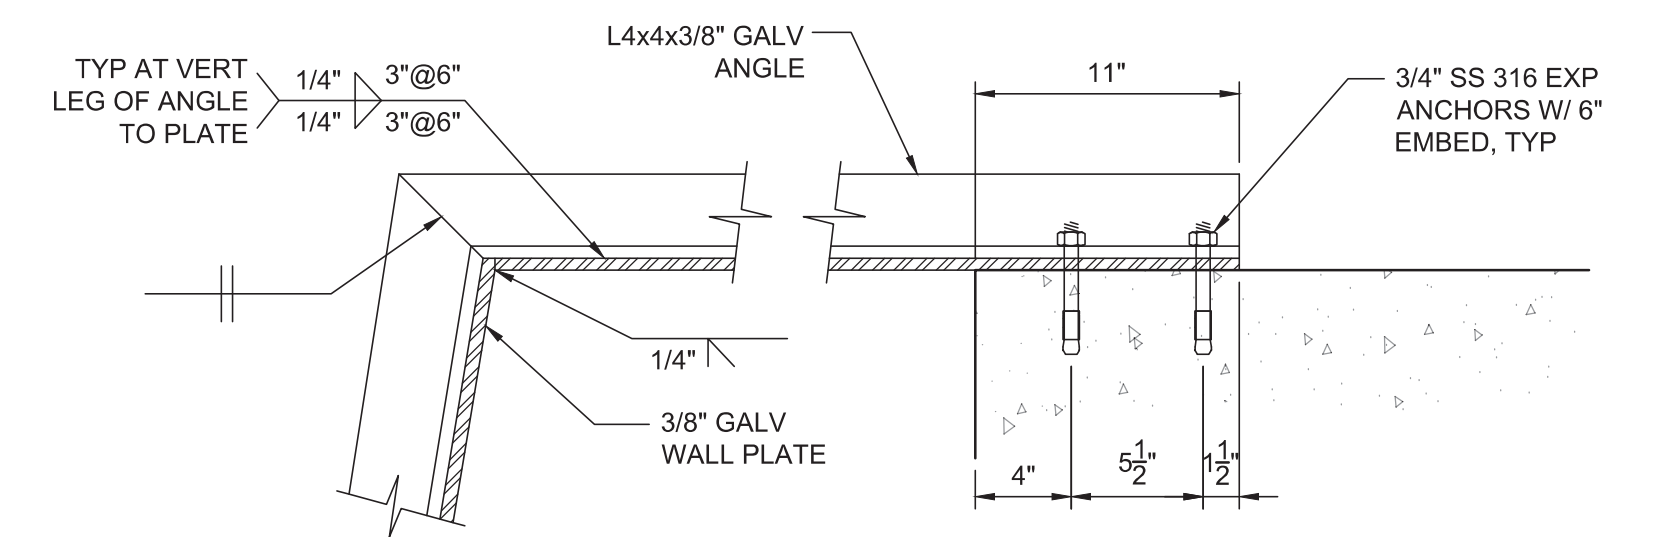

BAR RACK SHROUD


DETAIL

1-1/2"=1'-0"

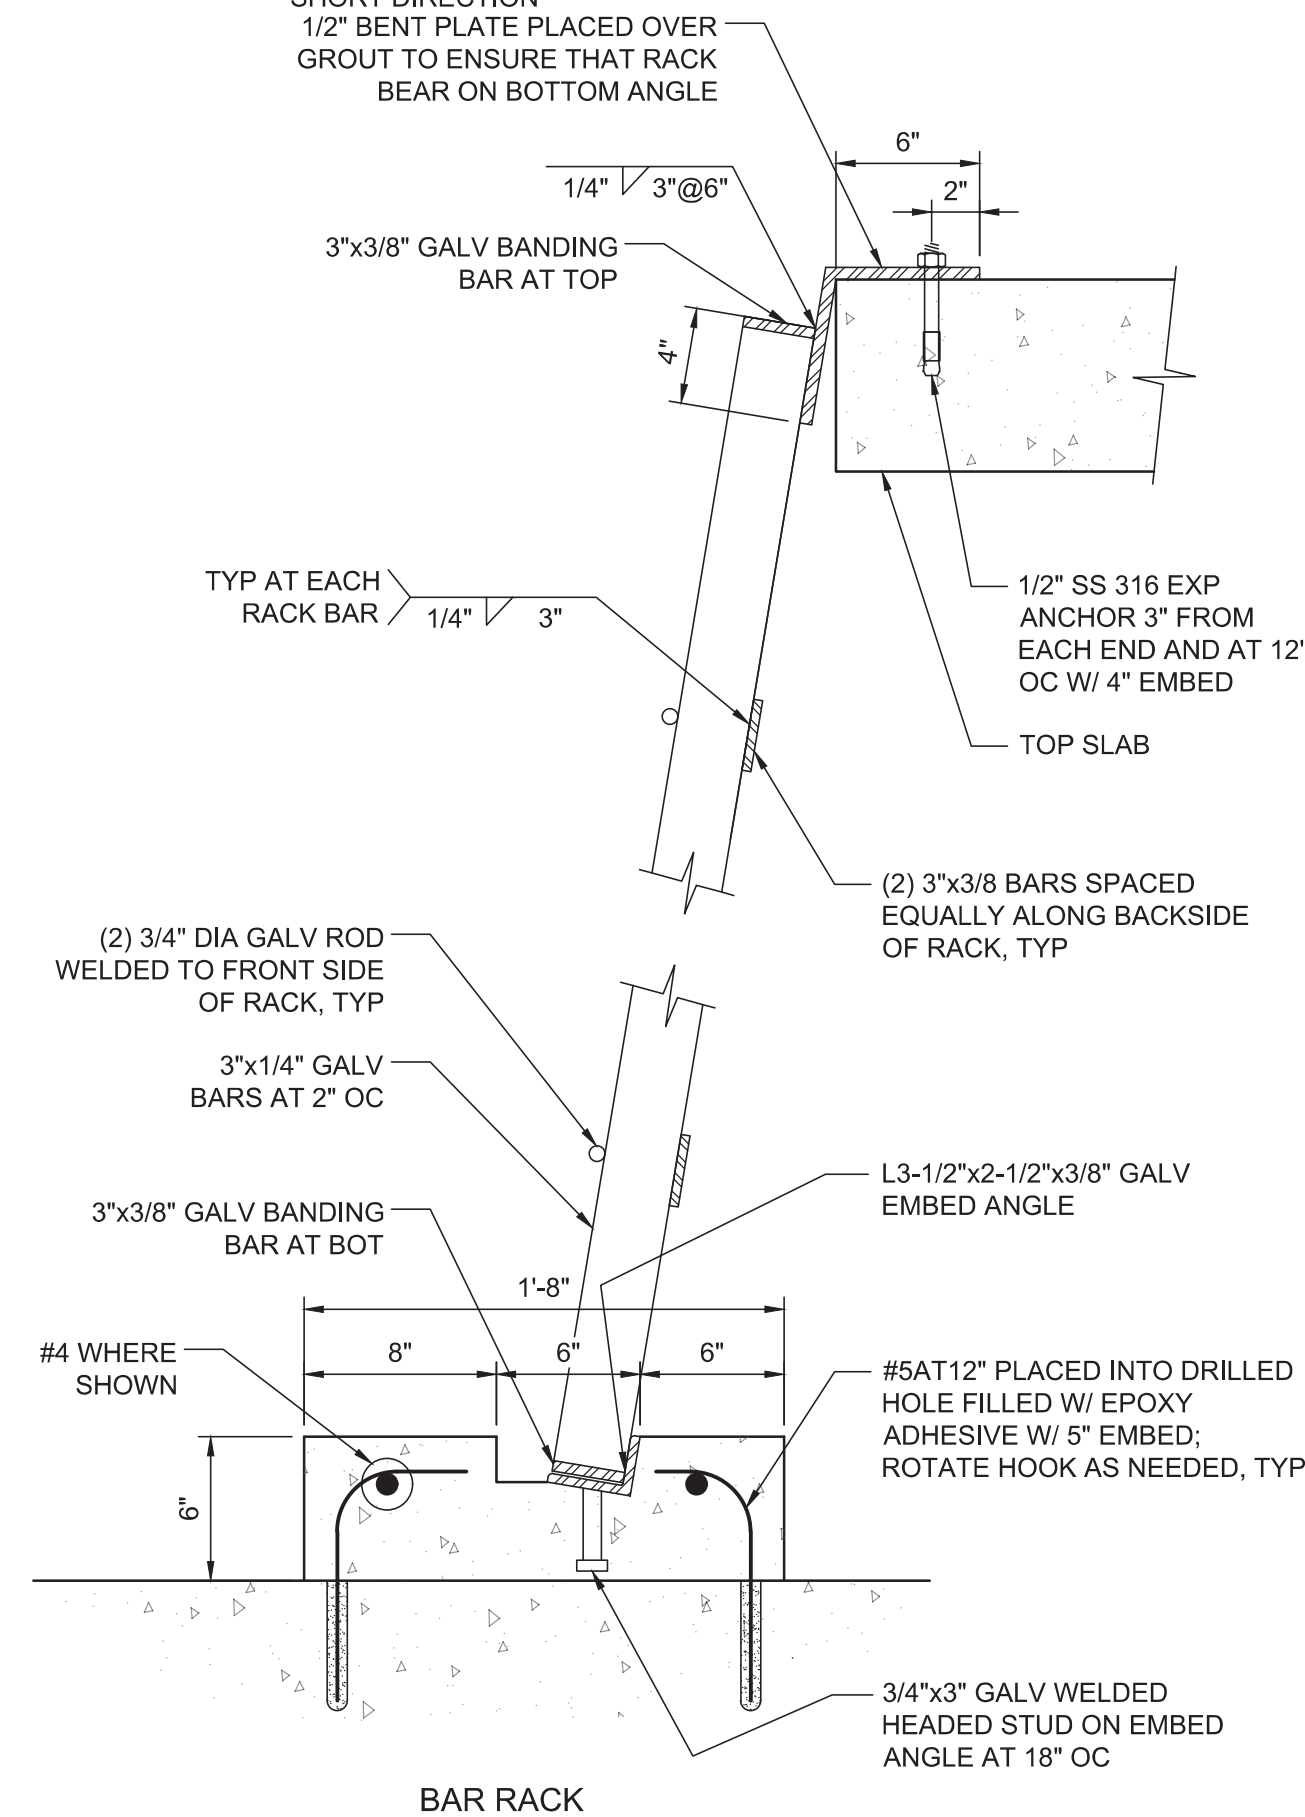

SECTION
1/2"=1'-0"

DETAIL
1-1/2"=1'-0"

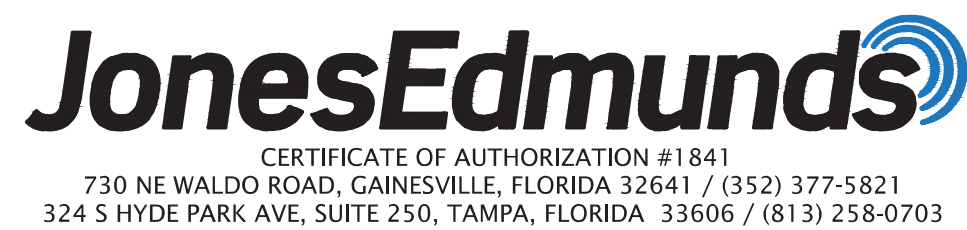


GRAVITY INTAKE STRUCTURE PLANS, SECTION AND DETAILS

APPROVED BY






JOHN V. SOBCZAK
P.E. #71407

PROJECT NO:	DATE:	A
19850-041-01	AUG. 2019	

INDEX NO:	DWG NO:
	S2

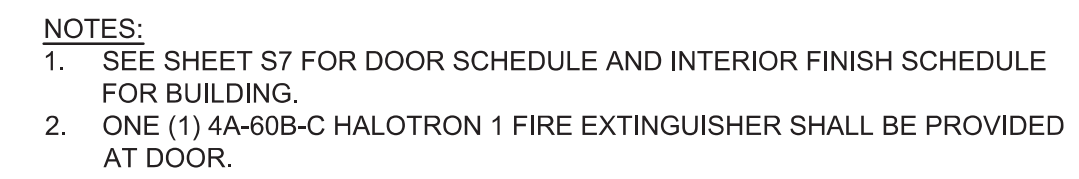

SAVED: 8/28/2019 10:39 AM JOHN P:\JONES EDMUNDS\18-135 FLATFORD SWAMP PUMP STATION\DRAWINGS\STRUCTURAL\S3.DWG

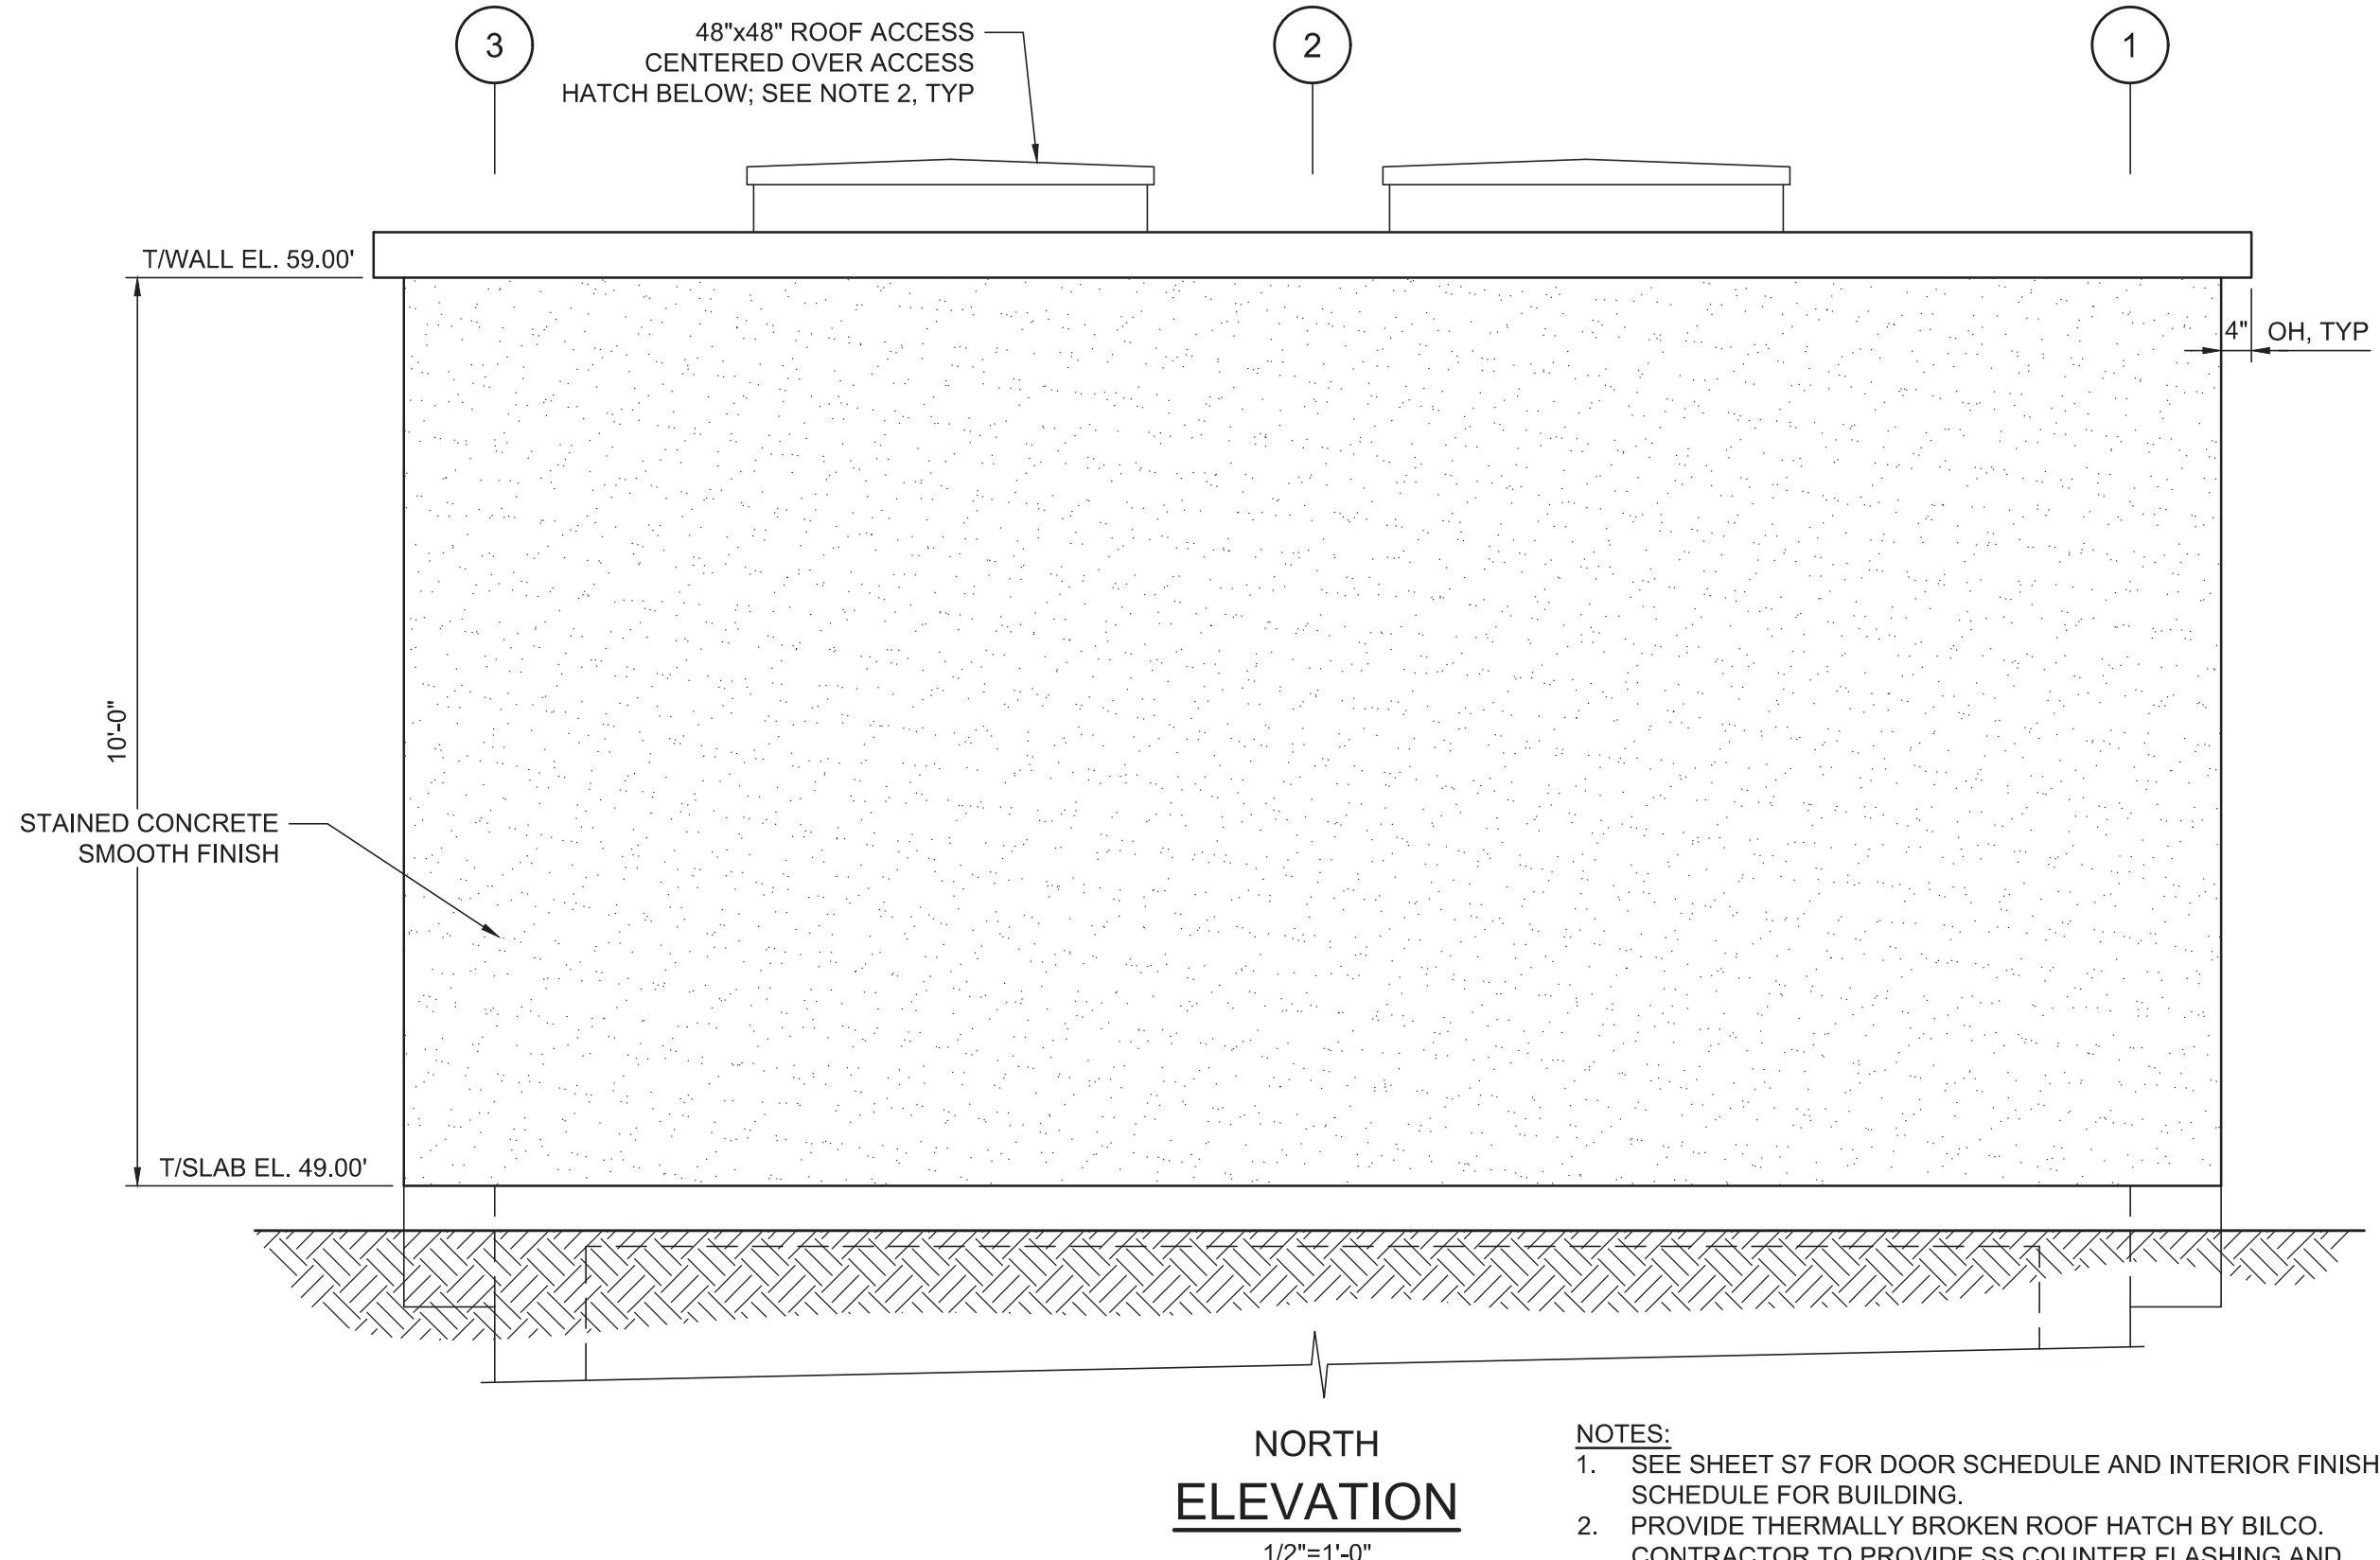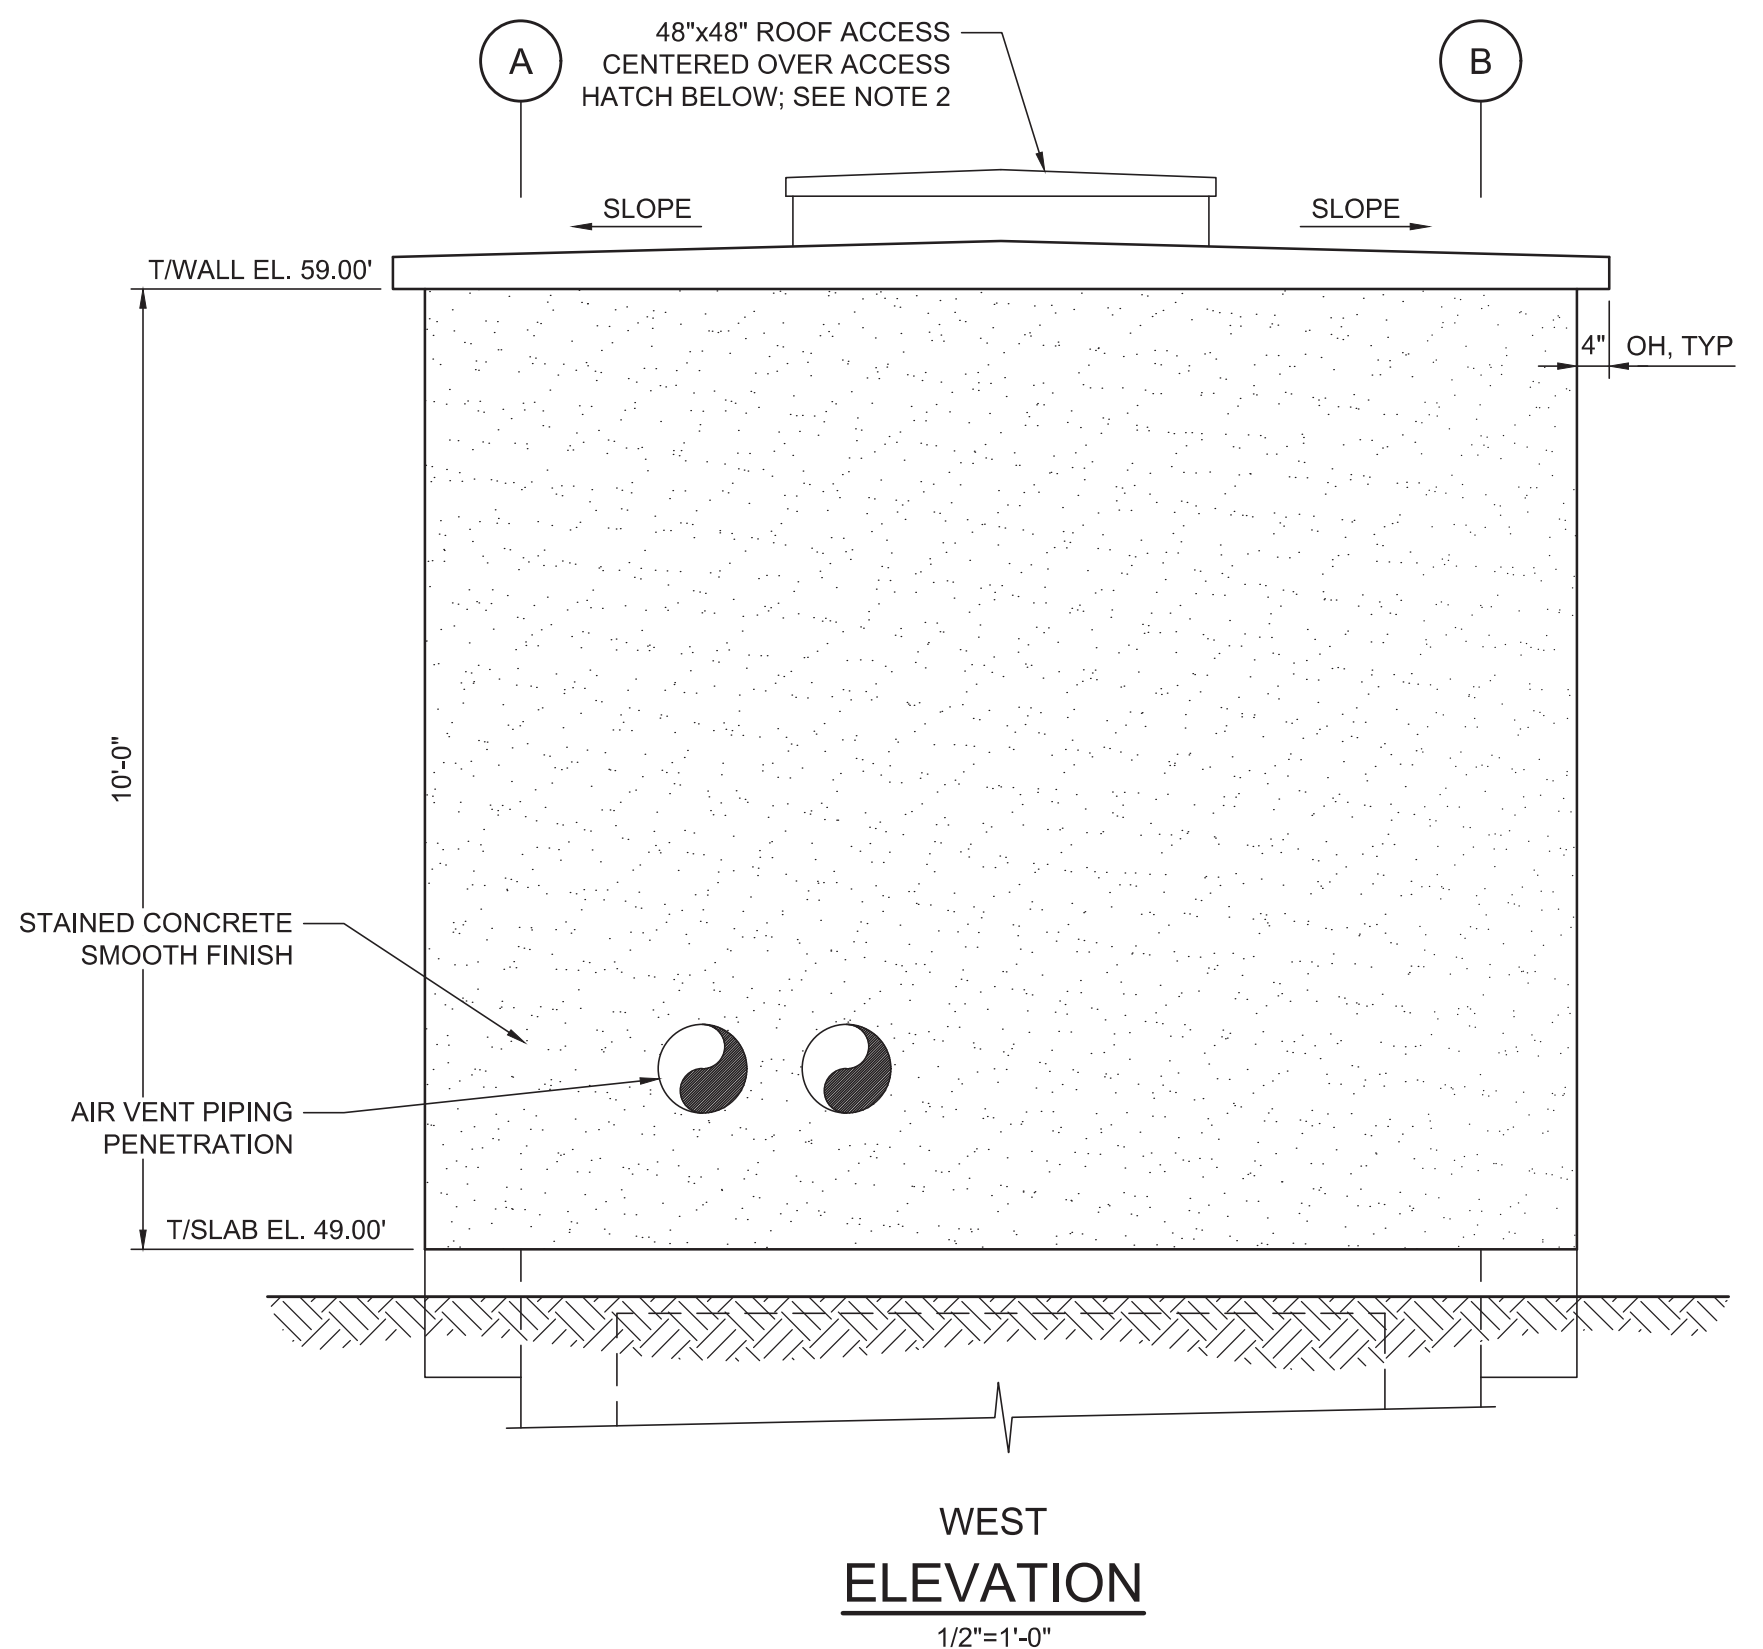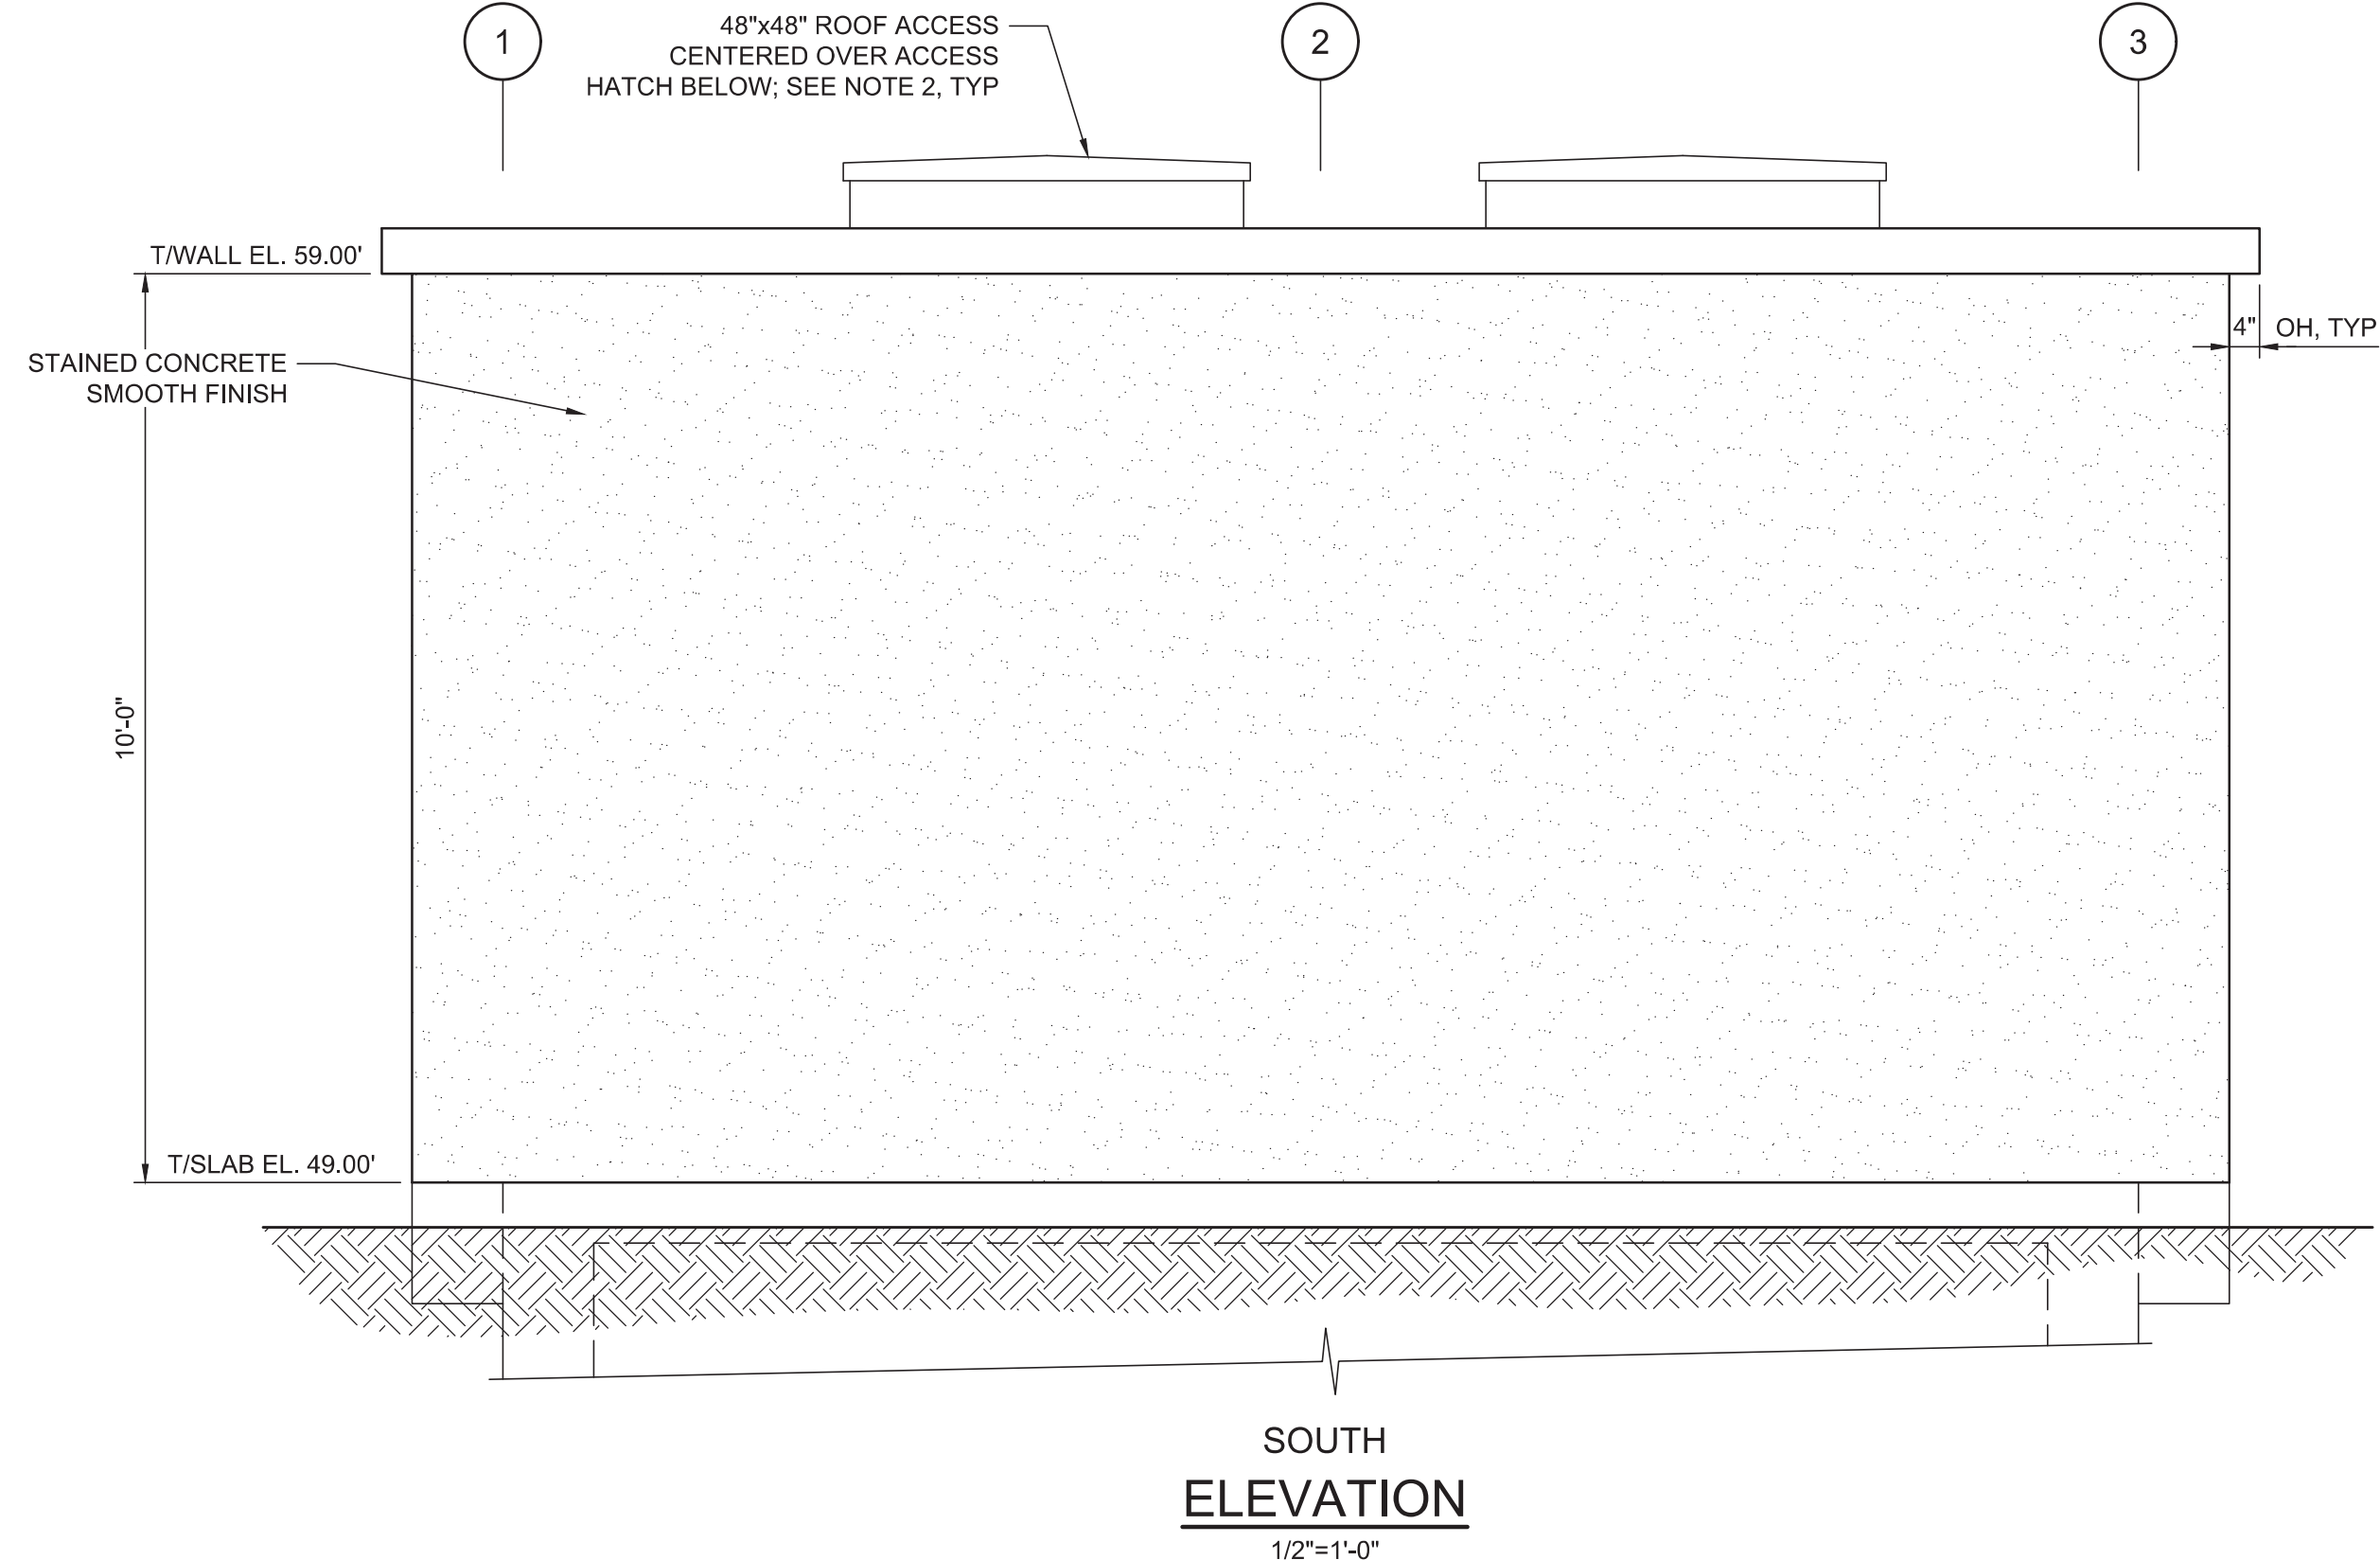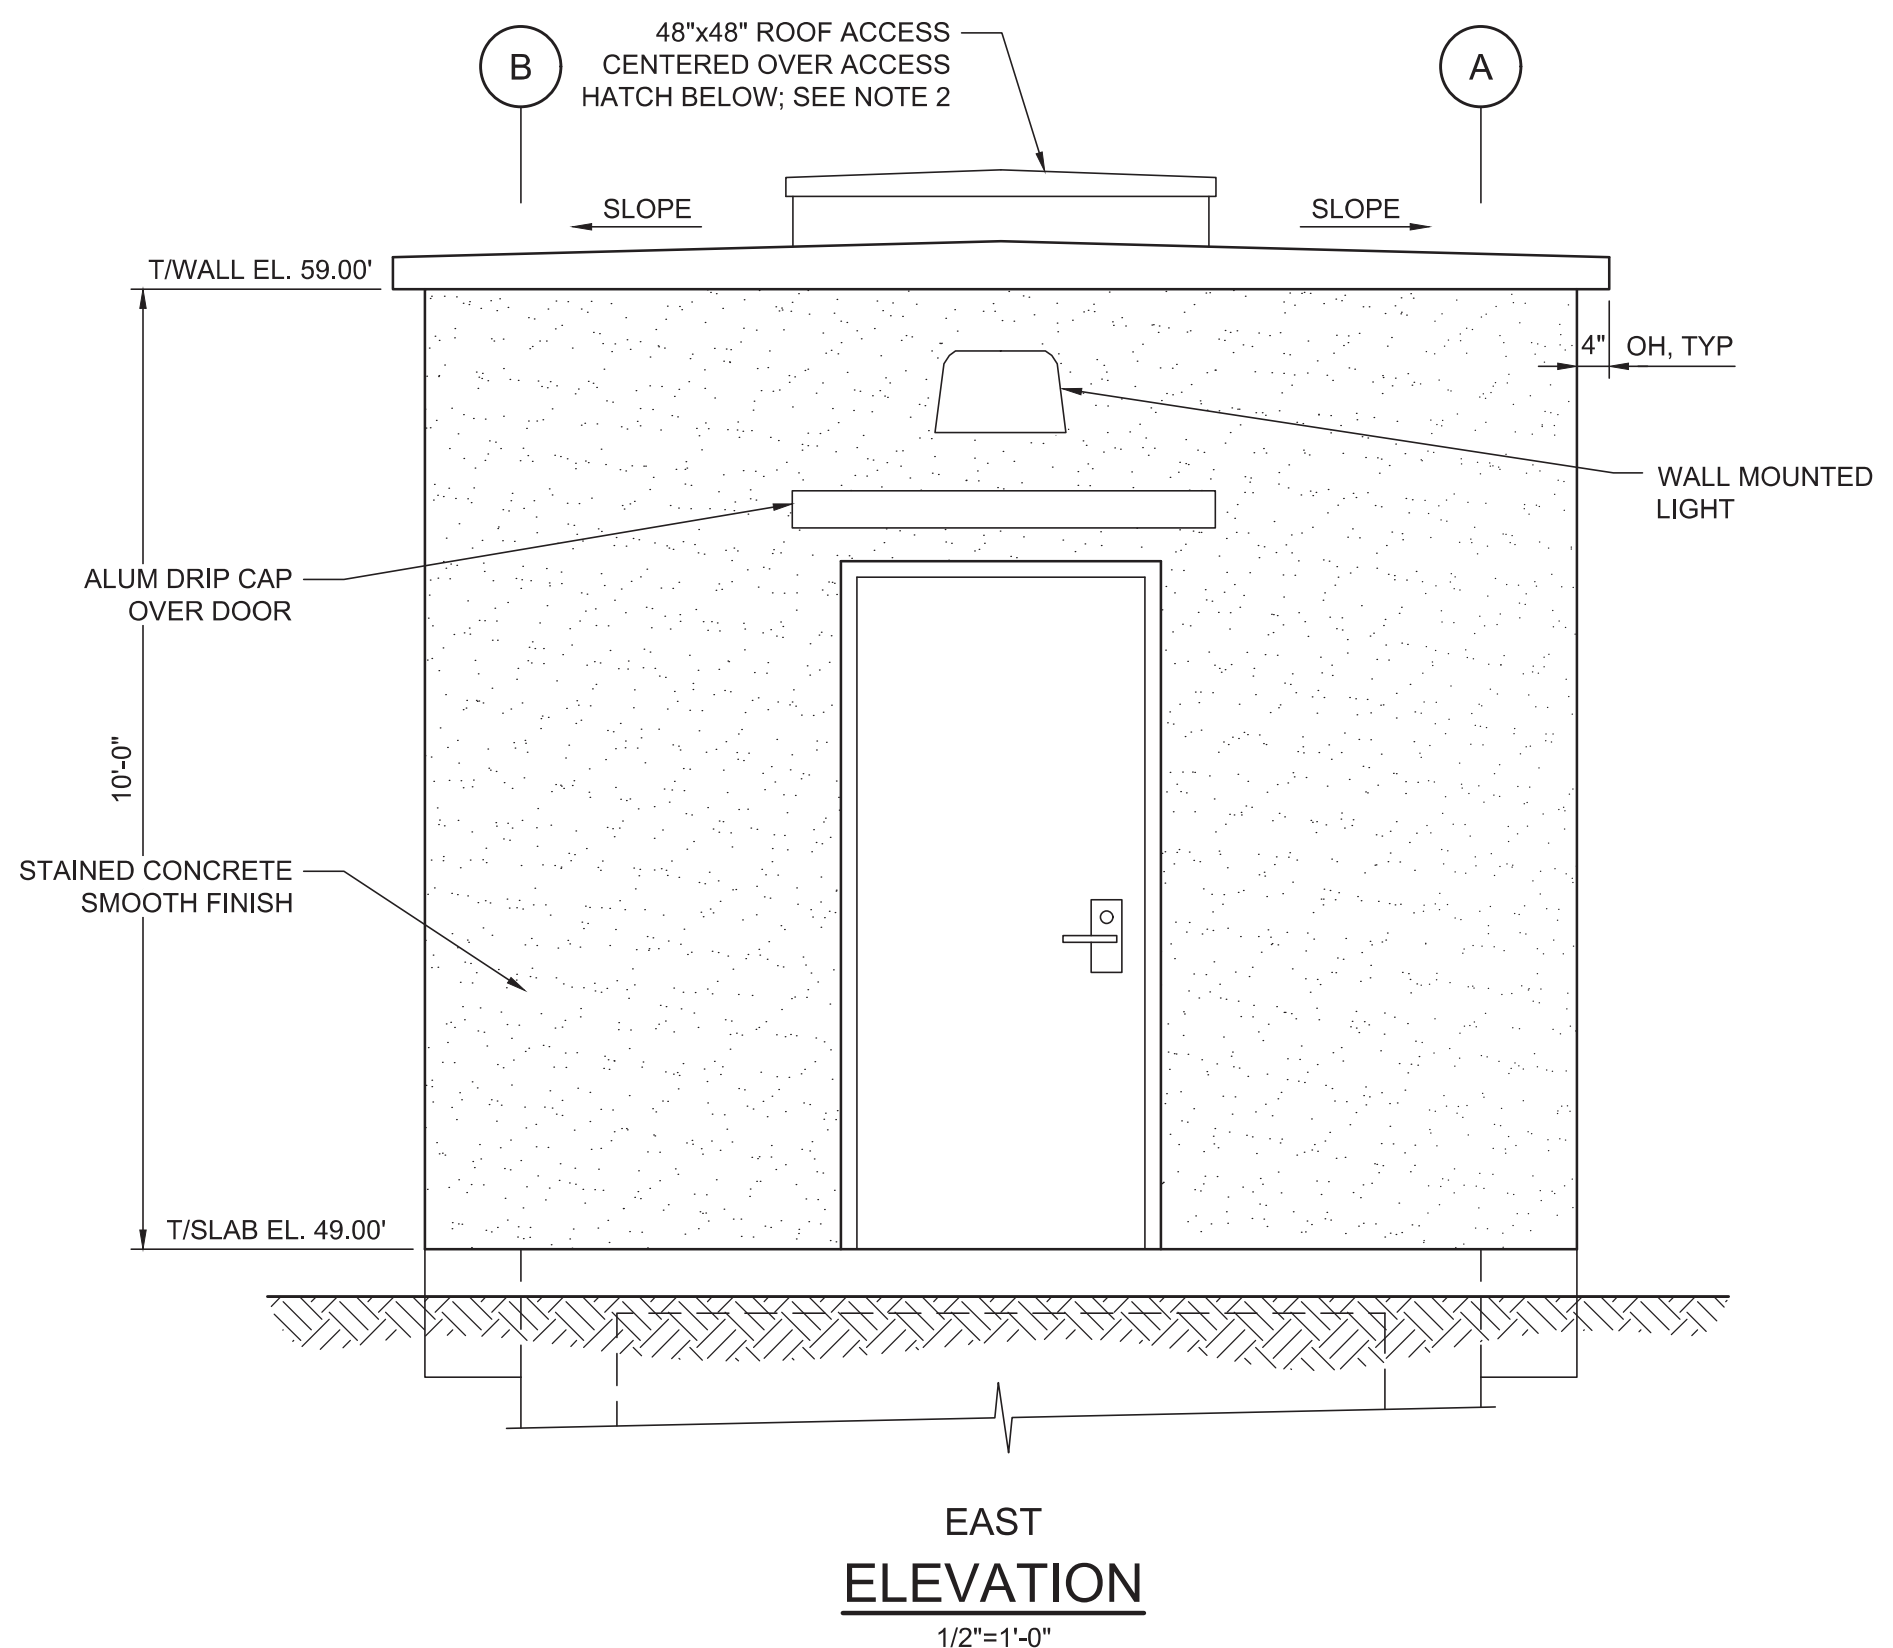
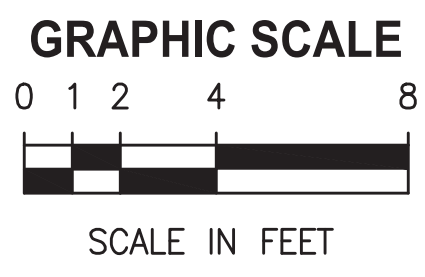


- NOTES:
- SEE SHEET S7 FOR DOOR SCHEDULE AND INTERIOR FINISH SCHEDULE FOR BUILDING.
 - PROVIDE THERMALLY BROKEN ROOF HATCH BY BILCO. CONTRACTOR TO PROVIDE SS COUNTER FLASHING AND SEALANT TO ENSURE THE INSTALLATION TO THE PRECAST STRUCTURE IS WATER-TIGHT.



					DESIGNED J.SOBCZAK	 CERTIFICATE OF AUTHORIZATION #1841 730 NE WALDO ROAD, GAINESVILLE, FLORIDA 32641 / (352) 377-5821 324 S HYDE PARK AVE, SUITE 250, TAMPA, FLORIDA 33606 / (813) 258-0703	AQUIFER RECHARGE AT FLATFORD SWAMP SOUTHWEST FLORIDA WATER MANAGEMENT DISTRICT	RECHARGE PUMP STATION BUILDING ELEVATIONS	APPROVED BY JOHN V. SOBCZAK P.E. #71407	PROJECT NO: 19850-041-01	DATE: AUG. 2019
					DRAWN J.SOBCZAK					INDEX NO:	DWG NO:
					CHECKED D.MORRIS						
LTR.	DATE	REVISIONS	BY	APPRD.							S4

BID SET

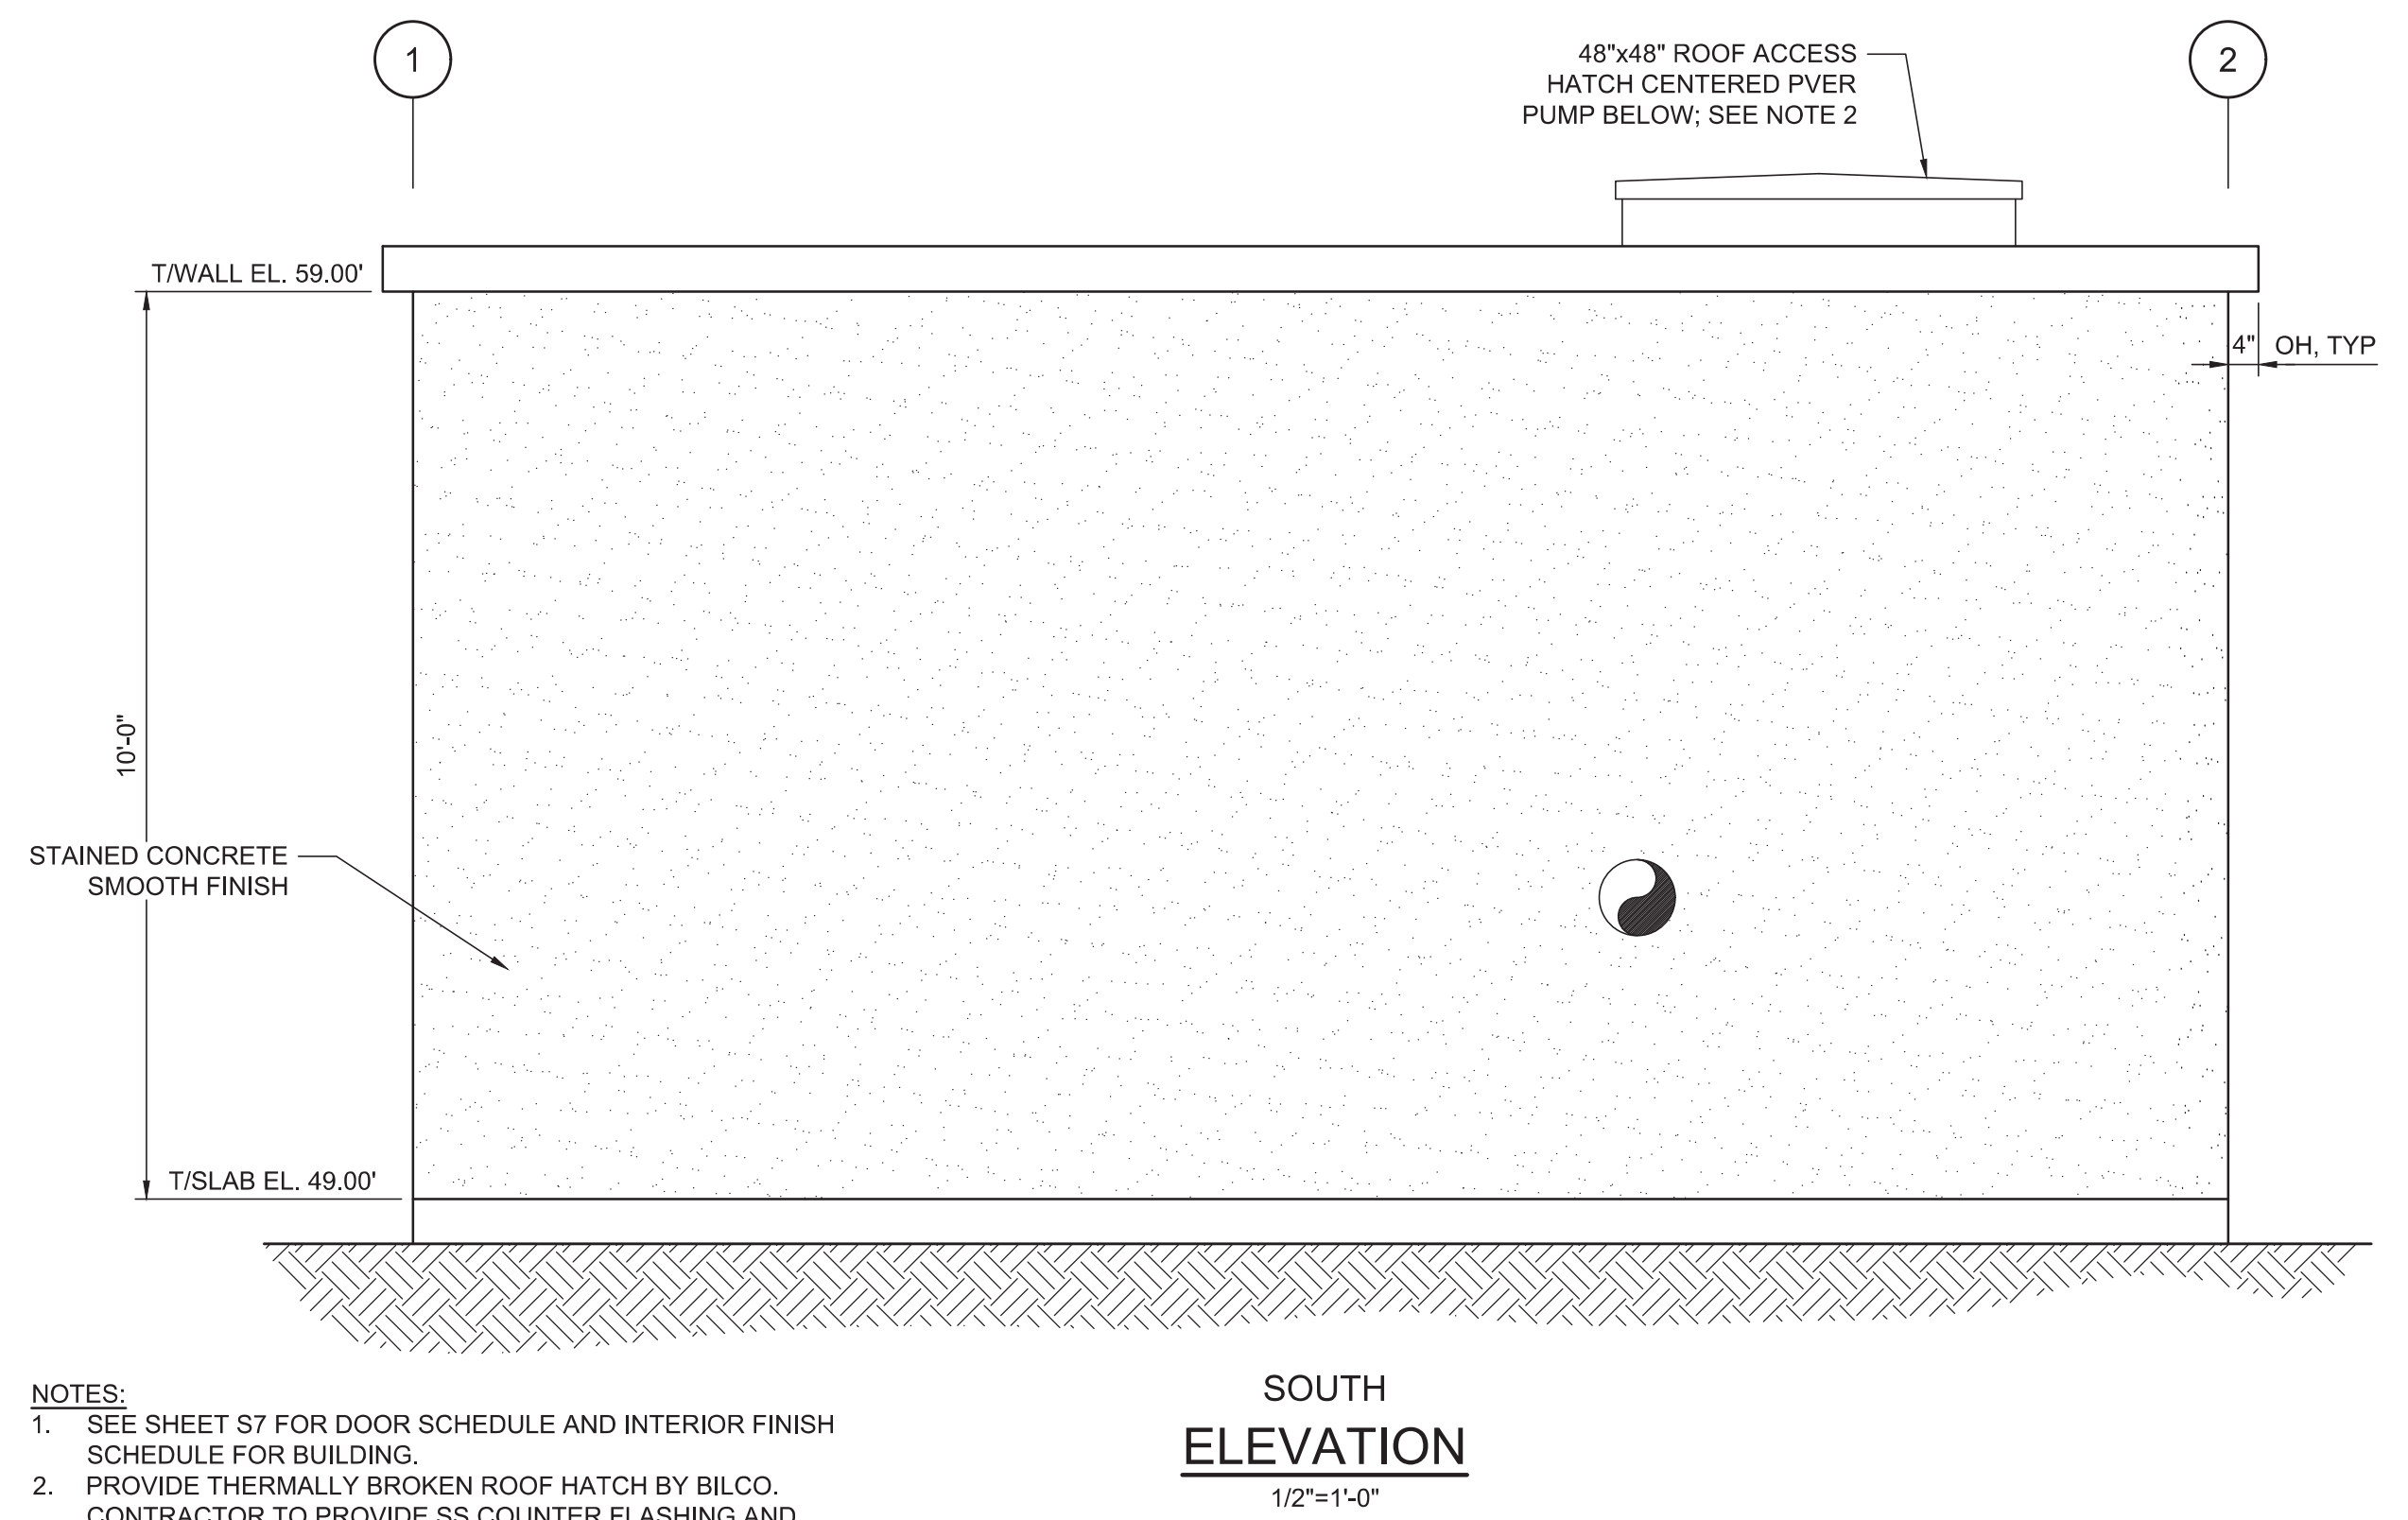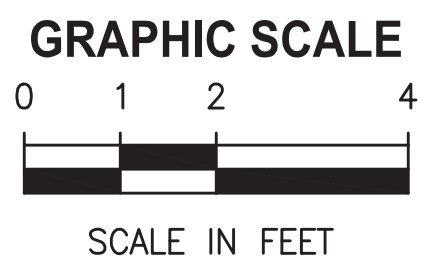


- NOTES:**
1. SEE SHEET S7 FOR DOOR SCHEDULE AND INTERIOR FINISH SCHEDULE FOR BUILDING.
 2. PROVIDE THERMALLY BROKEN ROOF HATCH BY BILCO. CONTRACTOR TO PROVIDE SS COUNTER FLASHING AND SEALANT TO ENSURE THE INSTALLATION TO THE PRECAST STRUCTURE IS WATER-TIGHT.

APPROVED BY	PROJECT NO: 19850-041-01	DATE: AUG. 2019
JOHN V. SOBCZAK	INDEX NO:	DWG NO:
P.E. #71407		S5




SAVED: 8/28/2019 10:44 AM JOHN P:\JONES EDMUNDS\18-135 FLATFORD SWAMP PUMP STATION\DRAWINGS\STRUCTURAL\S6.DWG

N

GRAPHIC SCALE
0 1 2 4
SCALE IN FEET

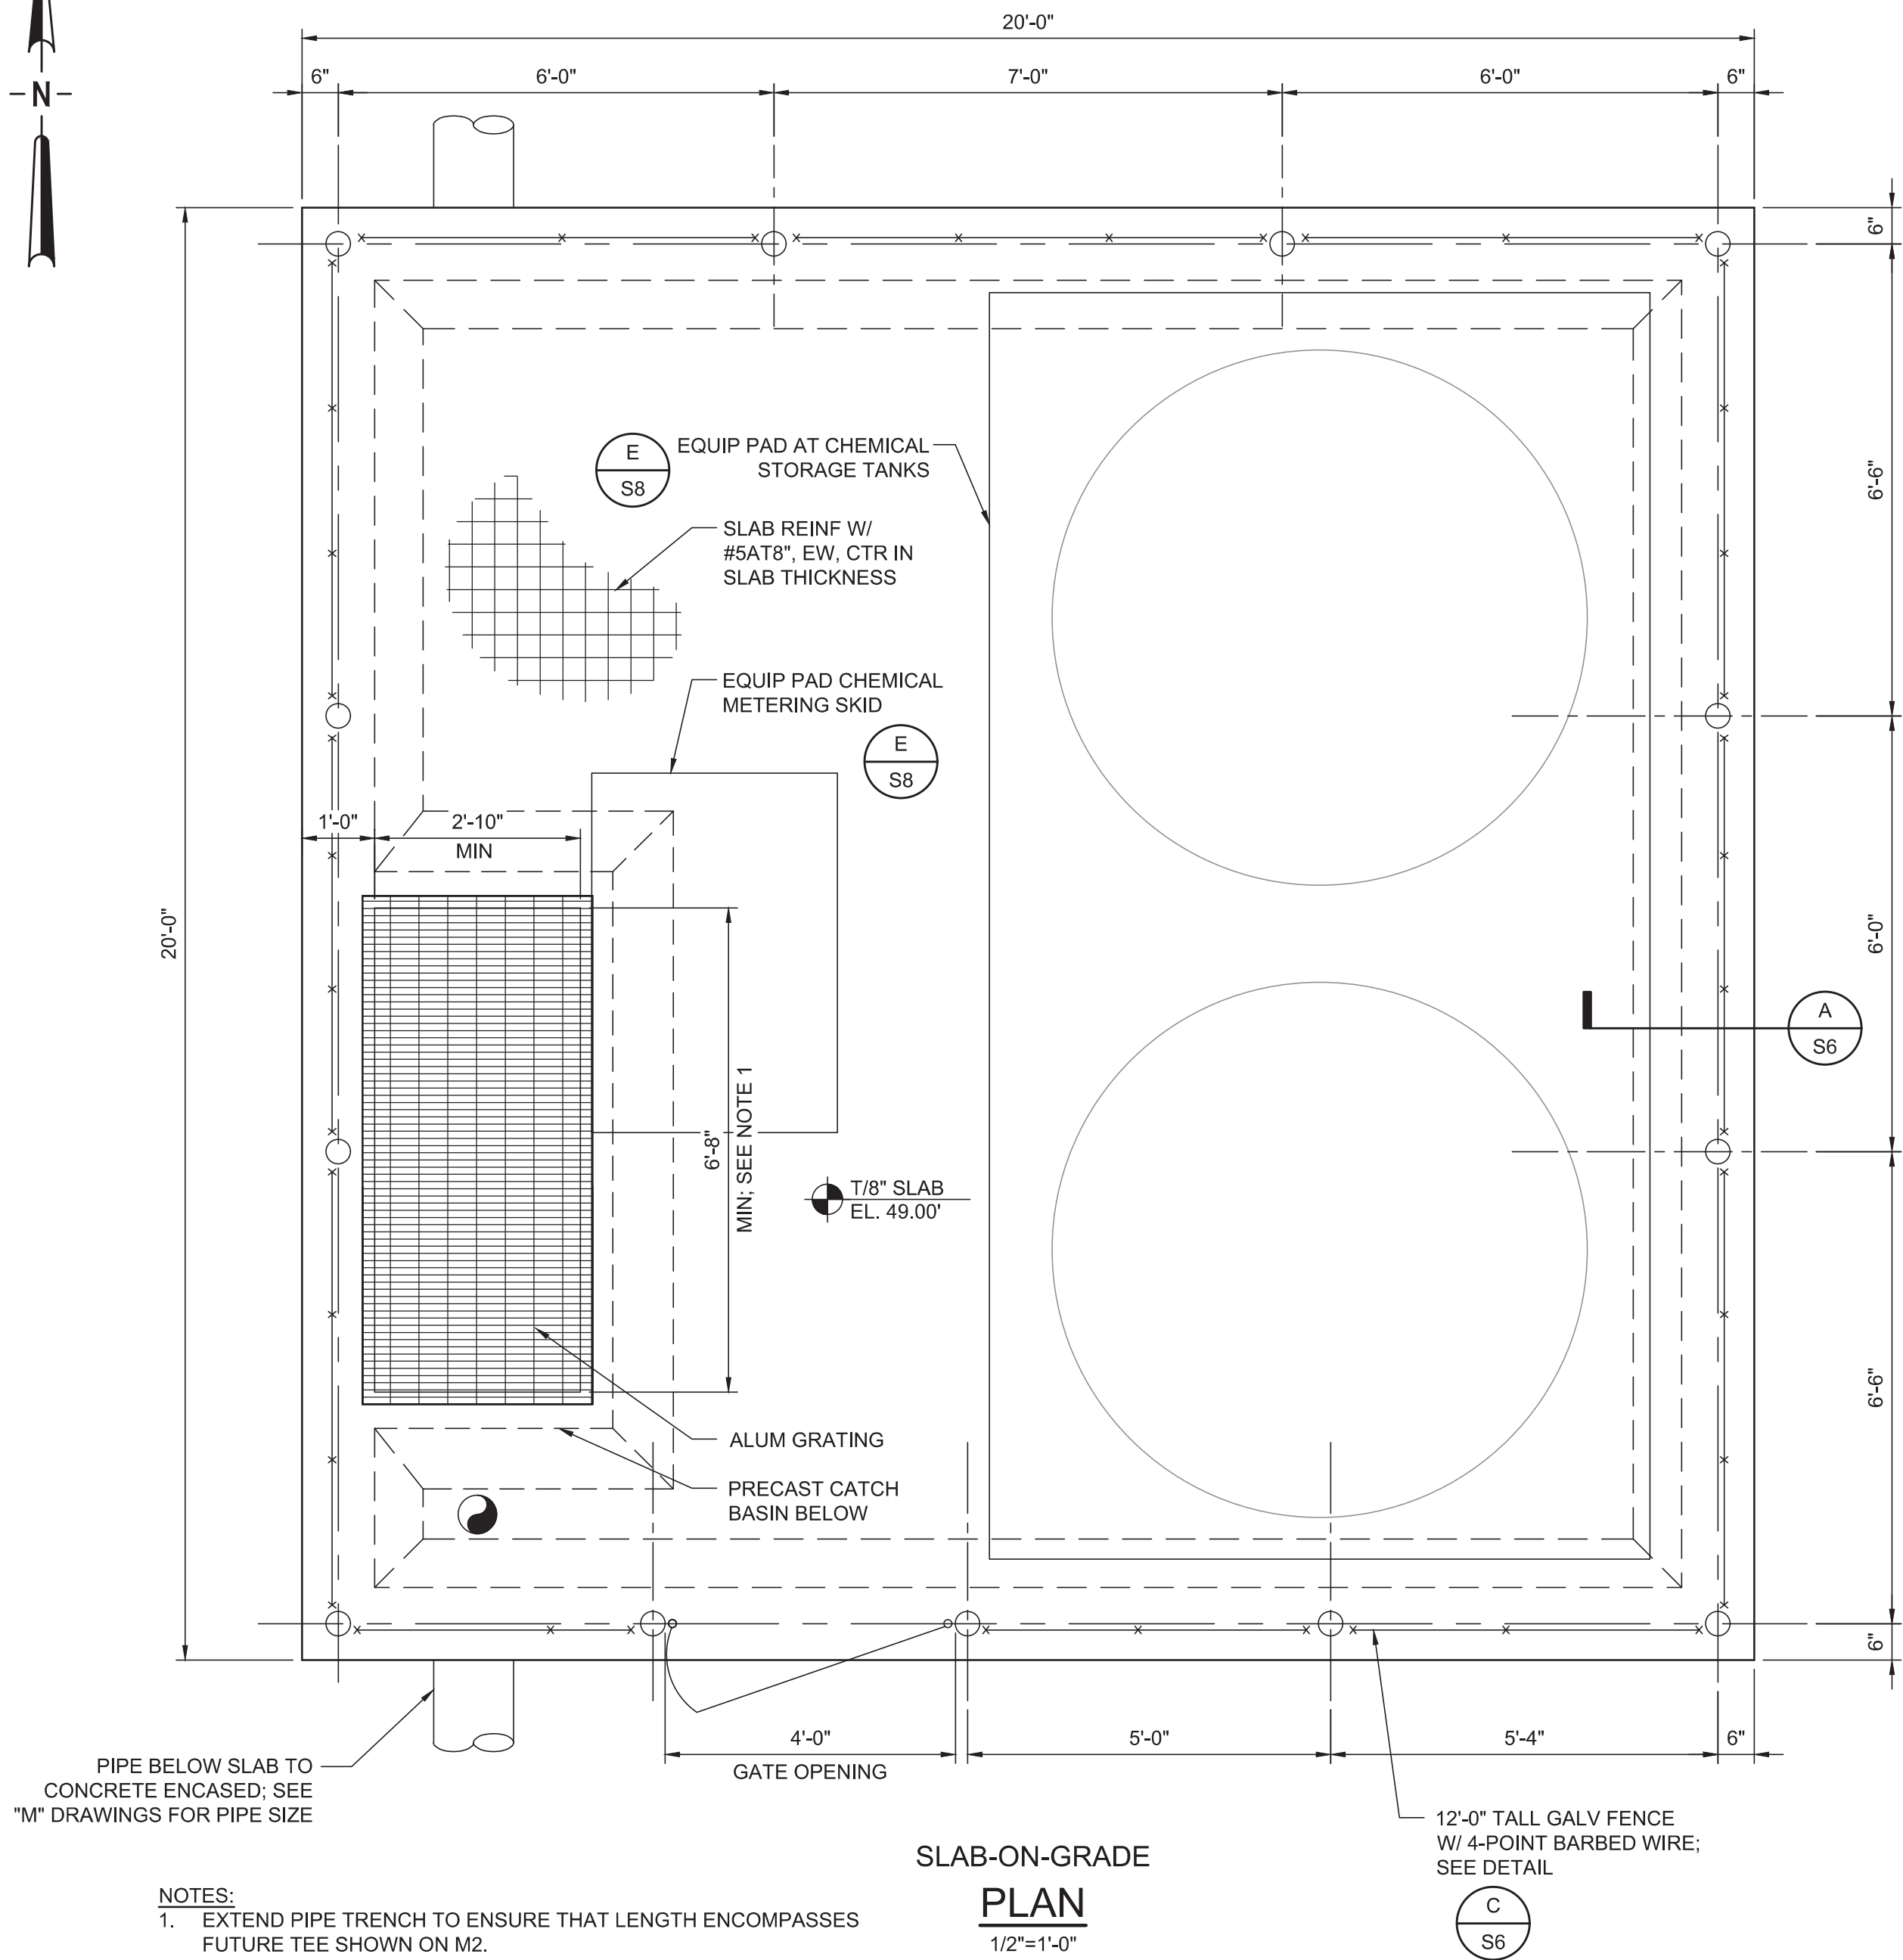

- NOTES:
1. EXTEND PIPE TRENCH TO ENSURE THAT LENGTH ENCOMPASSES FUTURE TEE SHOWN ON M2.
 2. TANK MANUFACTURER SHALL PROVIDE TANK ANCHORS AND ANCHOR LUGS OR STRAPS FOR UPLIFT. ALL ANCHORS AND HARDWARE SHALL BE SS 316. POST-INSTALLED ANCHORS SHALL BE EMBEDDED A MINIMUM OF 10".

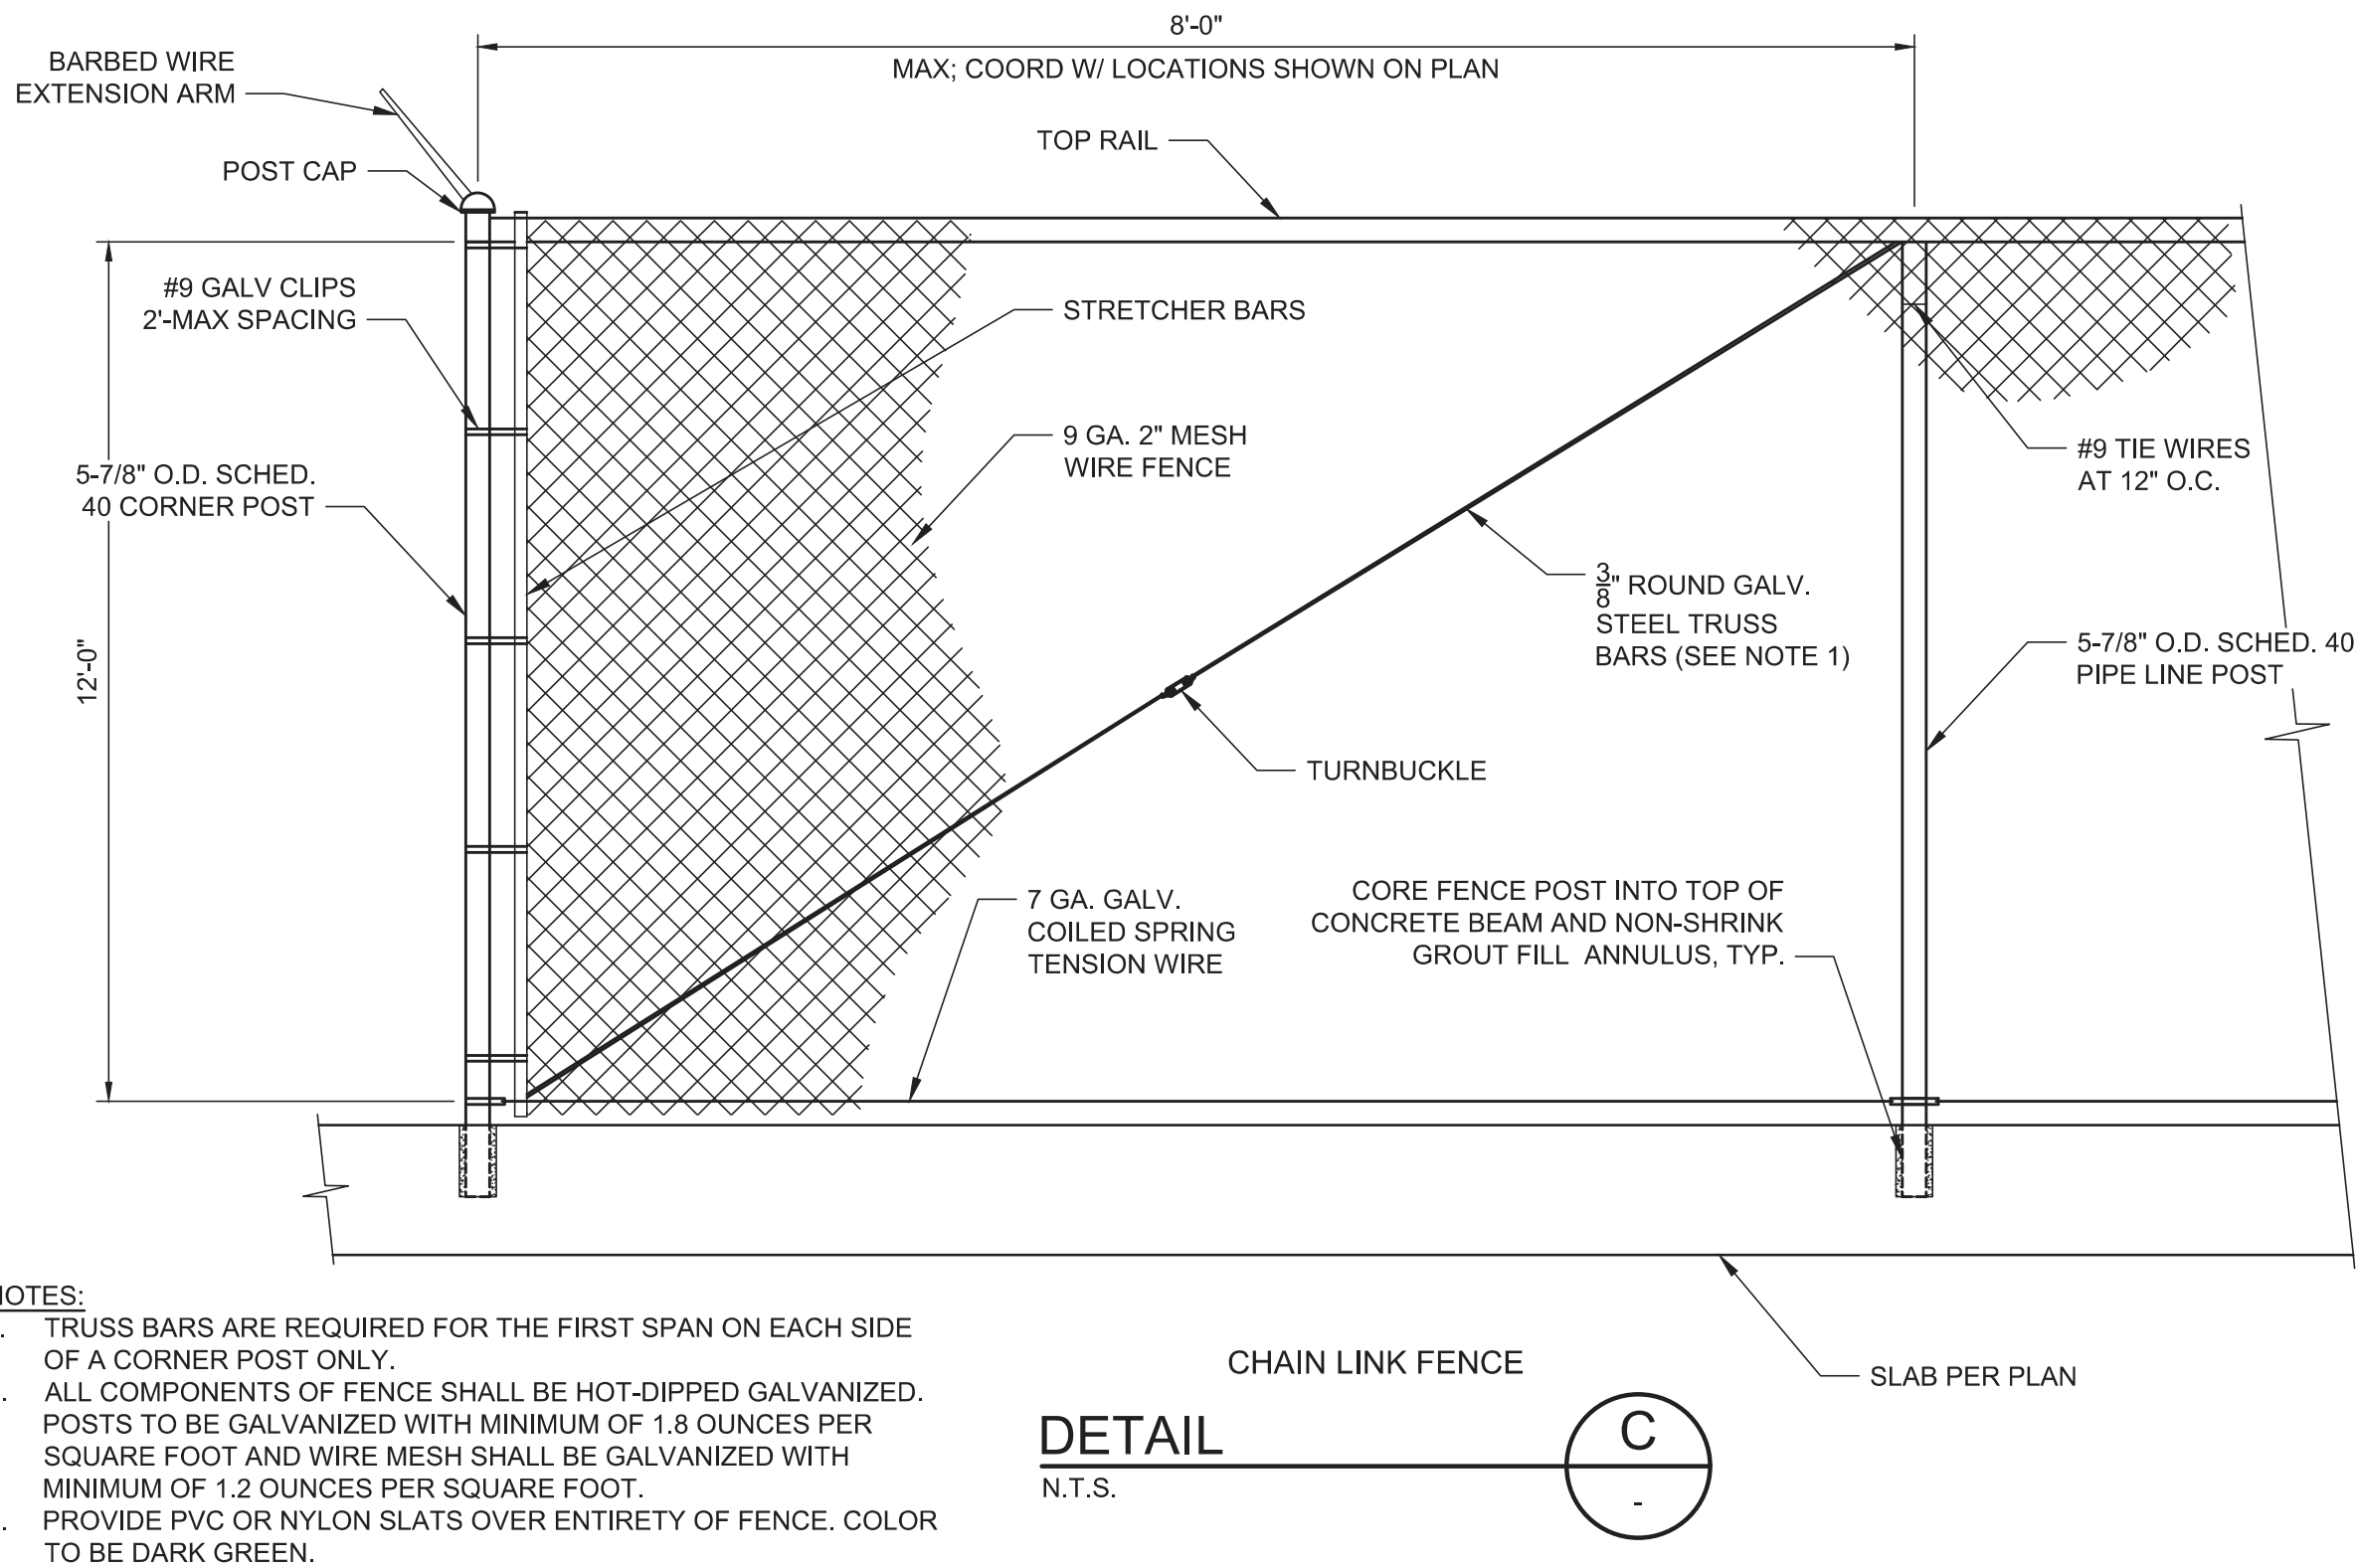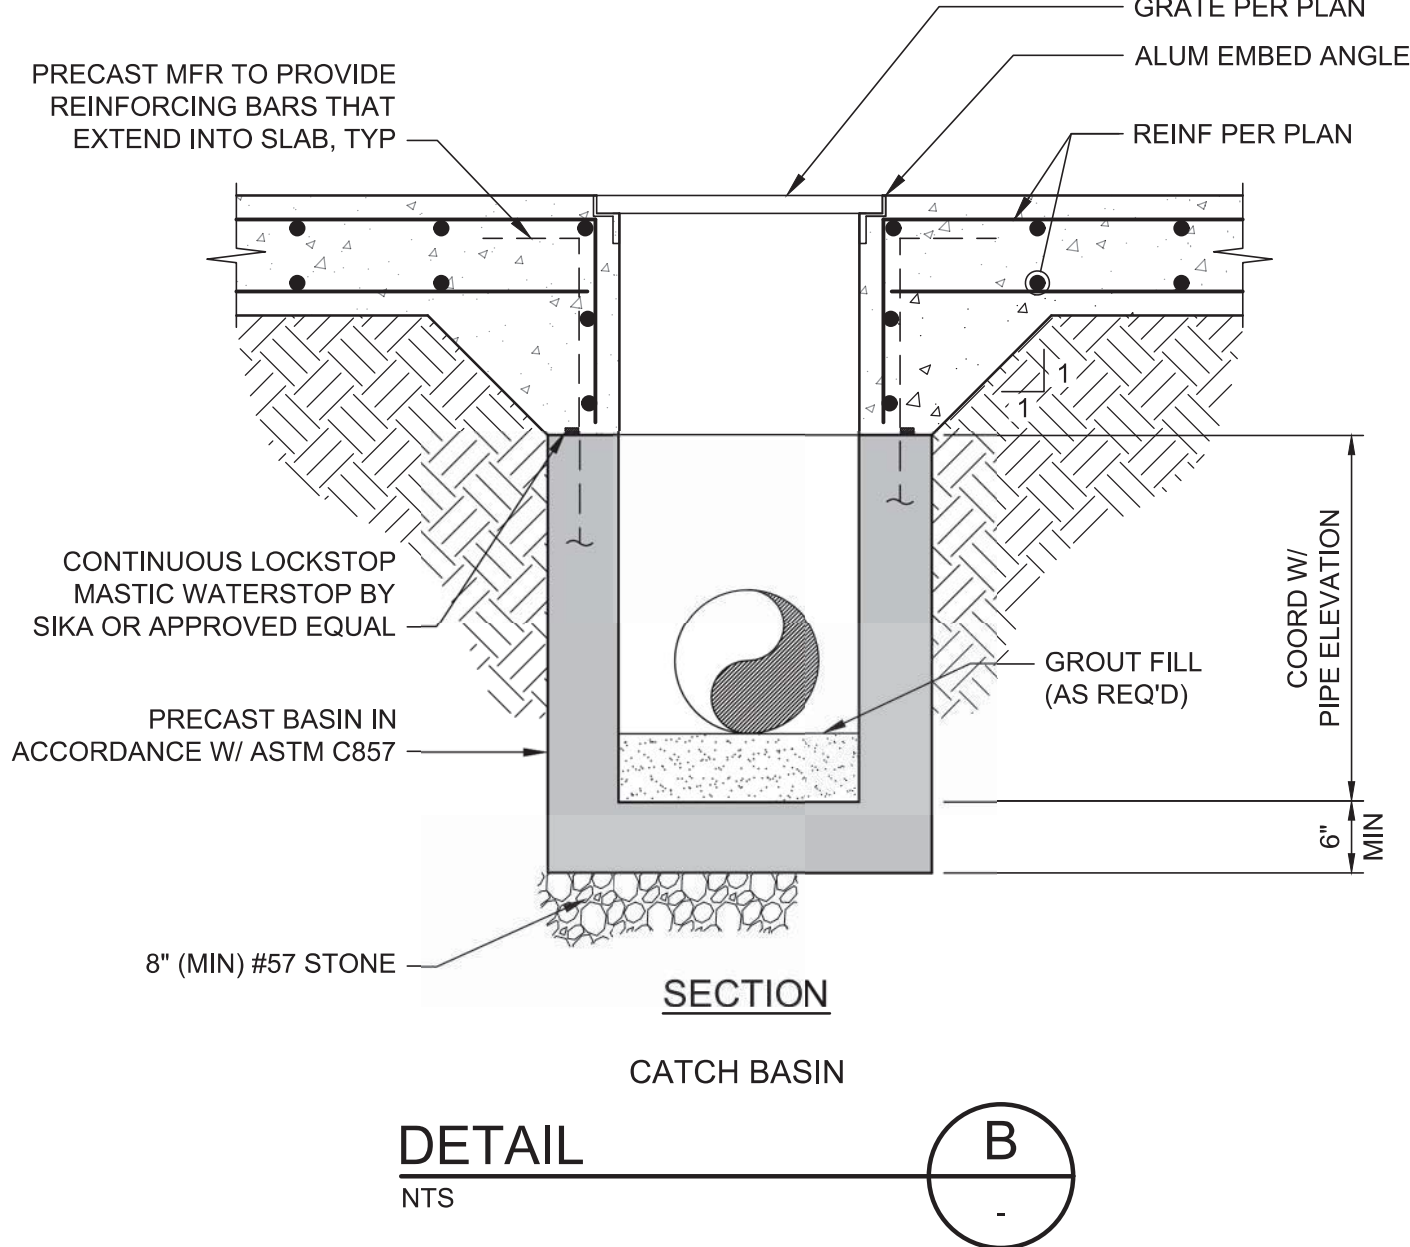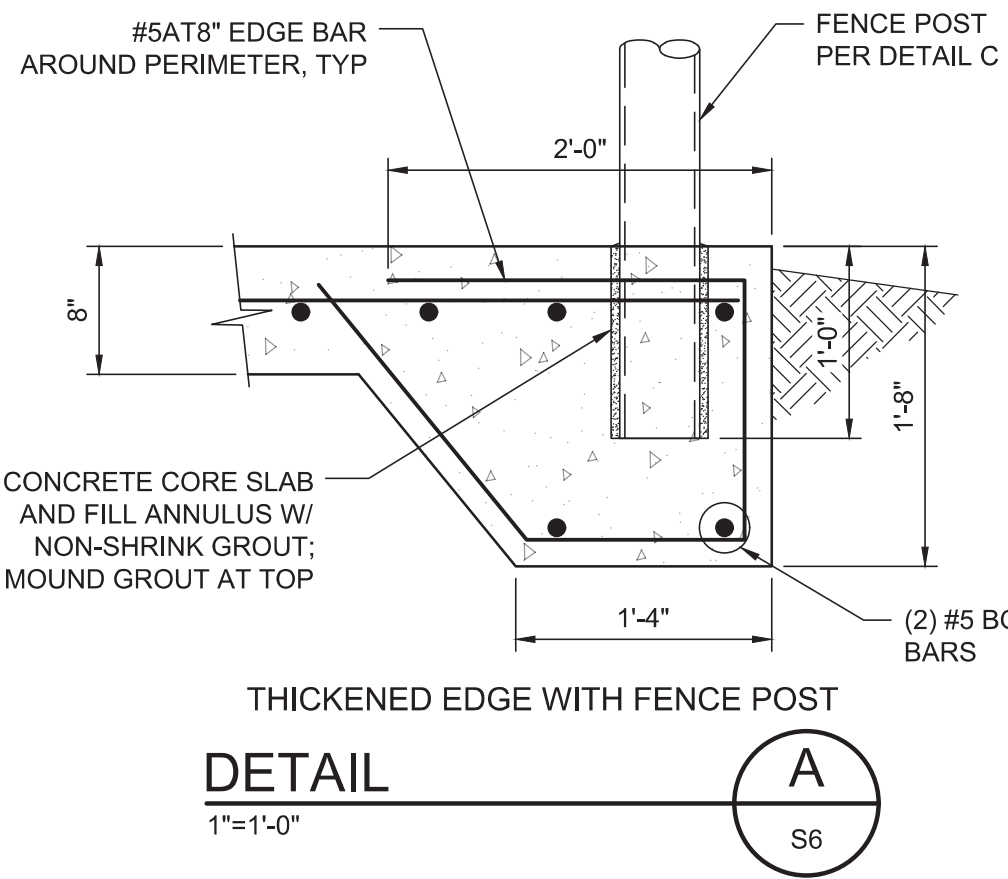

- NOTES:
1. TRUSS BARS ARE REQUIRED FOR THE FIRST SPAN ON EACH SIDE OF A CORNER POST ONLY.
 2. ALL COMPONENTS OF FENCE SHALL BE HOT-DIPPED GALVANIZED. POSTS TO BE GALVANIZED WITH MINIMUM OF 1.8 OUNCES PER SQUARE FOOT AND WIRE MESH SHALL BE GALVANIZED WITH MINIMUM OF 1.2 OUNCES PER SQUARE FOOT.
 3. PROVIDE PVC OR NYLON SLATS OVER ENTIRETY OF FENCE. COLOR TO BE DARK GREEN.



						DESIGNED	J.SOBCZAK
						DRAWN	J.SOBCZAK
						CHECKED	D.MORRIS
LTR.	DATE	REVISIONS			BY	APPRD.	

JonesEdmunds
CERTIFICATE OF AUTHORIZATION #1841
730 NE WALDO ROAD, GAINESVILLE, FLORIDA 32641 / (352) 377-5821
324 S HYDE PARK AVE, SUITE 250, TAMPA, FLORIDA 33606 / (813) 258-0703

AQUIFER RECHARGE AT FLATFORD SWAMP
SOUTHWEST FLORIDA WATER MANAGEMENT DISTRICT


CHEMICAL FEED ENCLOSURE PLAN
AND DETAILS

APPROVED BY	PROJECT NO:	DATE:
JOHN V. SOBCZAK	19850-041-01	AUG. 2019
P.E. #71407	INDEX NO:	DWG NO:
		S6

8
 7
 6
 5
 4
 3
 2
 1
 F
 E
 D
 C
 B
 A
 8/28/2019 10:48 AM JOHN P:\JONES EDMUNDS\18-135 FLATFORD SWAMP PUMP STATION\DRAWINGS\STRUCTURAL\S7.DWG
 8
 7
 6
 5
 4
 3
 2
 1
 F
 E
 D
 C
 B
 A
 8/28/2019 10:48 AM JOHN P:\JONES EDMUNDS\18-135 FLATFORD SWAMP PUMP STATION\DRAWINGS\STRUCTURAL\S7.DWG
 8
 7
 6
 5
 4
 3
 2
 1
 F
 E
 D
 C
 B
 A

PLOTTED: 8/28/2019 10:59 AM JOHN SOB CZAK

© Jones Edmunds 2234

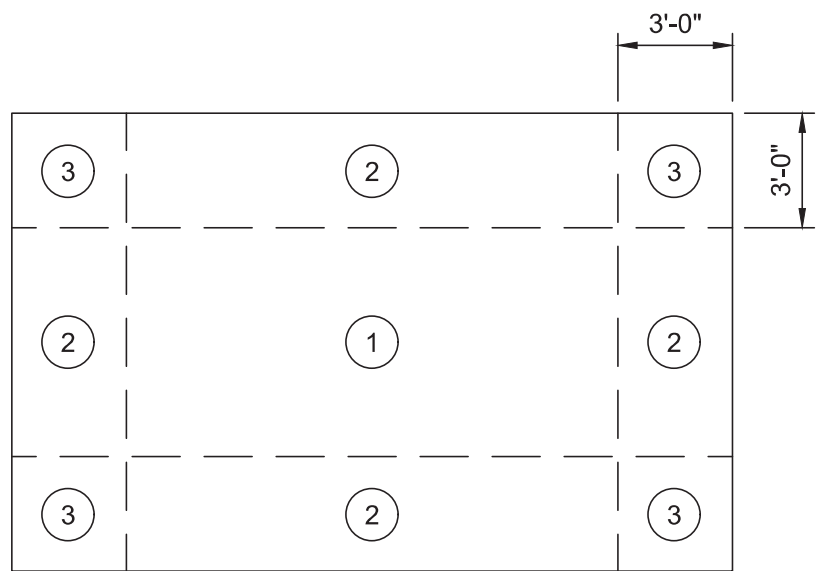


DESIGN WIND PRESSURES (COMPONENTS AND CLADDING)			
LOCATION	ZONE	P PSF	P PSF
ROOF	1	21.0	-51.8
	2	21..0	-86.9
	3	21.0	-130.7
WALLS	FIELD	47.4	-51.3
	CORNER*	47.4	-63.2

(*) CORNER ZONE WIDTH: 3'-0"
 NEGATIVE SIGN INDICATES PRESSURE OUTWARD
 ALL PRESSURES SHOWN CORRESPOND TO A COMPONENT
 W/ AREA <10FT².
 WIND PRESSURES ARE CALCULATED USING THE ULTIMATE
 WIND SPEED.


DESIGN WIND PRESSURES

NTS

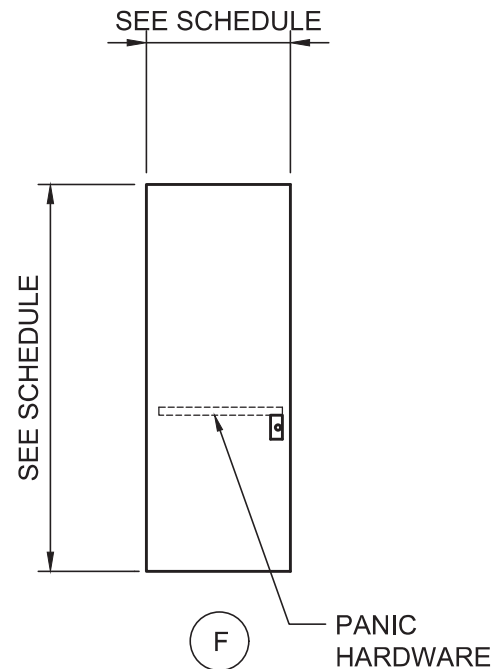


DOOR TYPES

NTS

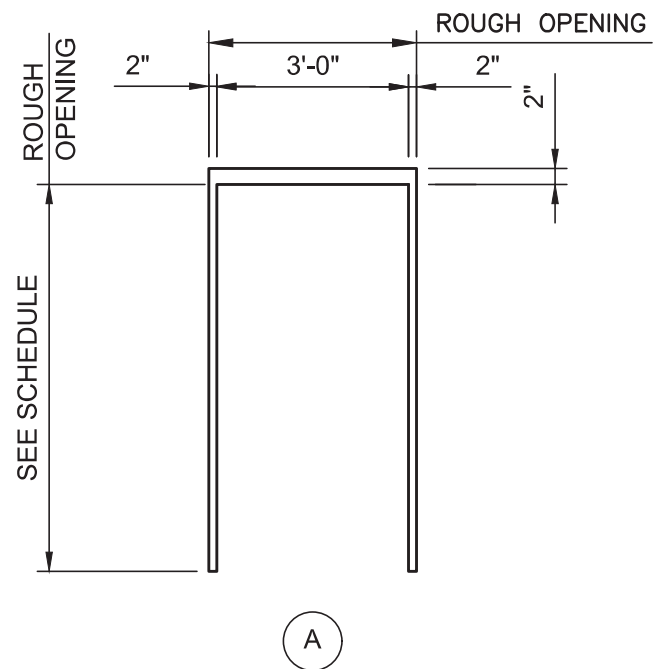



FRAME TYPES

NTS

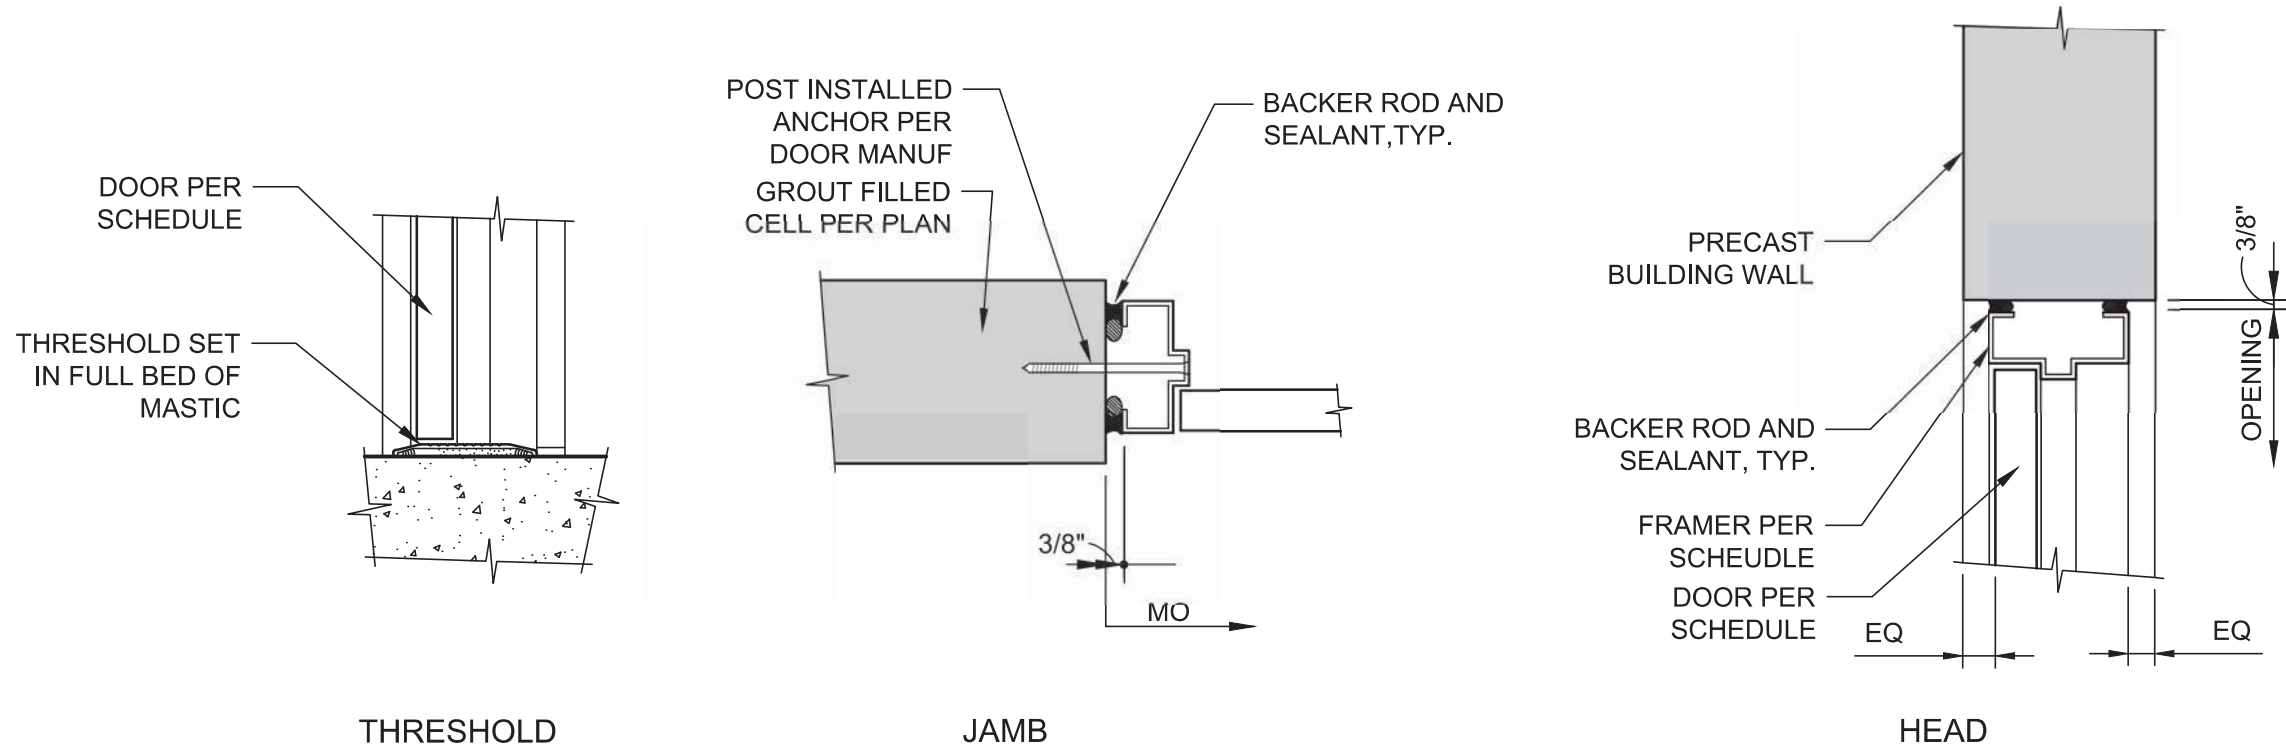



DETAIL

1"=1'-0"

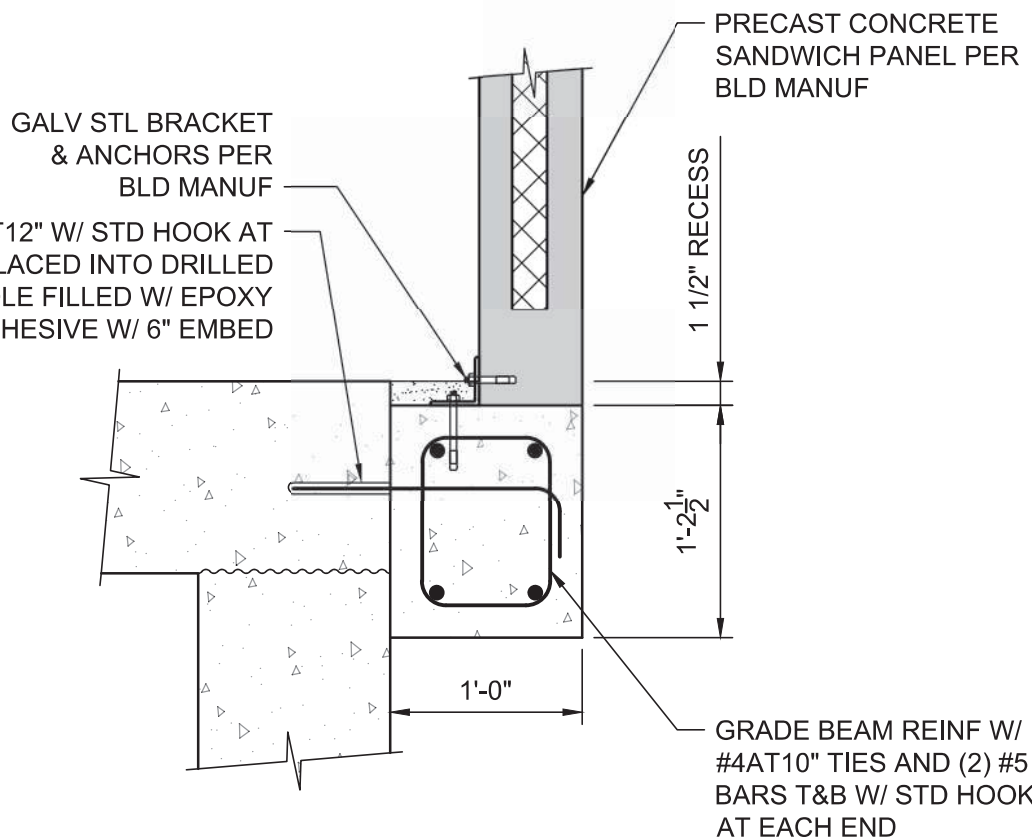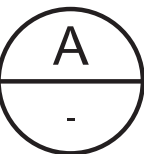

DETAIL


1"=1'-0"

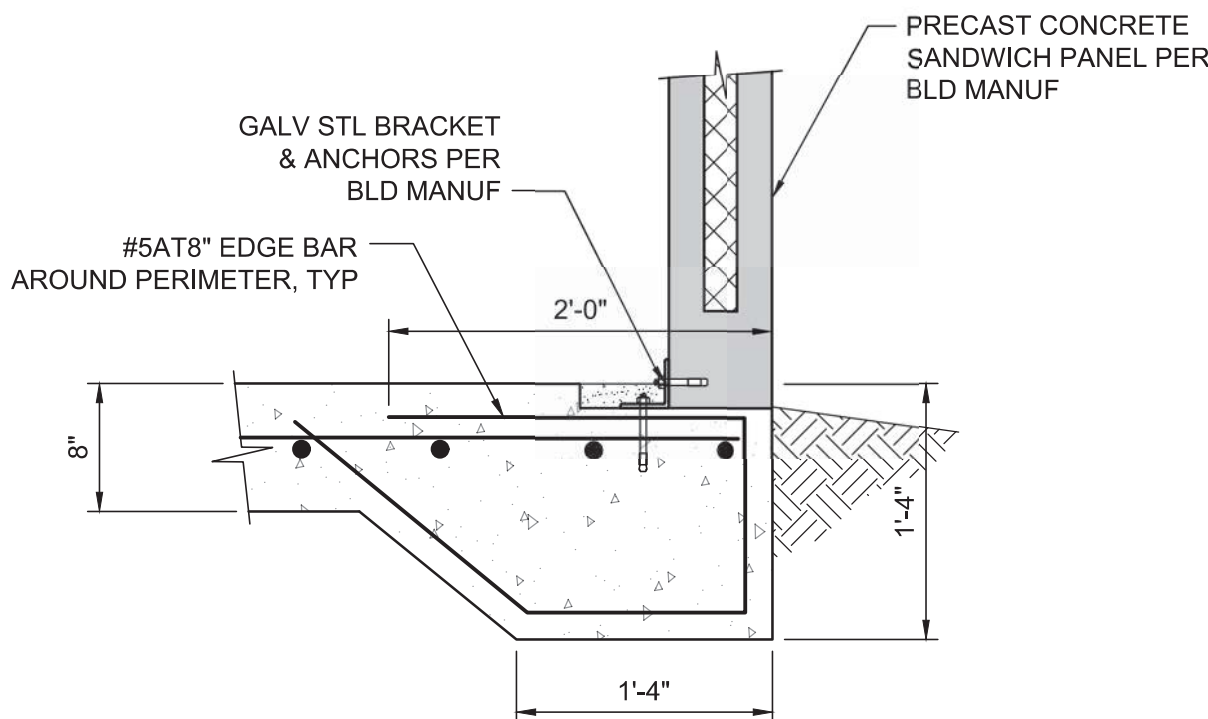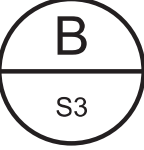

THICKENED EDGE WITH FENCE POST

DETAIL

1"=1'-0"

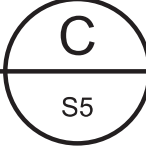

					DESIGNED	J.SOBCZAK
					DRAWN	J.SOBCZAK
					CHECKED	D.MORRIS
LTR.	DATE	REVISIONS		BY	APPRD.	



CERTIFICATE OF AUTHORIZATION #1841
 730 NE WALDO ROAD, GAINESVILLE, FLORIDA 32641 / (352) 377-5821
 324 S HYDE PARK AVE, SUITE 250, TAMPA, FLORIDA 33606 / (813) 258-0703


AQUIFER RECHARGE AT FLATFORD SWAMP
 SOUTHWEST FLORIDA WATER MANAGEMENT DISTRICT

BUILDING
 SCHEDULES AND DETAILS


APPROVED BY	PROJECT NO:	DATE:
JOHN V. SOB CZAK	19850-041-01	AUG. 2019
P.E. #71407	INDEX NO:	DWG NO:
		S7

SAVED: 8/28/2019 10:50 AM JOHN P:\\JONES EDMUNDS\\18-135 FLATFORD SWAMP PUMP STATION\\DRAWINGS\\STRUCTURAL\\S8.DWG


BID SET

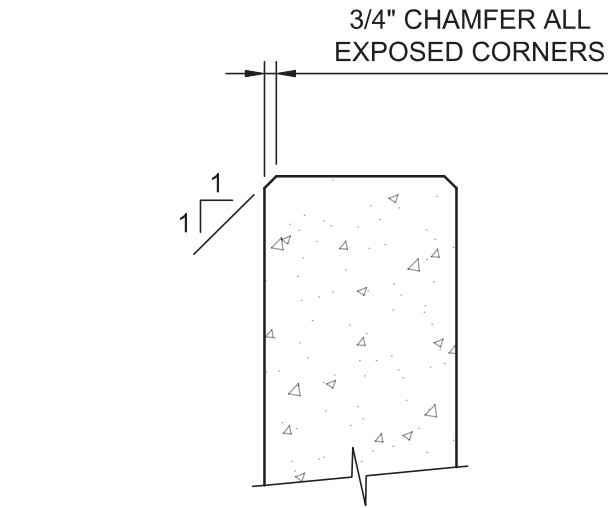

CHAMFER
DETAIL A
NTS

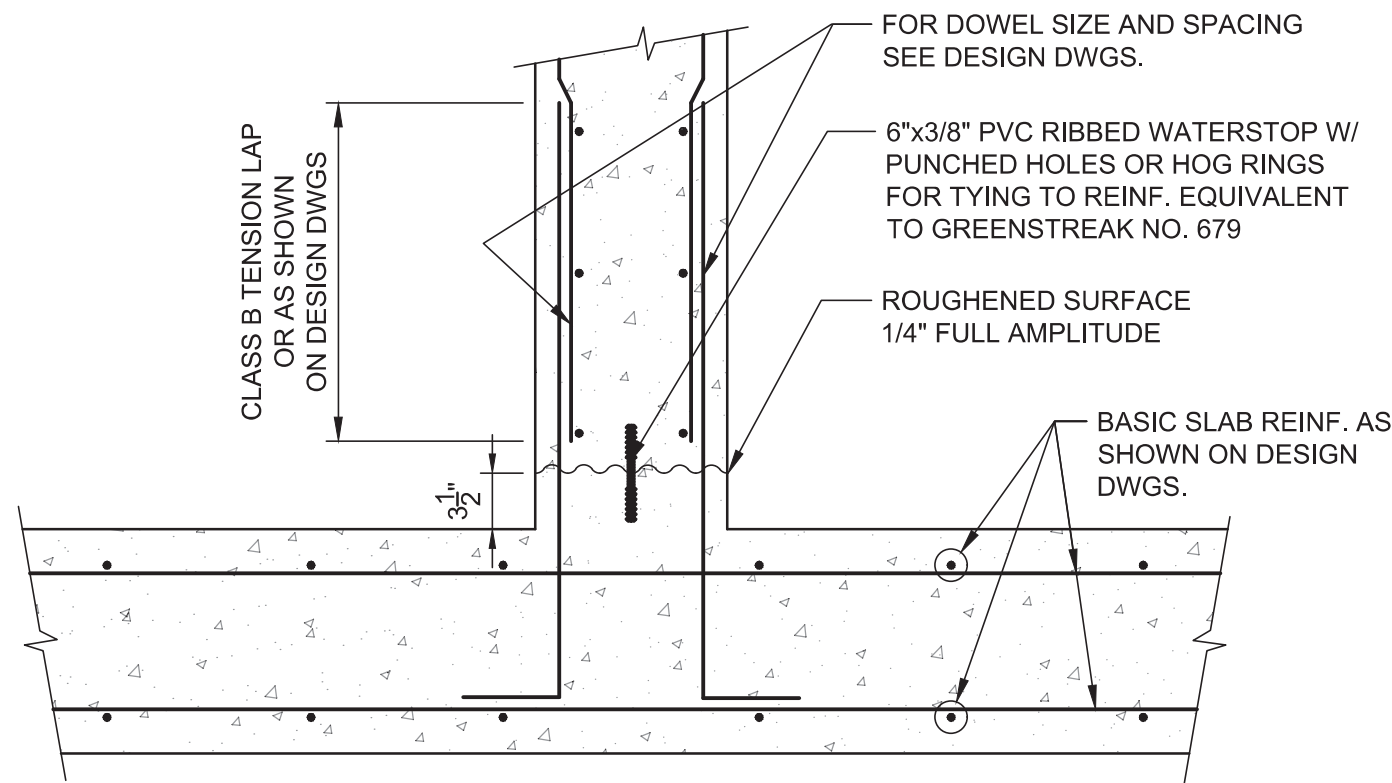


WALL BASE CONSTRUCTION JOINT
DETAIL B
NTS

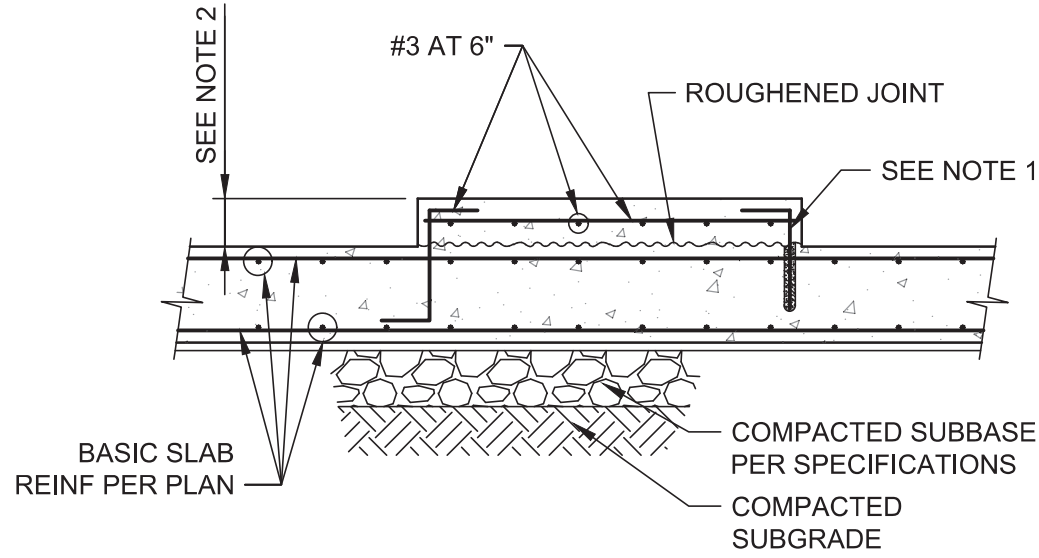


- NOTE:
1. FOR EXISTING CONCRETE SLAB DRILL AND EPOXY #5AT12" AROUND PERIMETER W/ 6" MIN EMBEDMENT.
 2. COORDINATE WITH MANUFACTURER REQUIREMENTS AND "M" DRAWINGS FOR MINIMUM PAD HEIGHT.


EQUIPMENT PAD
DETAIL E
NTS

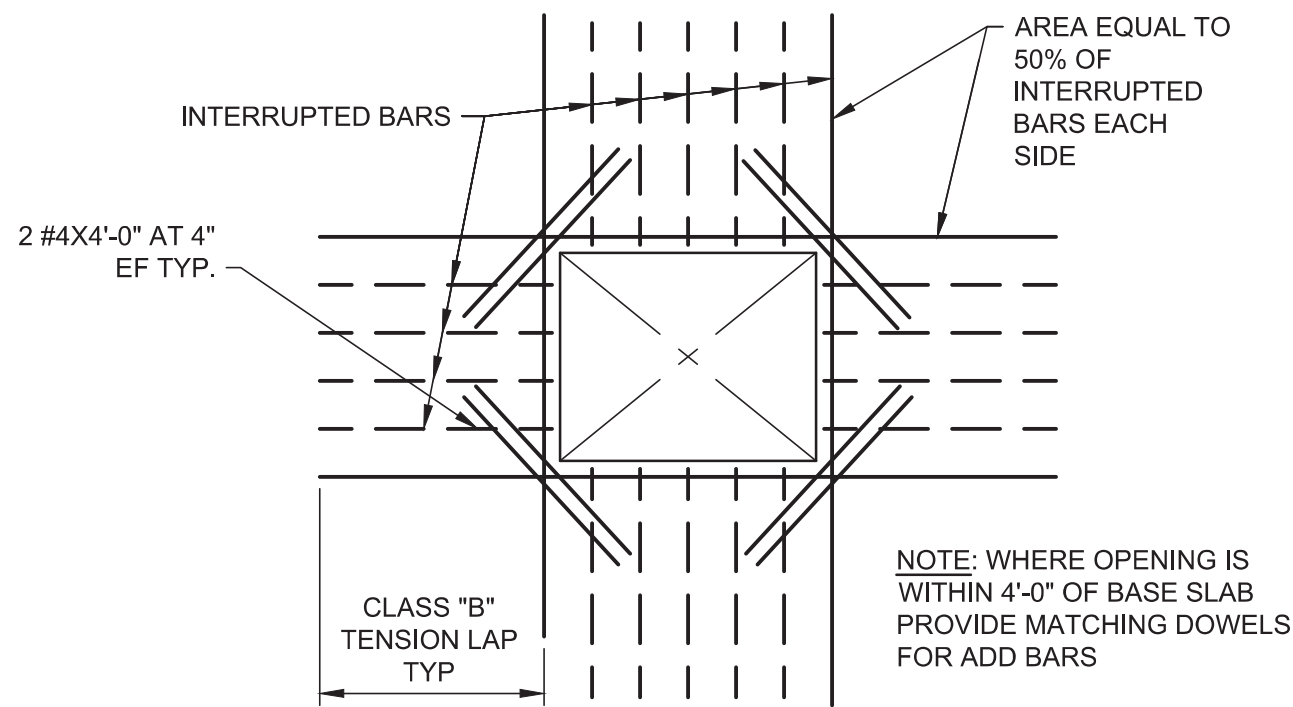

REINF AT RECTANGULAR OPENINGS GREATER THAN 12"
DETAIL C
NTS

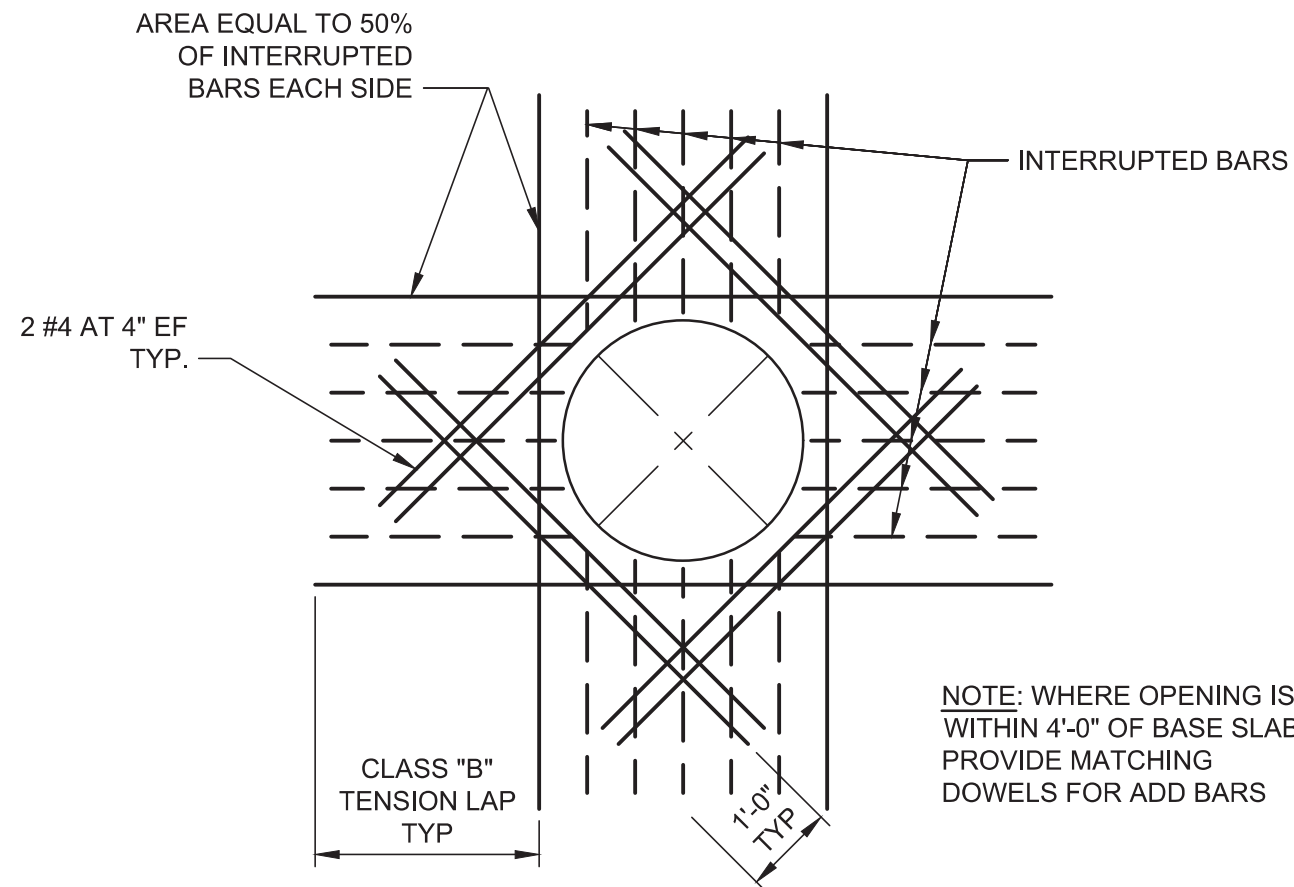

REINF AT CIRCULAR OPENINGS GREATER THAN 12"
DETAIL D
NTS

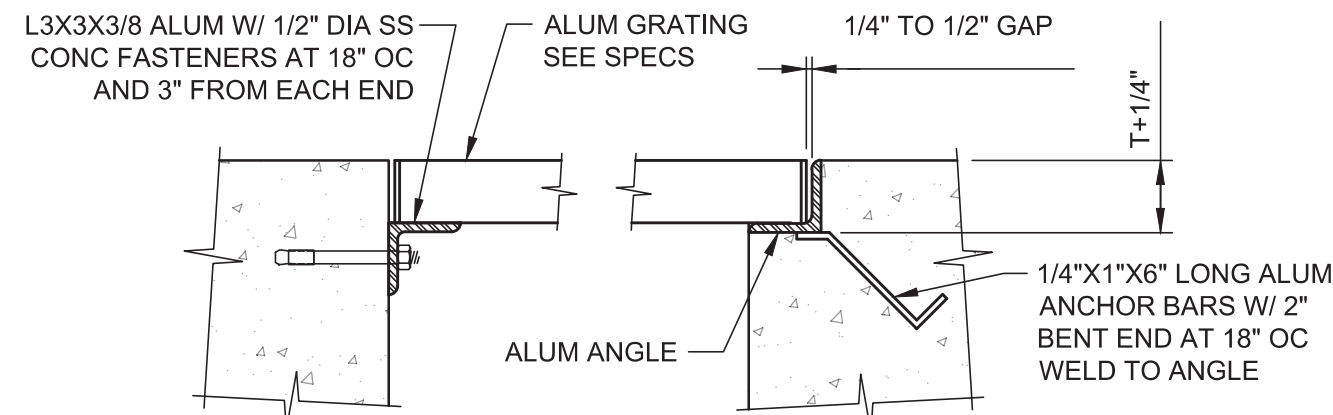

MAXIMUM SPAN	DEPTH	BEARING BAR	
		THICKNESS	SPACING
3'-0"	1 1/4"	3/16"	1 3/16"
4'-0"	1 1/2"	3/16"	1 3/16"
5'-0"	2"	3/16"	1 3/16"
6'-0"	2 1/4"	3/16"	1 3/16"

ALUM GRATING AND GRATING SUPPORT
DETAIL F
NTS



LTR.	DATE	REVISIONS	BY	APPRD.

DESIGNED	J.SOB CZAK
DRAWN	J.SOB CZAK
CHECKED	D.MORRIS


JonesEdmunds

CERTIFICATE OF AUTHORIZATION #1841
730 NE WALDO ROAD, GAINESVILLE, FLORIDA 32641 / (352) 377-5821
324 S HYDE PARK AVE, SUITE 250, TAMPA, FLORIDA 33606 / (813) 258-0703


AQUIFER RECHARGE AT FLATFORD SWAMP
SOUTHWEST FLORIDA WATER MANAGEMENT DISTRICT

BUILDING
SCHEDULES AND DETAILS

APPROVED BY JOHN V. SOB CZAK P.E. #71407	PROJECT NO: 19850-041-01	DATE: AUG. 2019
	INDEX NO:	DWG NO: S8

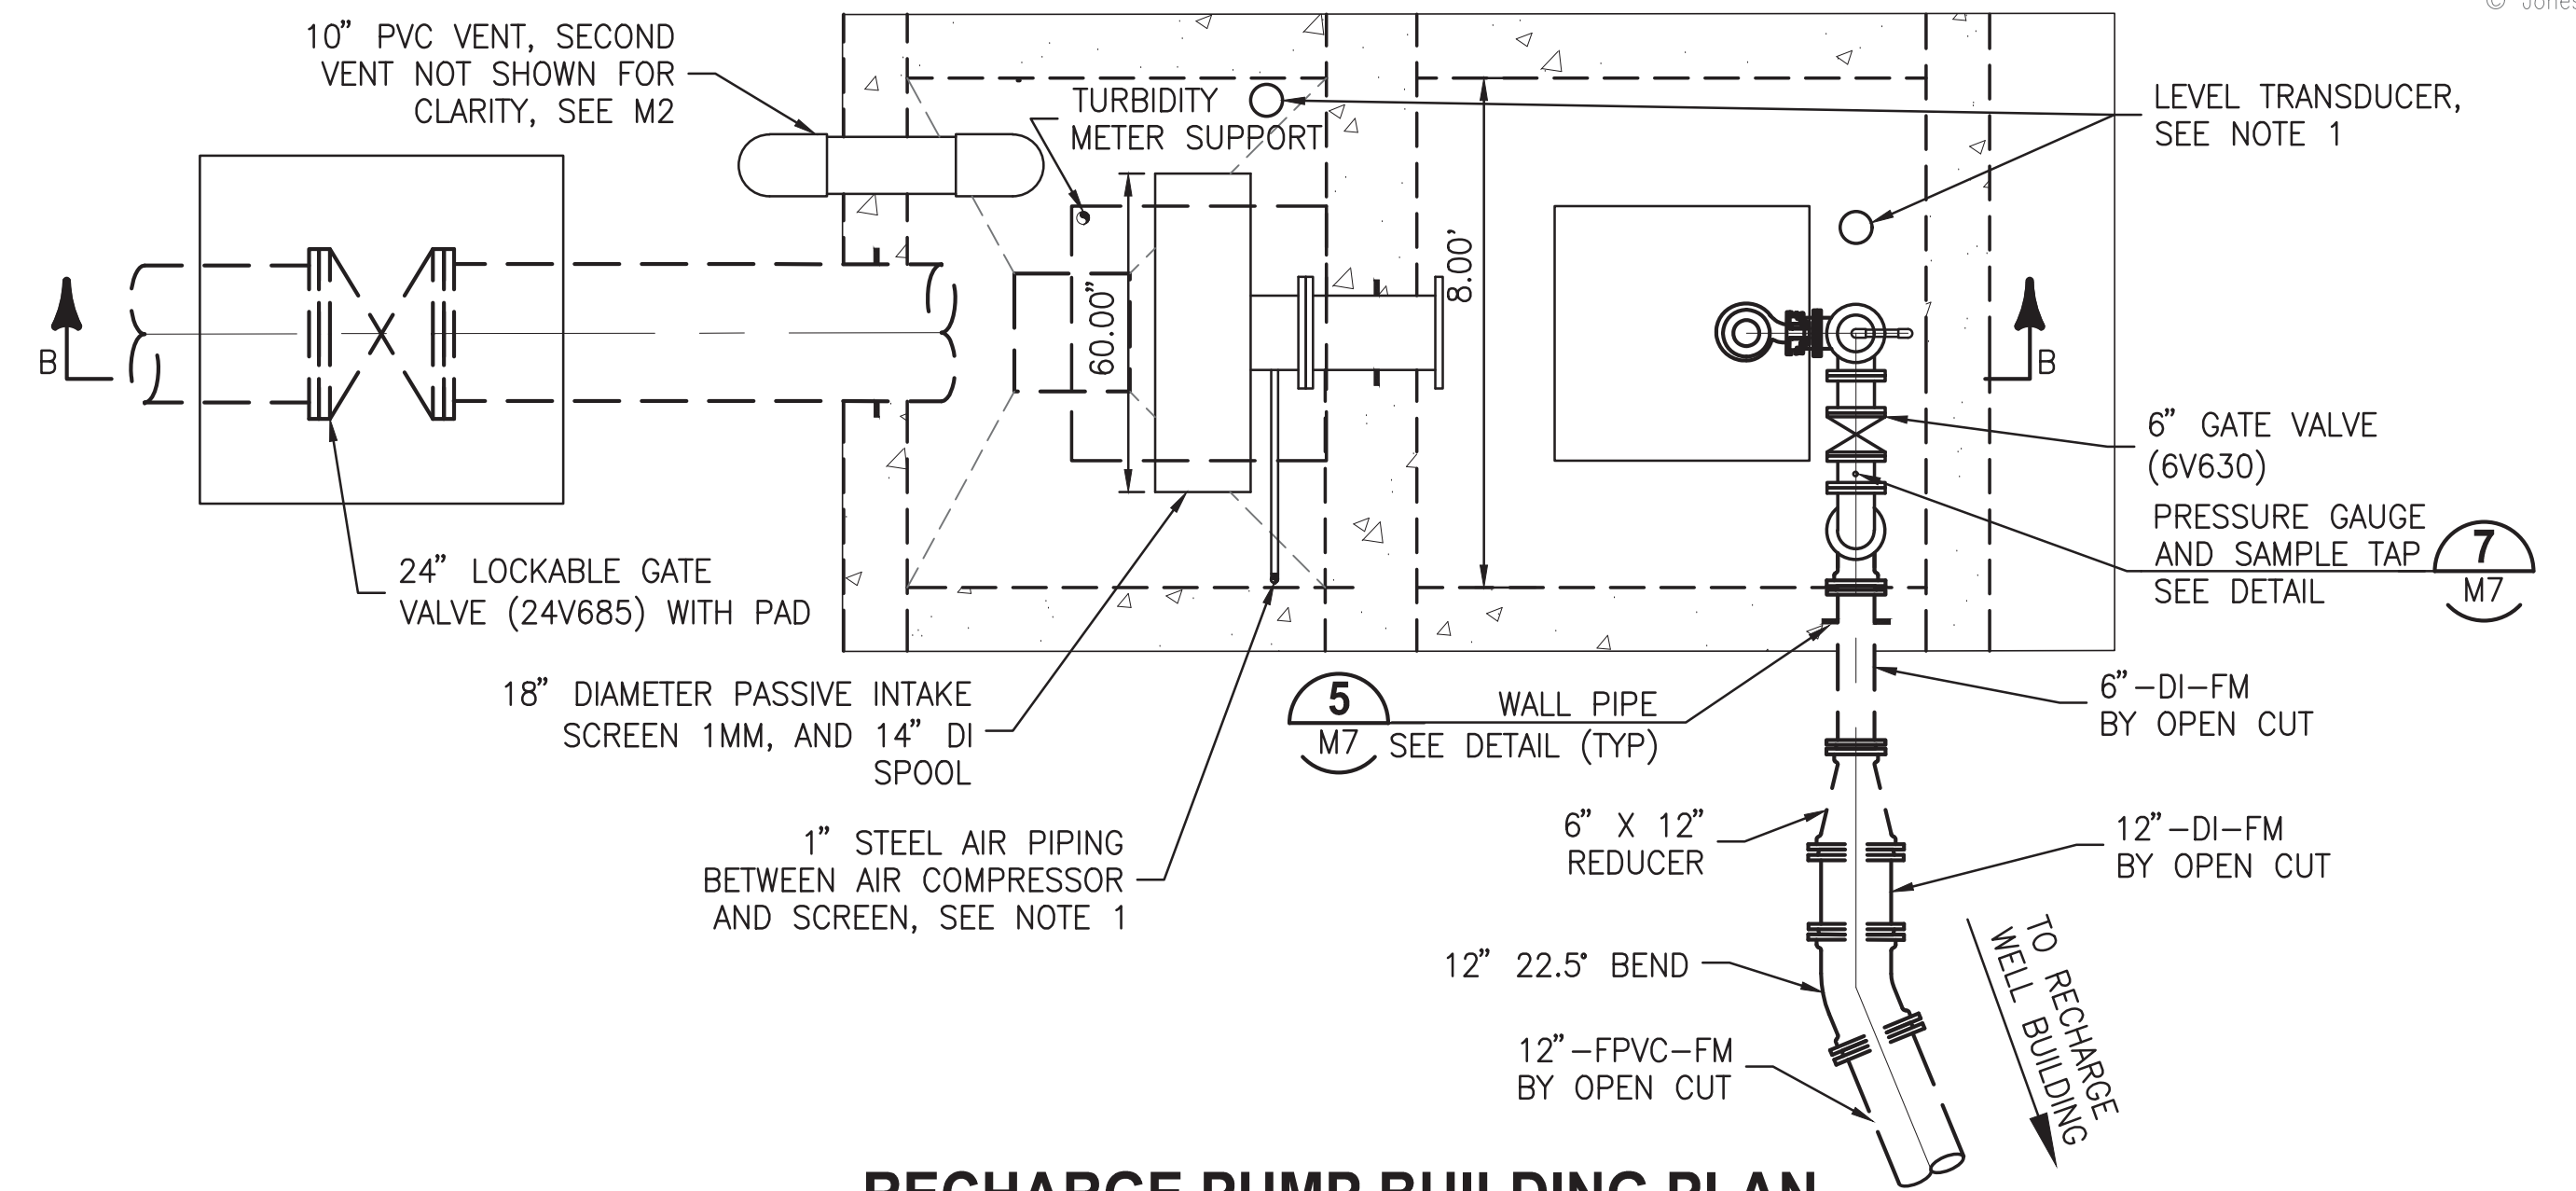

RECHARGE PUMP BUILDING PLAN

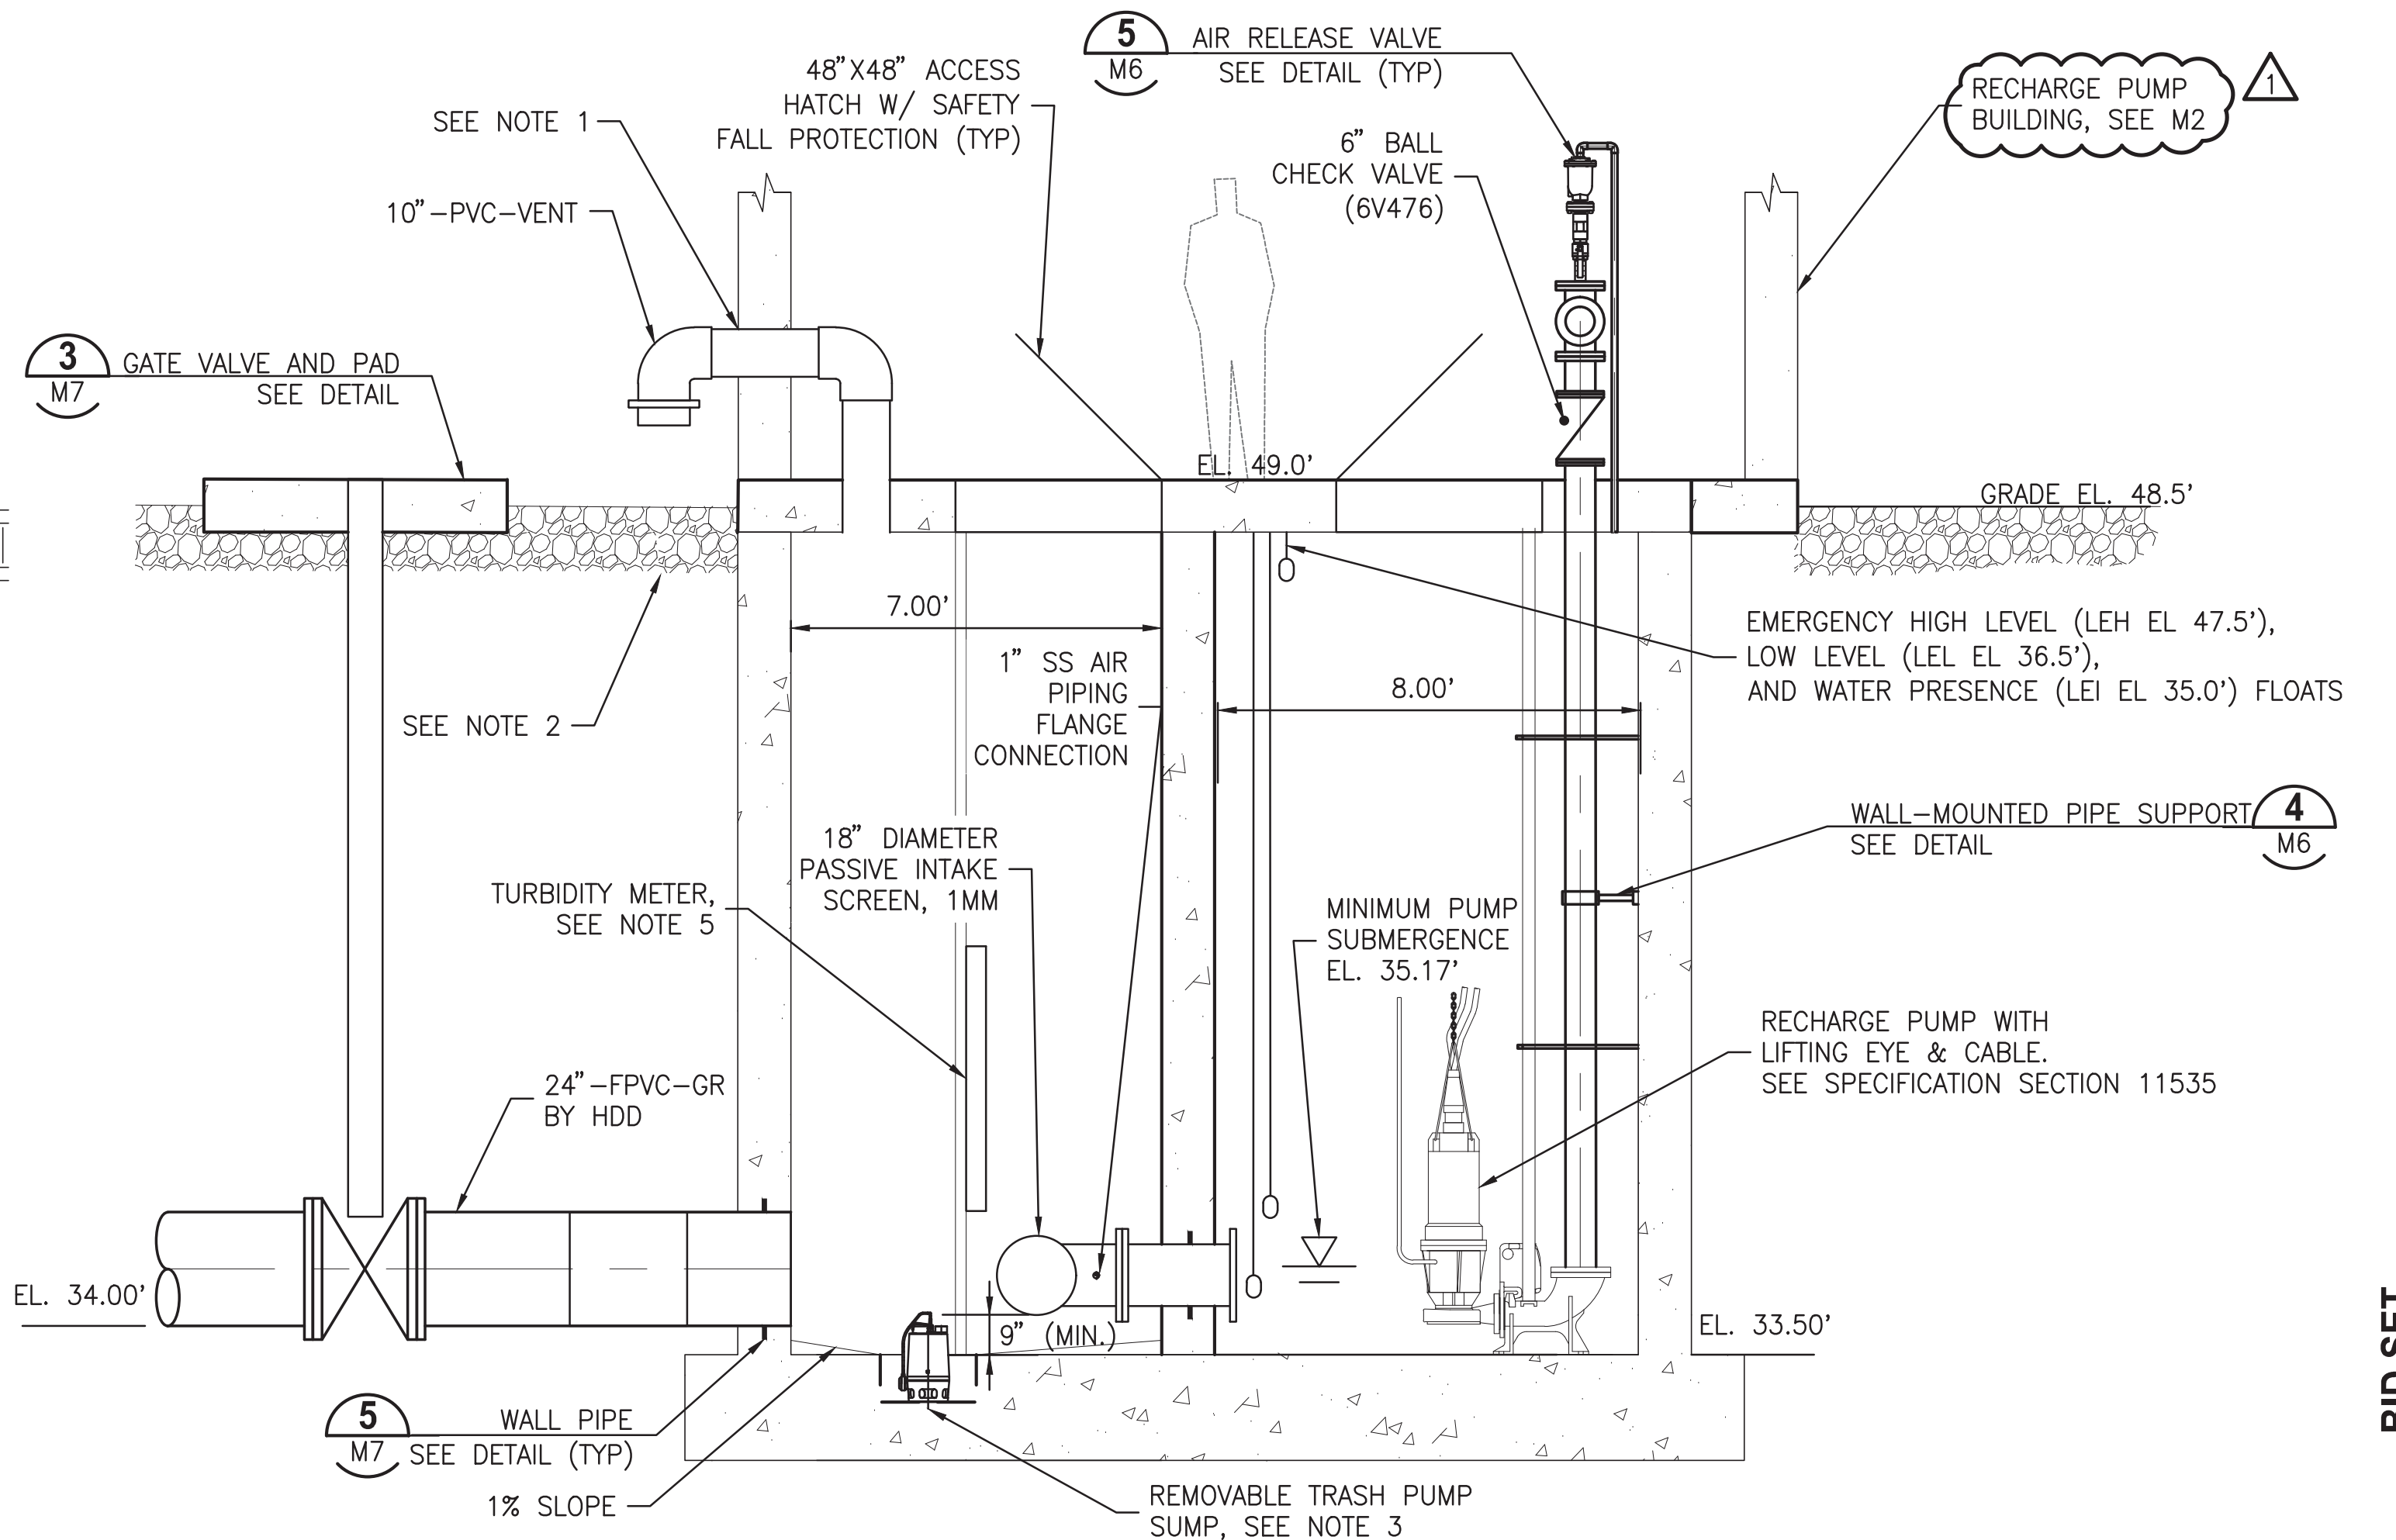


RECHARGE PUMP BUILDING

SECTION B-B

NTS

- | | | |
|---------------------|-----------------------------|--------------------|
| APPROVED BY | PROJECT NO:
19850-041-01 | DATE:
SEP. 2019 |
| THOMAS W. FRIEDRICH | INDEX NO: | DWG NO:
M1 |
| P.E. 61281 | | |

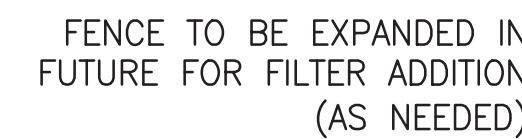

NTS



1. ALL BUILDINGS AND ABOVEGROUND APPURTENANCES SHALL HAVE A 12-INCH THICK LAYER OF #57 STONE EXTENDING A MINIMUM OF 10 FEET FROM ANY ABOVEGROUND CONCRETE SURFACE. THE STONE SHALL BE RESTING ON FILTER FABRIC.
2. TEMPORARY CHEMICAL FEED SYSTEM, STORAGE TANKS, AND CHEMICAL SUPPLY SHALL BE AS PROVIDED BY ODYSSEY MANUFACTURING. CHEMICAL STORAGE TANKS EACH TO BE 102" DIAMETER, 123.75" TALL, 2,500 GALLON DUAL CONTAINMENT TANKS. PUMP SKID SHALL BE ENCLOSED DUPLEX BLUE PLANET CONTAINING TWO PROMINENT PUMPS. THE PUMP SKID SHALL BE CONSTRUCTED OF WHITE WELDED PVC SHEETS. EACH PUMP SHALL CONTAIN A PULSE DAMPENER, BACKPRESSURE OR ANTI-SIPHON VALVE, PRESSURE RELIEF VALVE, INLET AND OUTLET FLUSHING CONNECTIONS, INLET AND OUTLET ISOLATION VALVES, A DISCHARGE PRESSURE GAUGE, AND AN INLET STRAINER. THE SKID SHALL CONTAIN A COMMON CALIBRATION COLUMN WHICH SHALL BE VENTED BACK TO THE STORAGE TANKS. ALL PIPING ON THE SKID SHALL BE 1/2" SCH 80 PVC EXCEPT FOR THE INLET HEADER WHICH SHALL BE 1". PUMP SKID SHALL CONNECT TO SAF-T-FLO RETRACTABLE INJECTION QUILL MODEL EB-125-S-P-6-CE-E, OR ENGINEER APPROVED EQUAL, BY SAF-T-FLO FLEXIBLE HOSE ASSEMBLY, MODEL FHB-CLR-075-P-E, OR ENGINEER APPROVED EQUAL.
3. ON BEHALF OF SWFWMCD AND MANATEE COUNTY, ODYSSEY MANUFACTURING TO COORDINATE REGISTRATION OF GROUND STORAGE TANKS IN ACCORDANCE WITH F.A.C. 62-762.401 30 DAYS BEFORE PLACED INTO SERVICE AND INSTALL REGISTRATION PLACARD ON EACH TANK.
4. WAFER STYLE STATIC MIXER SHALL BE WESTFALL MODEL 2800 .9 BETA, OR ENGINEER APPROVED EQUAL.
5. CONCRETE SLAB SHALL EXTEND TO ACCOMMODATE DOOR ACCESS.
6. ACCESS HATCH SHALL BE OFF-CENTER TO ACCOUNT FOR COMPRESSOR DIMENSIONS.
7. AHU-1 IS A WALL MOUNTED UNIT, SPLIT SYSTEM, AS MANUFACTURED BY MITSUBISHI, MODEL MSZ/MUZ-GL12NA-UI (FOR INDOOR/OUTDOOR UNIT). SYSTEM SHALL BE 12,000 BTU, 208/230V, SINGLE PHASE, 60 HZ. INDOOR UNIT SHALL BE MOUNTED ON WALL WITH TOP OF UNIT LOCATED 4" BELOW CEILING. ROUTE REFRIGERANT AND CONDENSATE LINES THROUGH WALL SLEEVE TOGETHER. ROUTE CONDENSATE AND REFRIGERATION LINES DOWN WALL TO GRADE, SECURE TO WALL IN A MANNER THAT EXCEEDS LOCAL WIND CRITERIA. CONDENSING UNIT DISCHARGE SHALL FACE WALL, MOUNTED ON PAD PER MANUFACTURER'S INSTRUCTIONS.
8. RECIRCULATION PUMPS, VALVING, AND SIGHT GLASS SHALL BE AS PROVIDED BY ODYSSEY MANUFACTURING. PUMP SHALL BE FINISH THOMPSON MODWL 3 DB6P-E-FF-2-SR-M224 OR ENGINEER APPROVED EQUAL.




DESIGNED	<u>SMENARD</u>
DRAWN	<u>JKRAMER</u>
CHECKED	<u>DYONGE</u>

**AQUIFER RECHARGE AT FLATFORD SWAMP
SOUTHWEST FLORIDA WATER MANAGEMENT DISTRICT**

APPROVED BY
THOMAS W. FRIEDRICH
P.E. 61281

PROJECT NO: 19850-041-01	DATE: SEP. 2019
INDEX NO:	DWG NO: M2


1/20/2020 8:47 AM JKRAMER Y:\19850-SWFWM\PROJECTS\041-01_FLATFORD SWAMP AQUIFER RECHARGE\CAD\DWGS\MECH\1985004101-M03.DWG
 1/20/2020 10:13 AM JOHN KRAMER

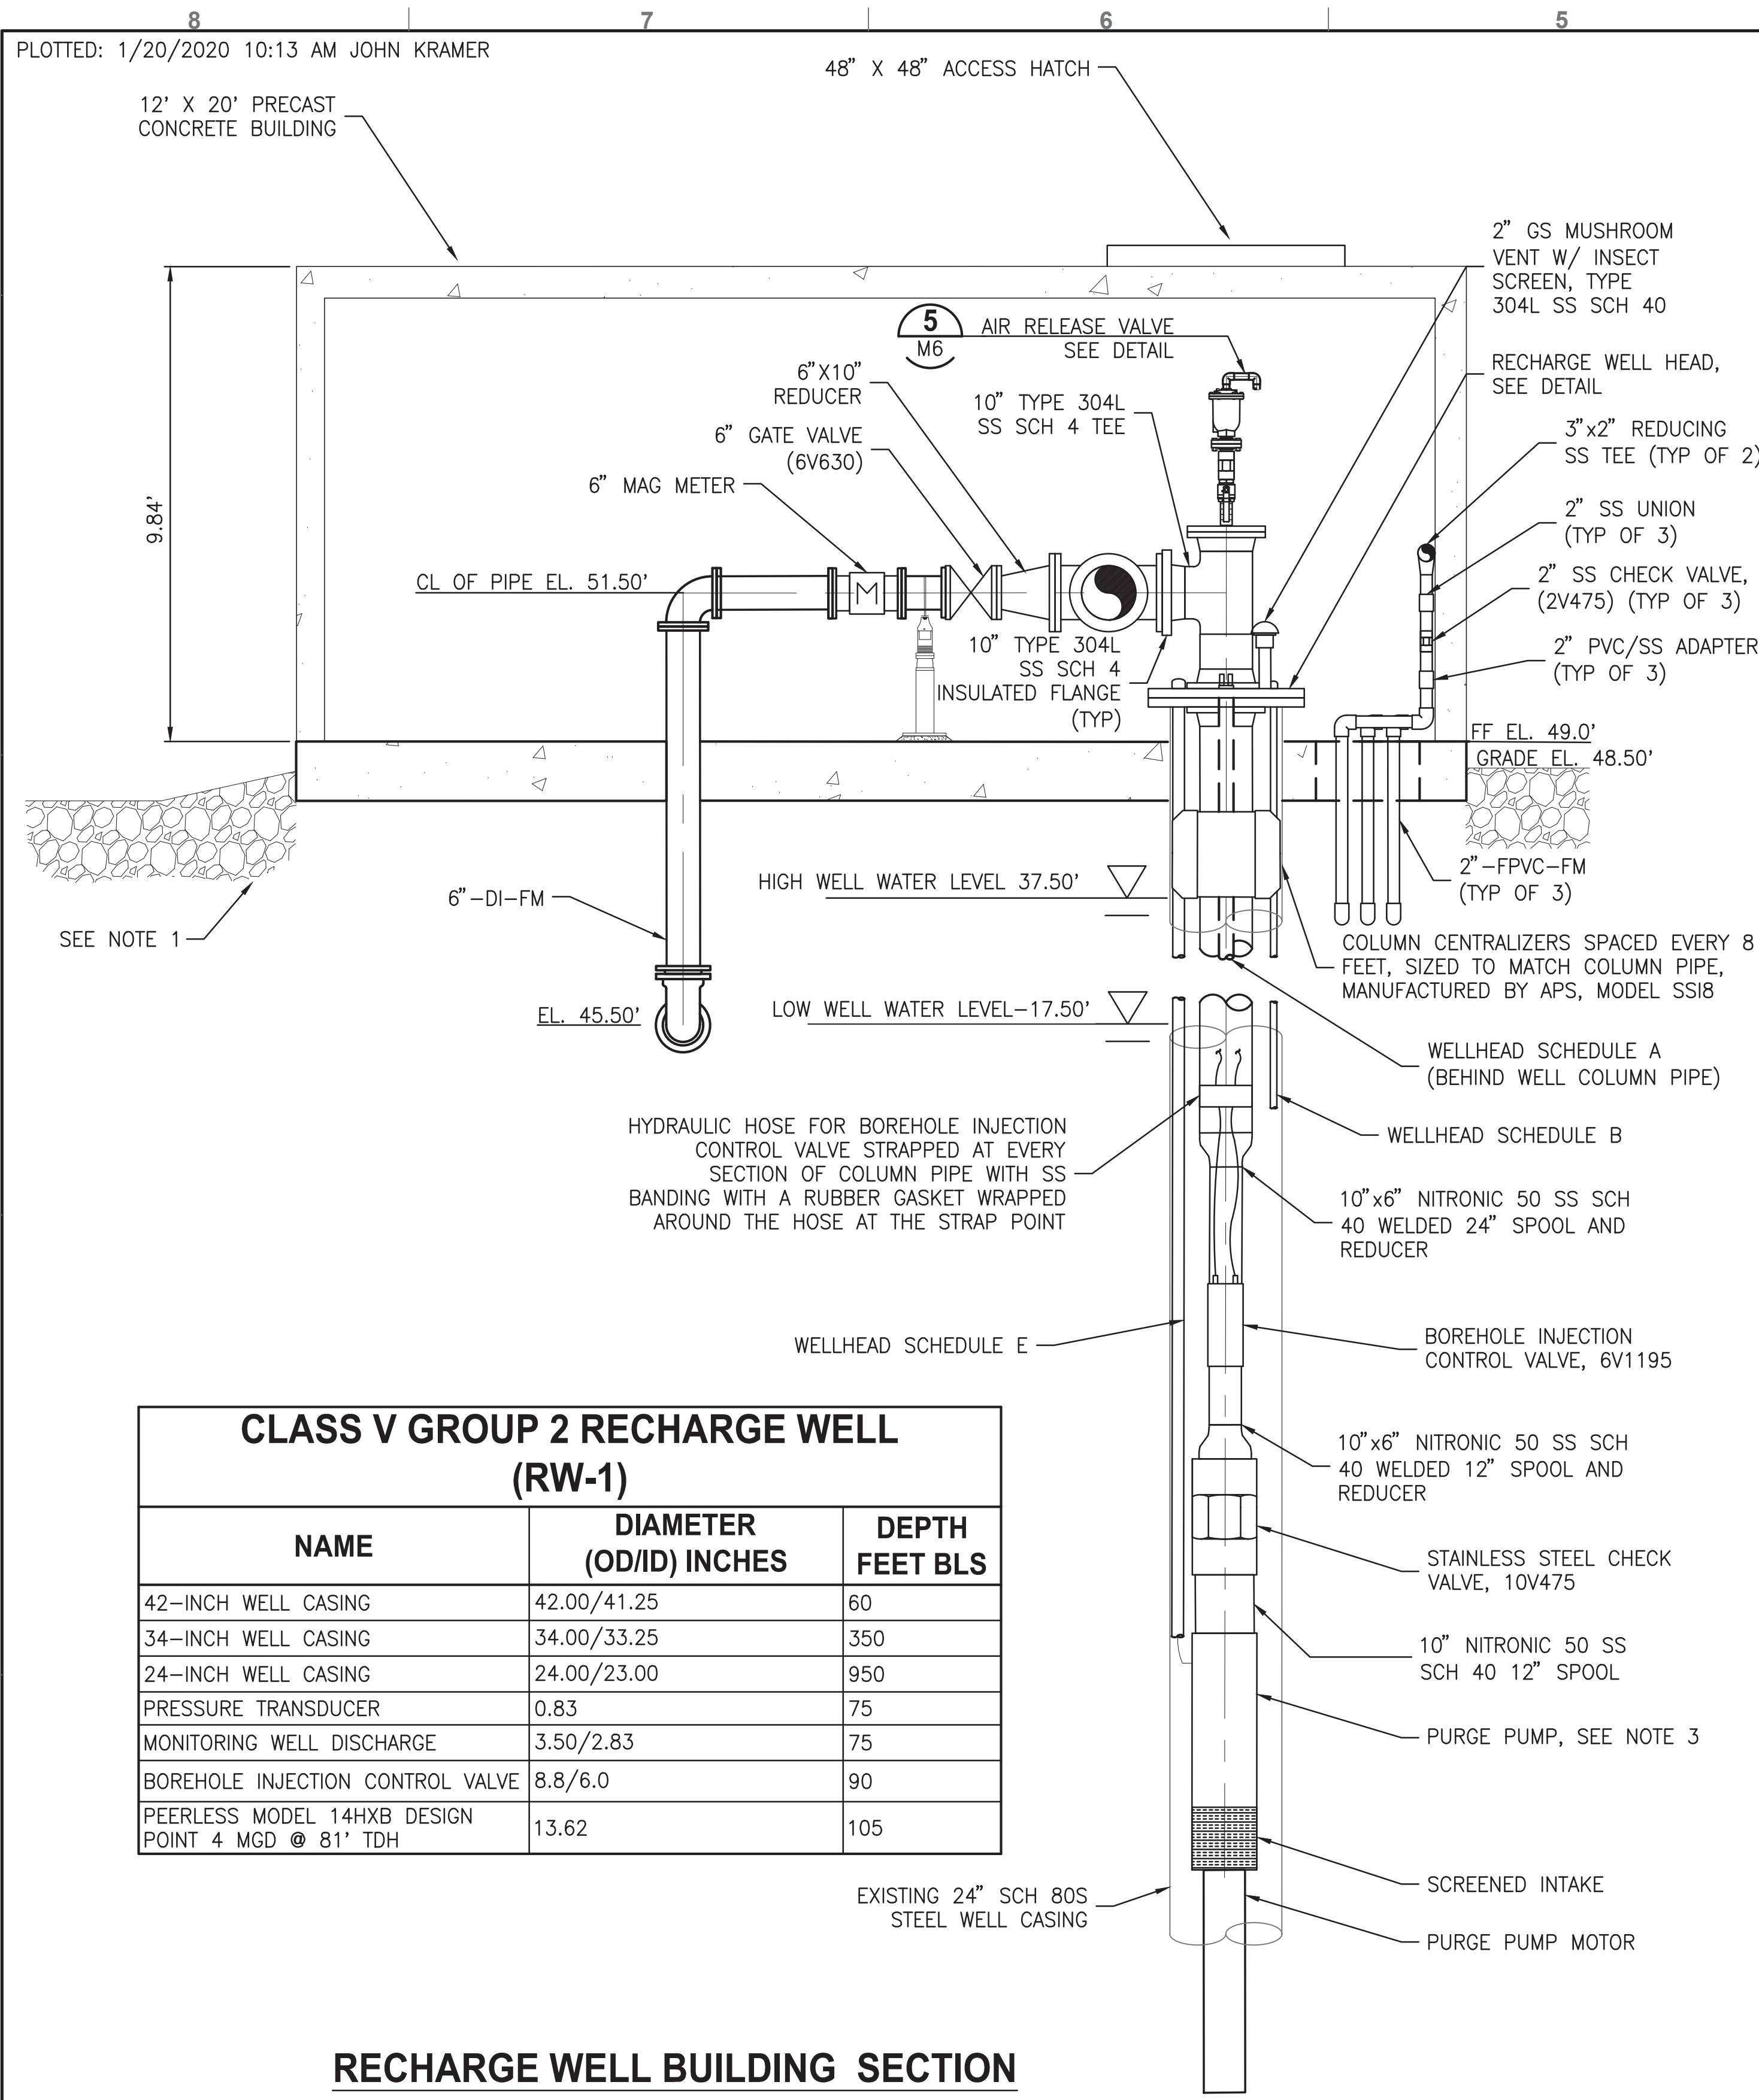

CLASS V GROUP 2 RECHARGE WELL (RW-1)		
NAME	DIAMETER (OD/ID) INCHES	DEPTH FEET BLS
42-INCH WELL CASING	42.00/41.25	60
34-INCH WELL CASING	34.00/33.25	350
24-INCH WELL CASING	24.00/23.00	950
PRESSURE TRANSDUCER	0.83	75
MONITORING WELL DISCHARGE	3.50/2.83	75
BOREHOLE INJECTION CONTROL VALVE	8.8/6.0	90
PEERLESS MODEL 14HXB DESIGN POINT 4 MGD @ 81' TDH	13.62	105

RECHARGE WELL BUILDING SECTION

- NOTES:
- ALL BUILDINGS AND ABOVEGROUND APPURTENANCES SHALL HAVE A 12-INCH THICK LAYER OF #57 STONE EXTENDING A MINIMUM OF 10 FEET FROM ANY ABOVEGROUND CONCRETE SURFACE. THE STONE SHALL BE RESTING ON FILTER FABRIC.
 - CONCRETE SLAB SHALL EXTEND TO ACCOMMODATE DOOR ACCESS.
 - SUBMERSIBLE PURGE PUMP SHALL BE RATED AS REFERENCED IN THE ABOVE TABLE OR ENGINEER APPROVED EQUAL.

					DESIGNED	<u>SMENARD</u>
					DRAWN	<u>JKRAMER</u>
	JAN/2020	ADDENDUM 1-TEXT AND UTILITY ADJUST.	JTK	SPM	CHECKED	<u>DYONGE</u>
LTR.	DATE	REVISIONS	BY	APPRD.		



JonesEdmunds

CERTIFICATE OF AUTHORIZATION #1841
 730 NE WALDO ROAD, GAINESVILLE, FLORIDA 32641 / (352) 377-5821
 324 S HYDE PARK AVE, SUITE 250, TAMPA, FLORIDA 33606 / (813) 258-0703

AQUIFER RECHARGE AT FLATFORD SWAMP
SOUTHWEST FLORIDA WATER MANAGEMENT DISTRICT

RECHARGE WELL BUILDING PLAN AND
SECTION

APPROVED BY	PROJECT NO:	DATE:
THOMAS W. FRIEDRICH	19850-041-01	SEP. 2019
P.E. 61281	INDEX NO:	DWG NO:
		M3

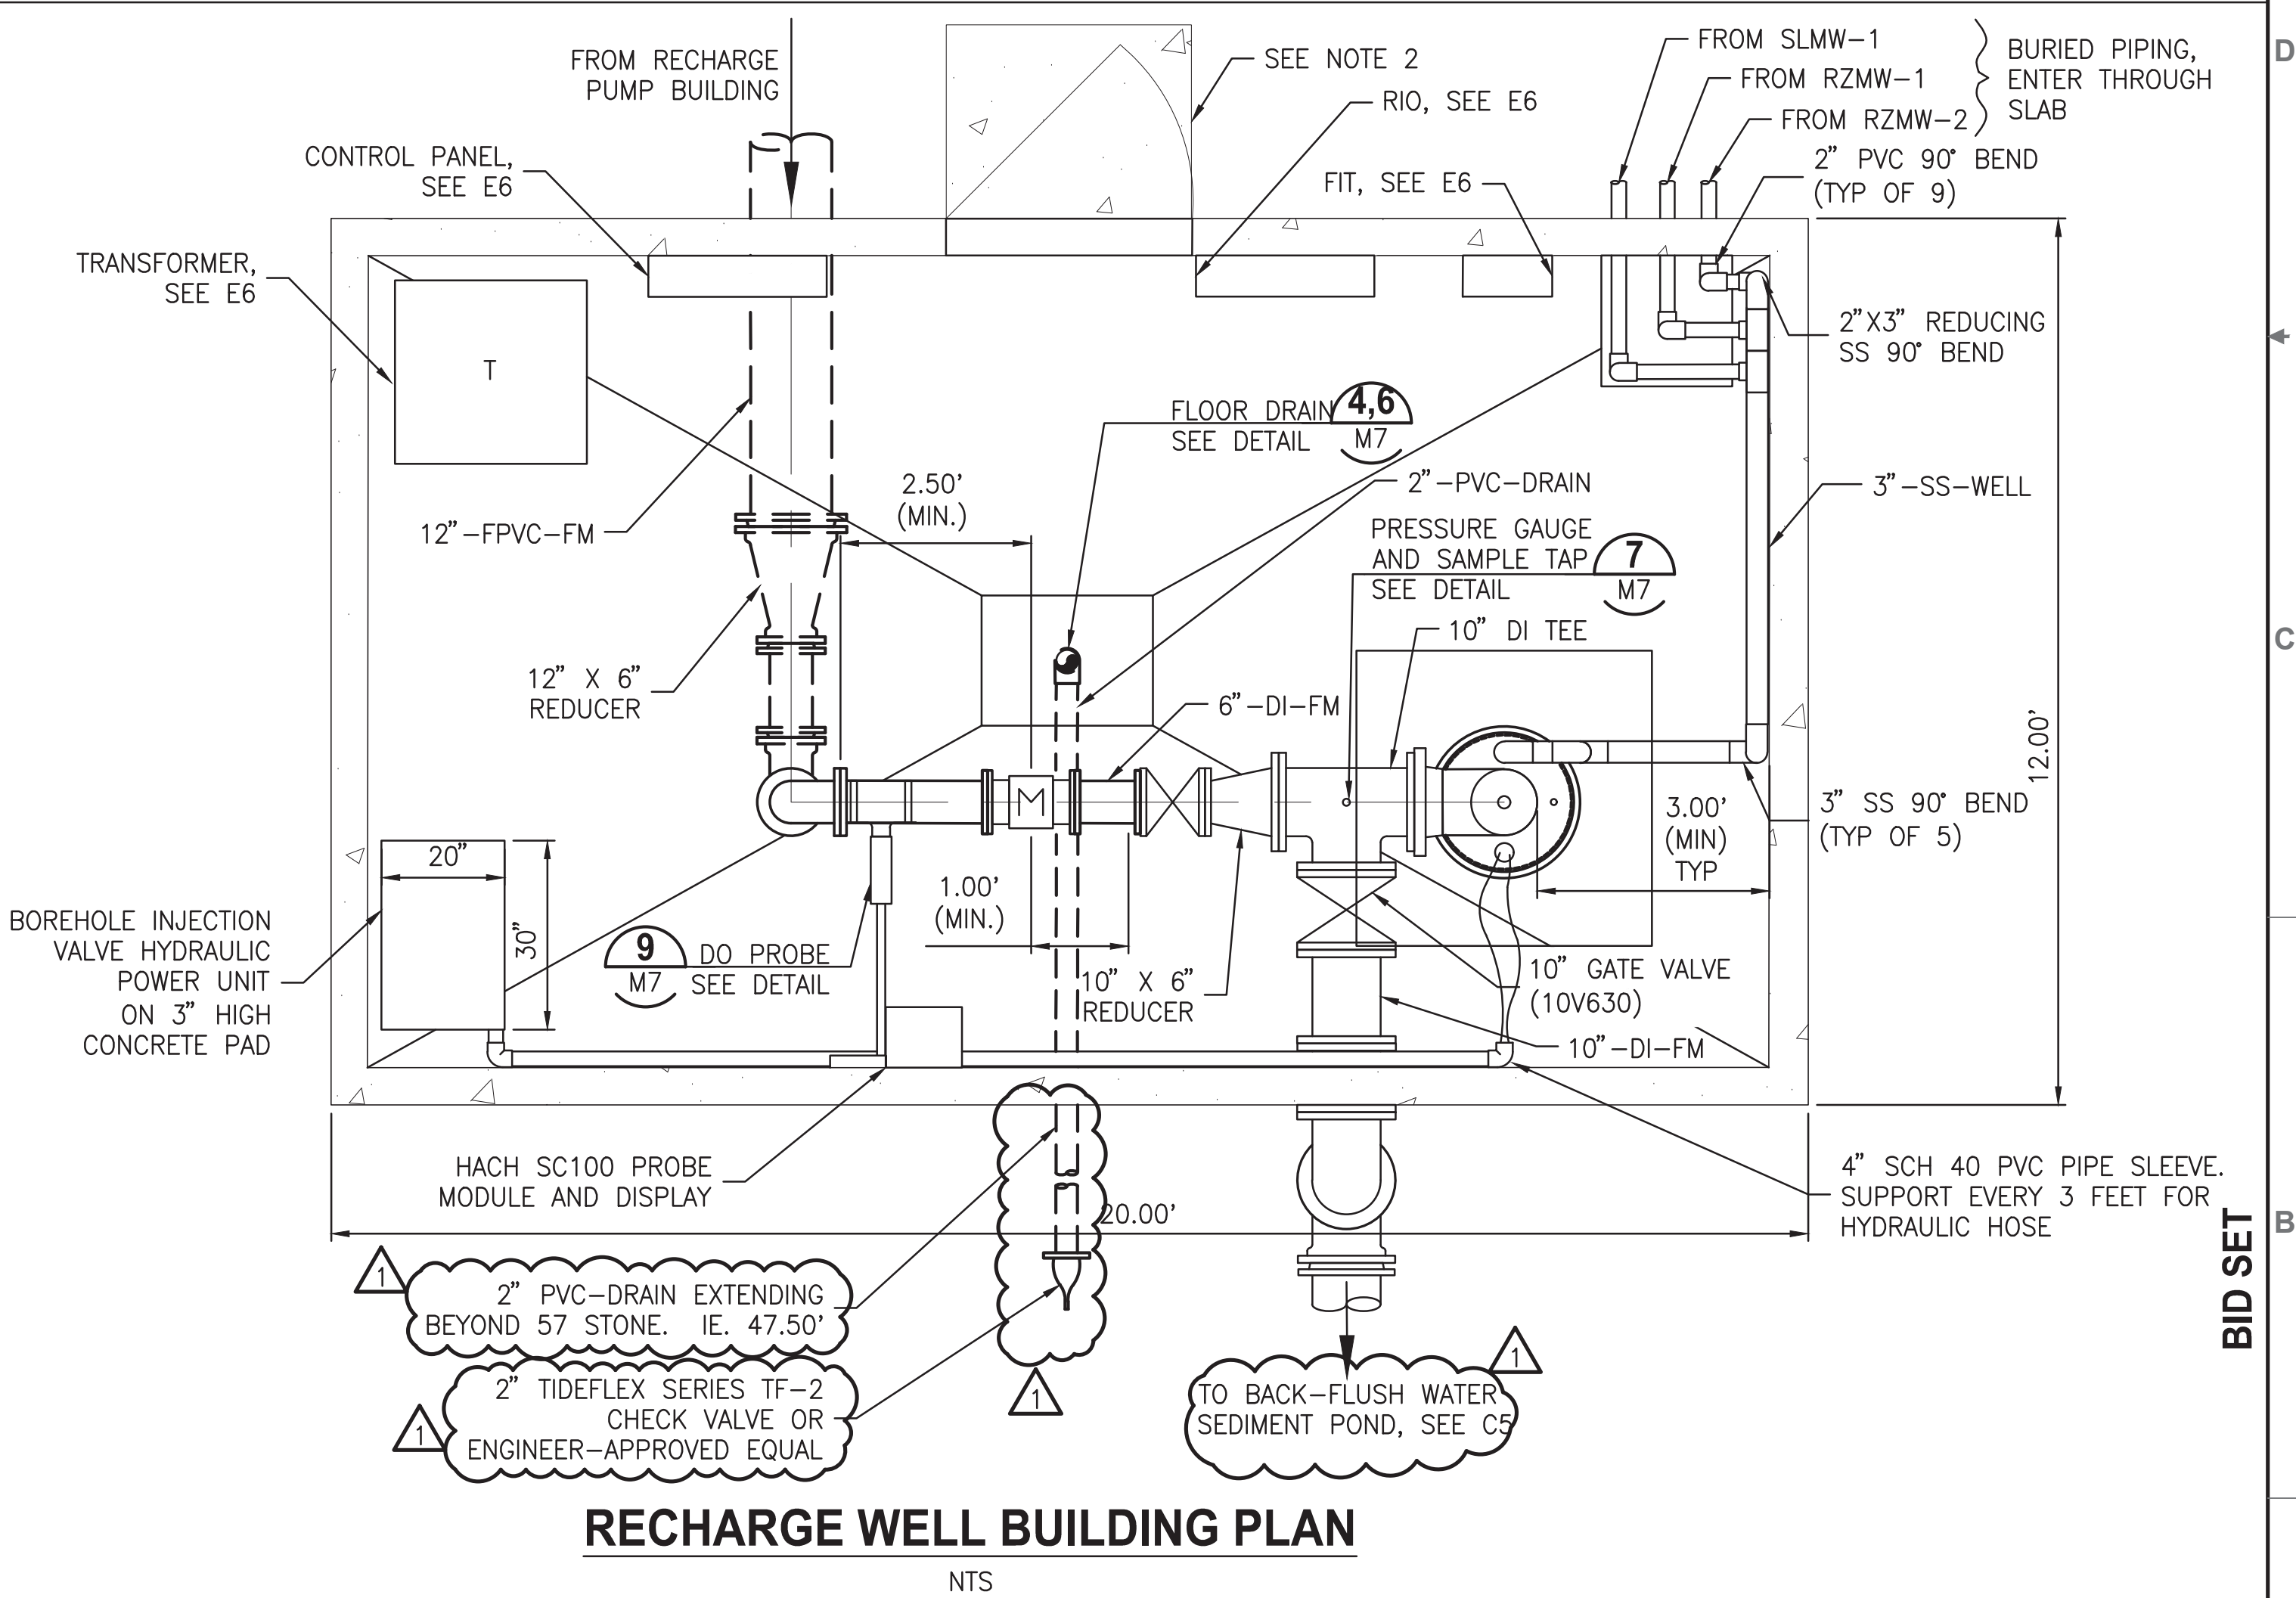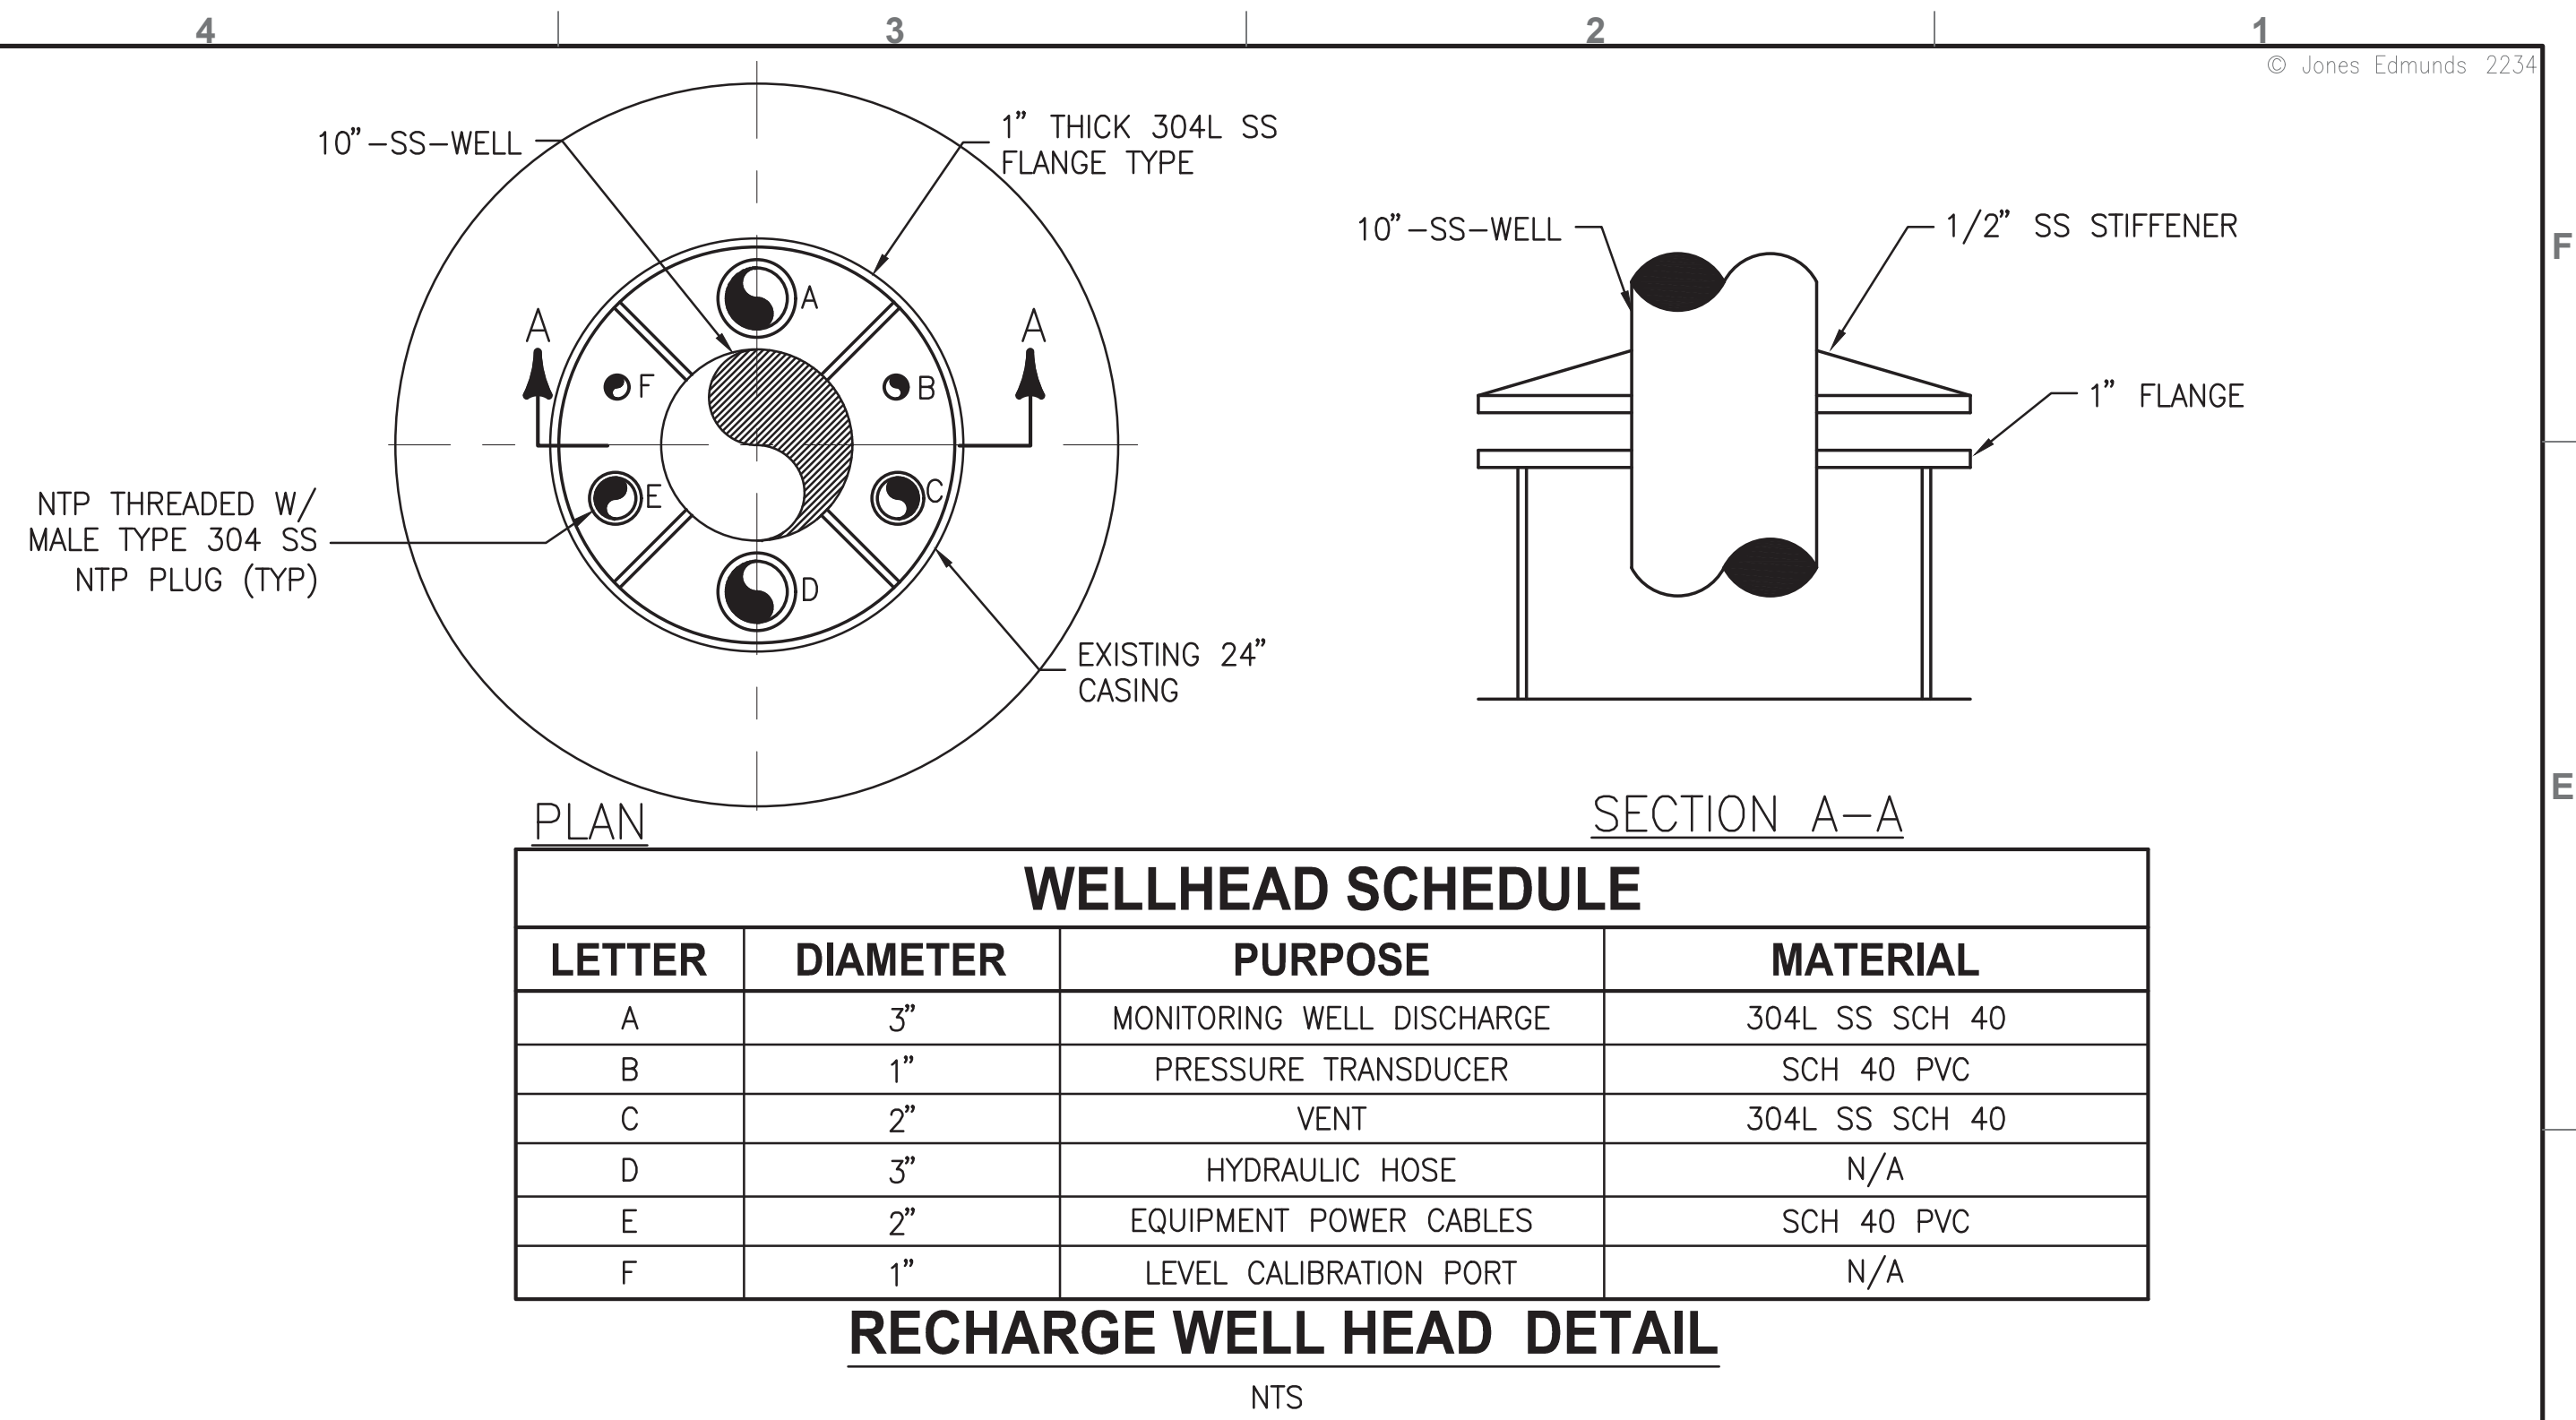


BID SET

10/1/2019 6:05 PM CAUTODESK Y:\19850-SWFWM\PROJECTS\041-01_FLATFORD SWAMP AQUIFER RECHARGE\CAD\DWGS\MECH\1985004101-M04.DWG

8 7 6 5 4 3 2 1
 PLOTTED: 1/20/2020 10:13 AM JOHN KRAMER

© Jones Edmunds 2234

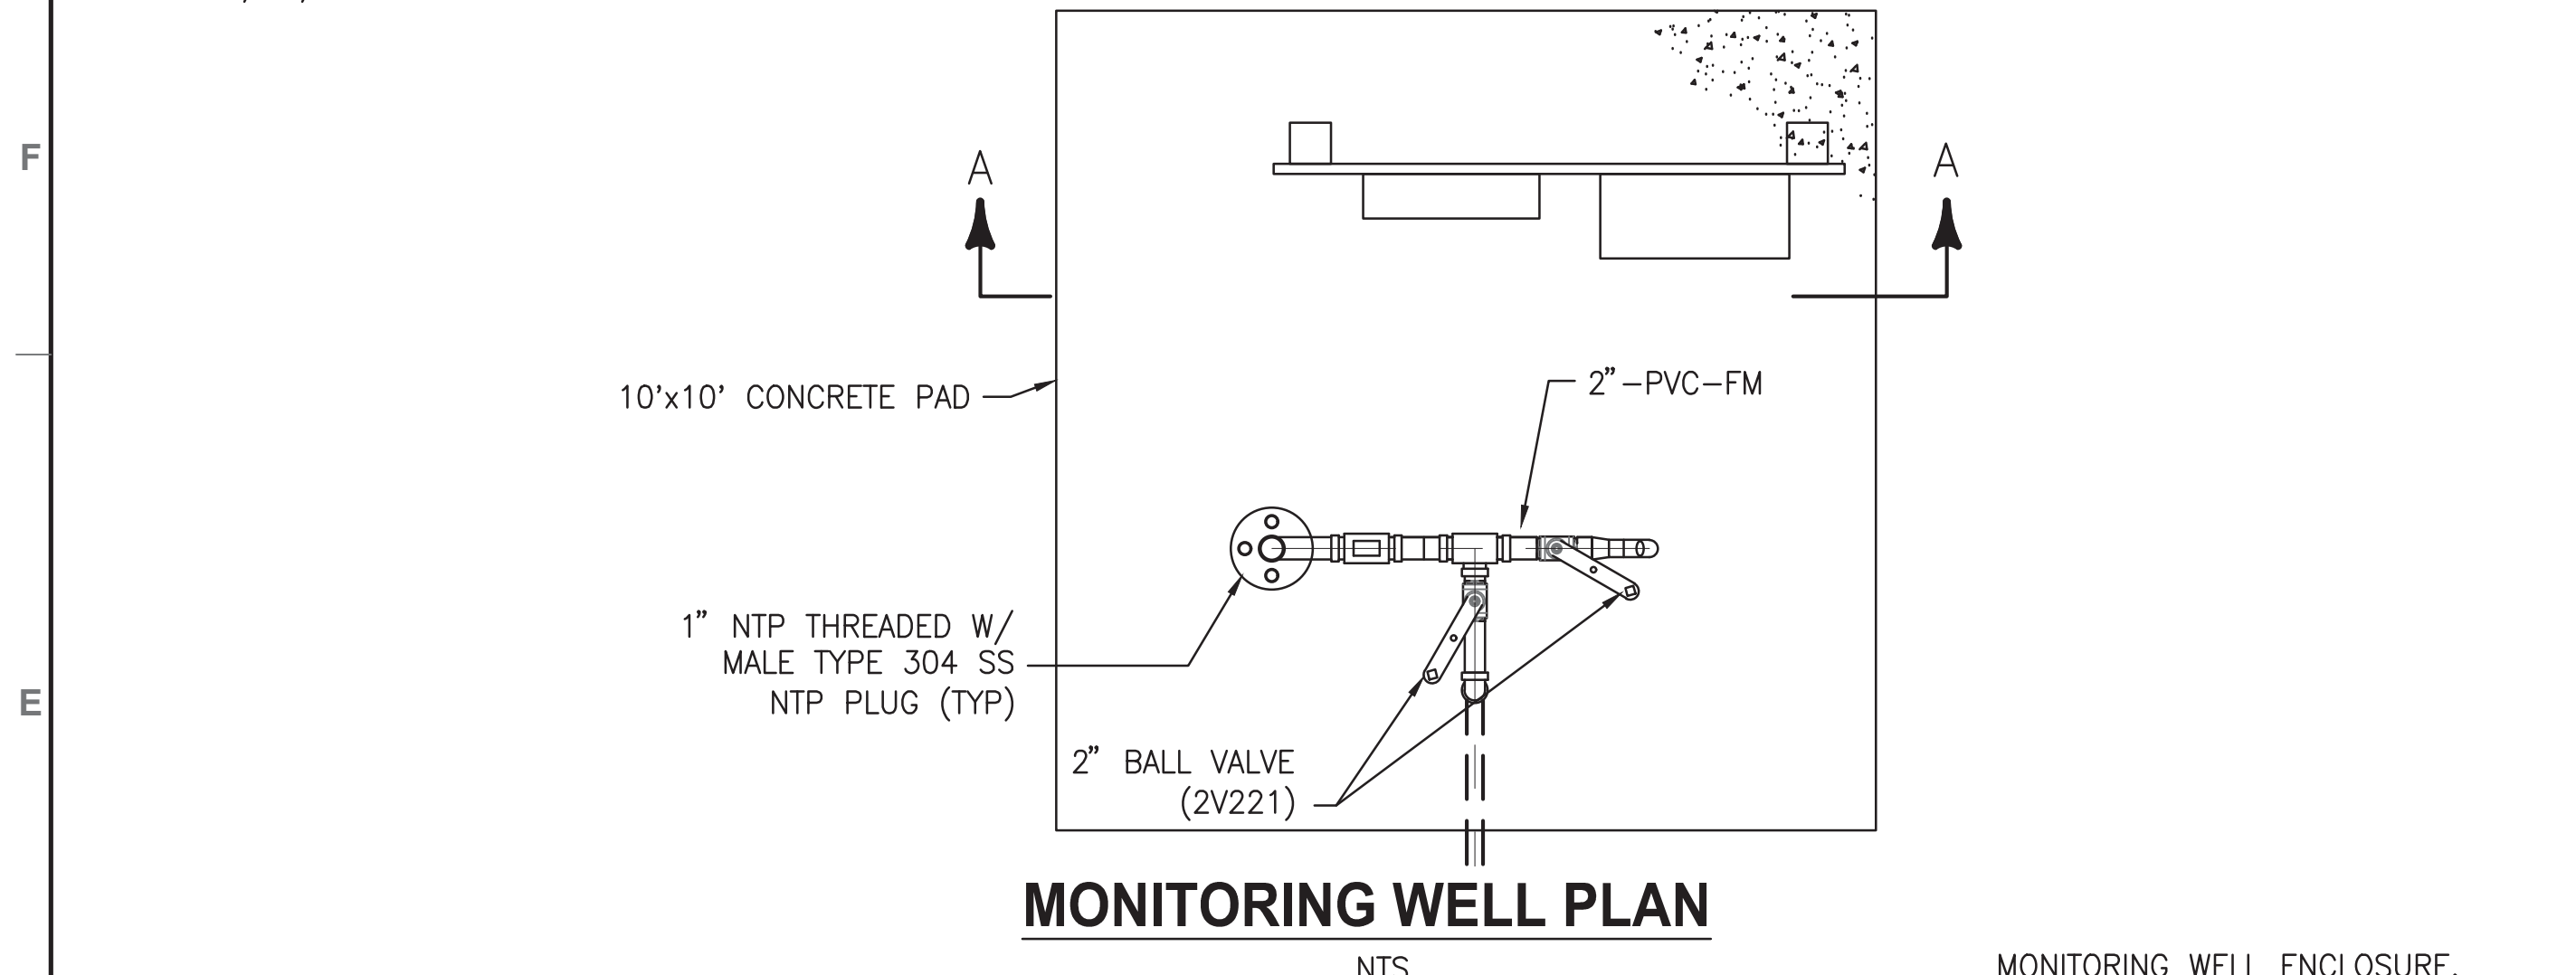


SLMW-1		
NAME	DIAMETER (OD/ID) INCHES	DEPTH FEET
20-INCH WELL CASING	20.00/20.25	60
14-INCH WELL CASING	14.00/13.25	350
6-INCH WELL CASING	6.625/5.875	450
PRESSURE TRANSDUCER	0.84	100
GRUNDFOS MODEL 62S 10-3 DESIGN POINT 50 GPM @ 60' TDH	3.98	450

RZMW-1		
NAME	DIAMETER (OD/ID) INCHES	DEPTH FEET
20-INCH WELL CASING	20.00/20.25	60
14-INCH WELL CASING	14.00/13.25	350
6-INCH WELL CASING	6.625/5.875	950
PRESSURE TRANSDUCER	0.84	100
GRUNDFOS MODEL 62S 30-7 DESIGN POINT 50 GPM @ 115' TDH	3.98	950

RZMW-2		
NAME	DIAMETER (OD/ID) INCHES	DEPTH FEET
20-INCH WELL CASING	20.00/20.25	60
14-INCH WELL CASING	14.00/13.25	350
6-INCH WELL CASING	6.625/5.875	950
PRESSURE TRANSDUCER	0.84	100
GRUNDFOS MODEL 62S 50-9 DESIGN POINT 50 GPM @ 175' TDH	3.98	950

NOTES:

- CONTRACTOR TO FIELD VERIFY ALL MEASUREMENTS AND ELEVATIONS.
- THE SUBMERSIBLE SAMPLING PUMP SHALL BE RATED AS DEFINED IN THE RESPECTIVE TABLE, OR ENGINEER APPROVED EQUAL.
- FIELD VERIFY PUMP CABLE LENGTH FROM MOTOR TO JUNCTION BOX PRIOR TO INSTALLATION (NO SPLICES WILL BE ACCEPTED).
- STRAP PUMP CABLE TO PIPE COLUMN AT 5' INTERVALS WITH NYLON STRAPS.
- PROVIDE 1" HEX SHOULDER STILL COCK HOSE BIBB WITH A TEE HANDLE. HOSE BIBB TO HAVE 3/4" MALE NPT THREADING HOSE BARB FOR SPLITTER CONNECTION FOR PURGE PIPING AND TUBING FOR FLOW-THROUGH CELL FOR FIELD SAMPLING.
- ENSURE WATER TIGHT SEALING. PROVIDE STRAIGHT MALE CORD CONNECTOR.
- ALL MONITORING WELLS SHALL HAVE A 12-INCH THICK LAYER OF #57 STONE EXTENDING A MINIMUM OF 10 FEET FROM ANY ABOVEGROUND CONCRETE SURFACE. THE STONE SHALL BE RESTING ON FILTER FABRIC.
- MONITORING WELL ENCLOSURE SHALL BE PER THE SOUTHWEST FLORIDA WATER MANAGEMENT DISTRICT STANDARDS. CONTRACTOR SHALL COORDINATE WITH DISTRICT-SUPPLIED CONTACT FROM DAY METAL PRODUCTS.
- CONTRACTOR TO INSTALL OWNER-PROVIDED TRANSDUCER AND DATA LOGGER FOR EACH OF THE THREE (3) MONITORING WELLS.

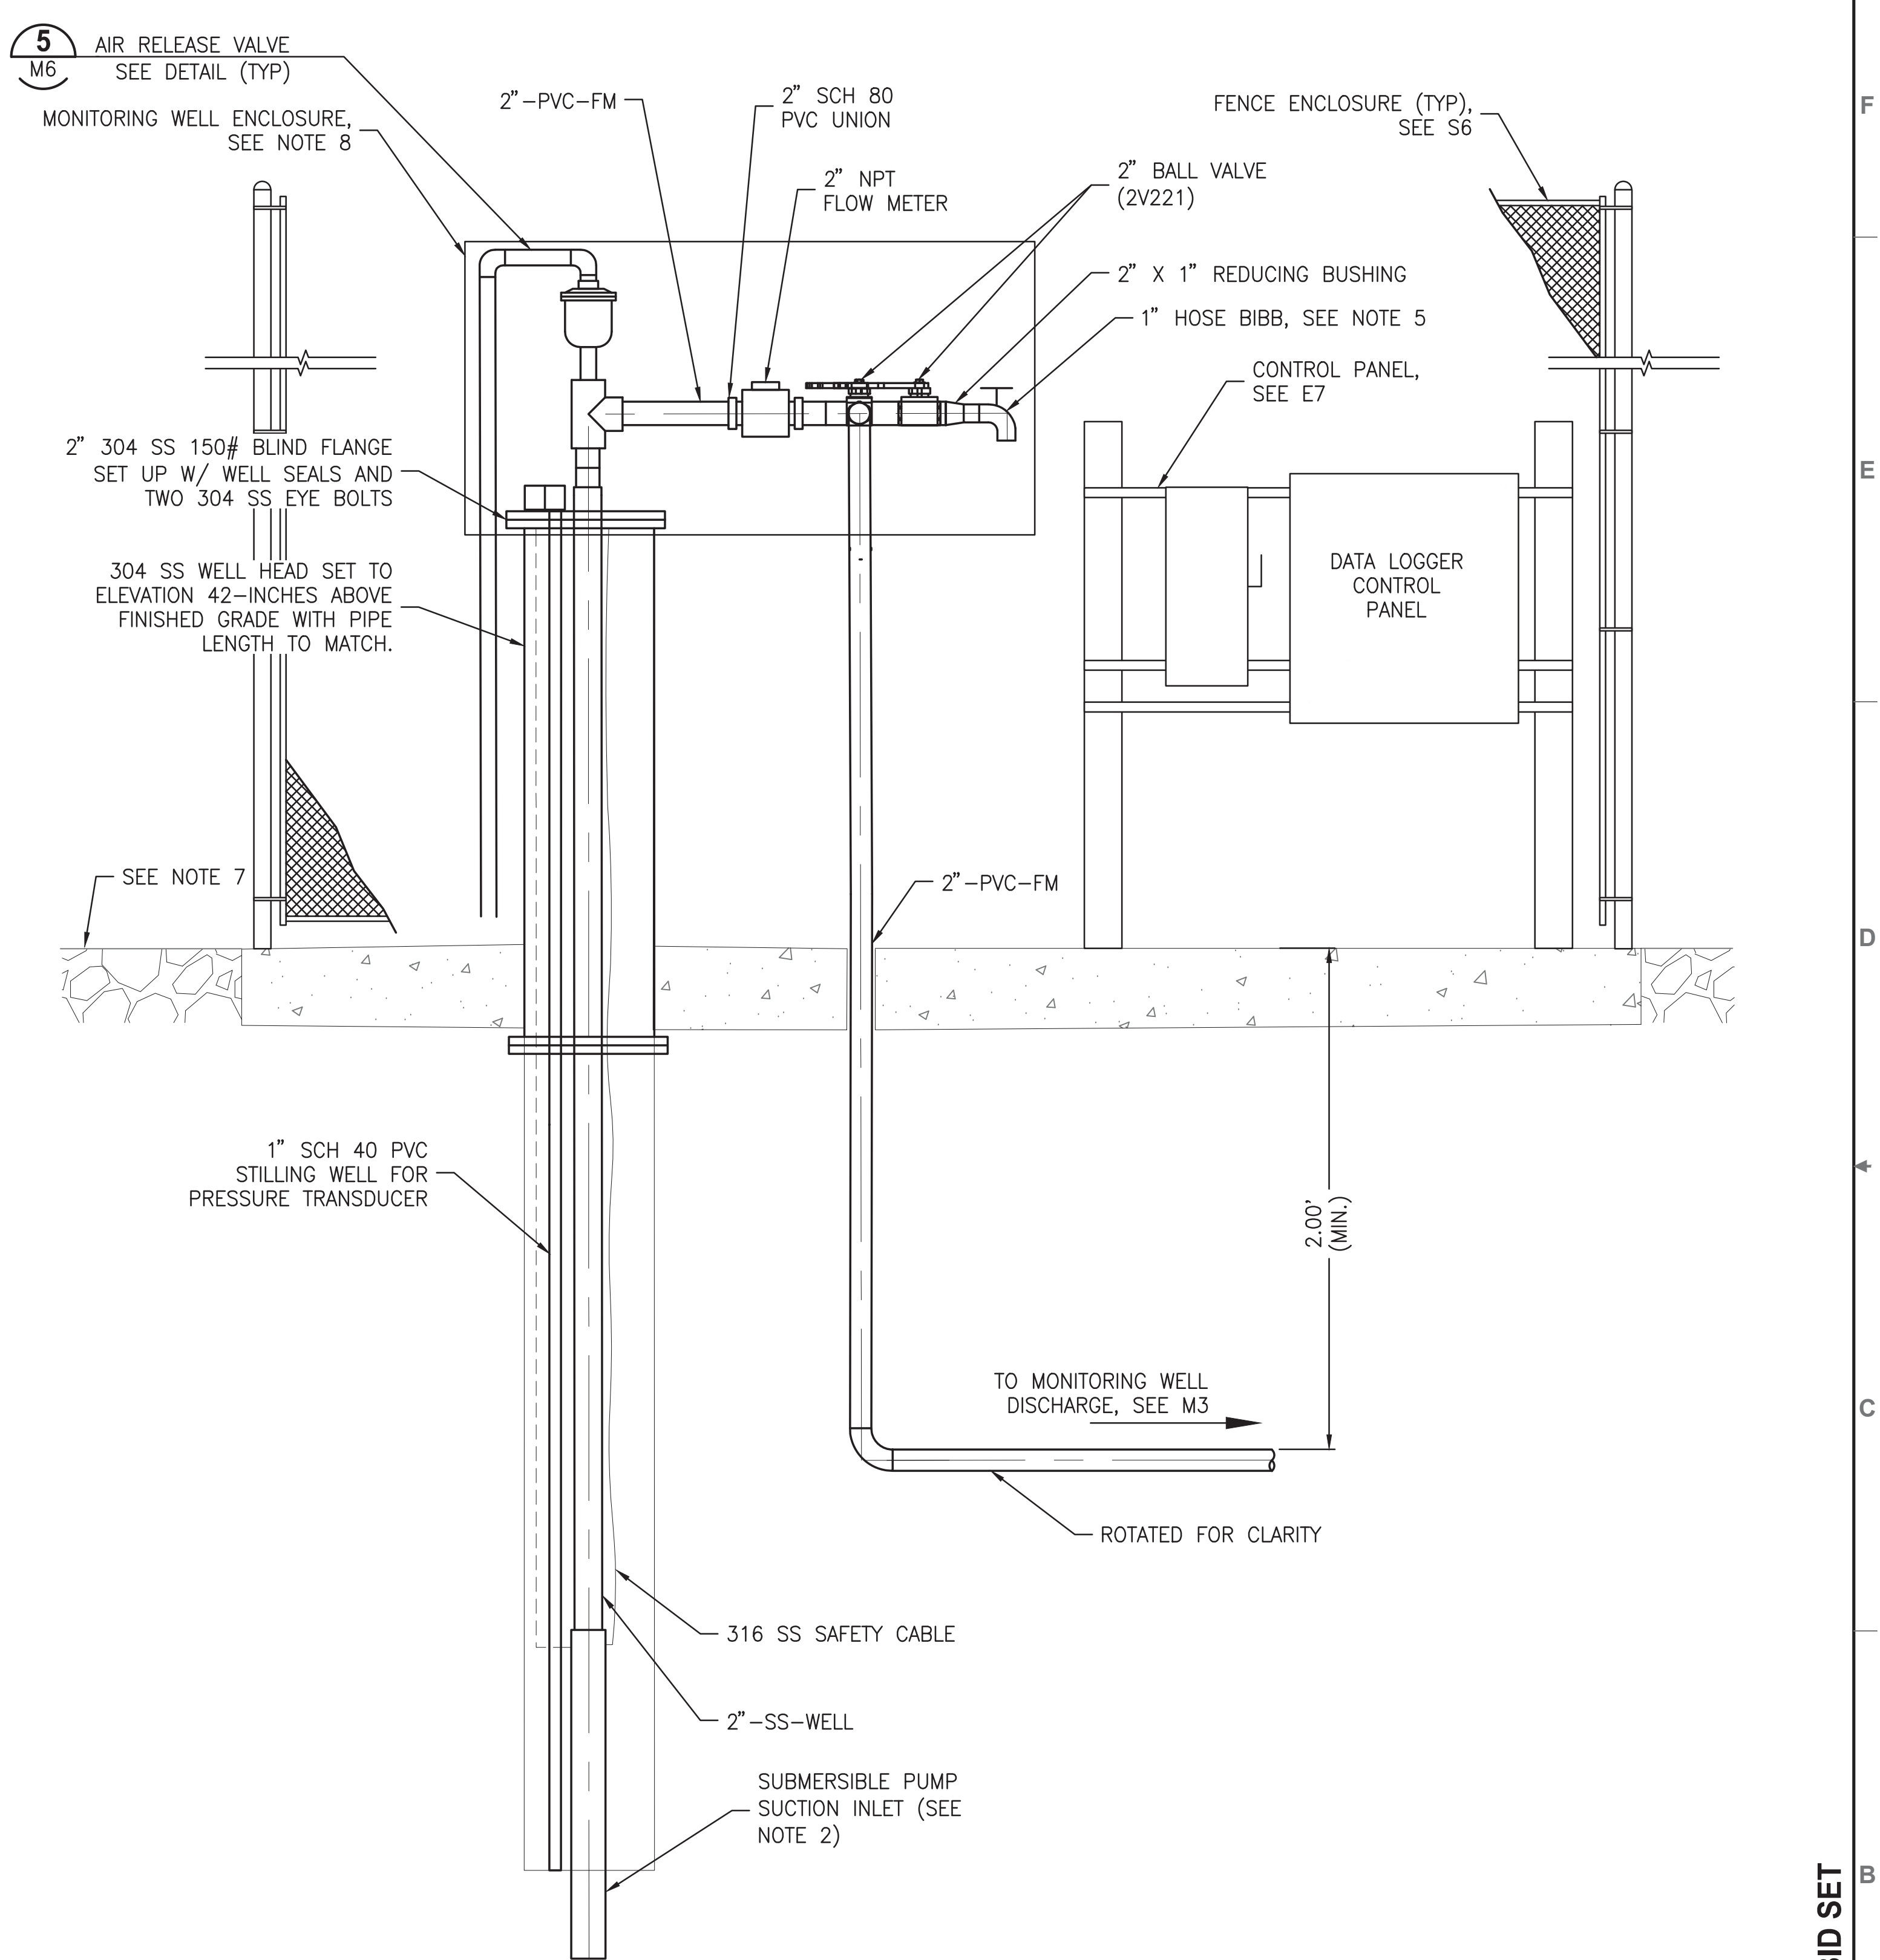

MONITORING WELL SECTION A-A

NTS

					DESIGNED	SMENARD
					DRAWN	JKRAMER
					CHECKED	DYONGE
LTR.	DATE	REVISIONS	BY	APPRD.		

JonesEdmunds
 CERTIFICATE OF AUTHORIZATION #1841
 730 NE WALDO ROAD, GAINESVILLE, FLORIDA 32641 / (352) 377-5821
 324 S HYDE PARK AVE, SUITE 250, TAMPA, FLORIDA 33606 / (813) 258-0703

AQUIFER RECHARGE AT FLATFORD SWAMP
 SOUTHWEST FLORIDA WATER MANAGEMENT DISTRICT


MONITORING WELL PLAN AND SECTION

APPROVED BY	PROJECT NO:	DATE:
THOMAS W. FRIEDRICH	19850-041-01	SEP. 2019
P.E. 61281	INDEX NO:	DWG NO:
		M4

8
 7
 6
 5
 4
 3
 2
 1
 F
 E
 D
 C
 B
 A
 10/1/2019 6:06 PM CAUTODESK Y:\19850-SWFWM\PROJECTS\041-01_FLATFORD_SWAMP_AQUIFER_RECHARGE\CAD\DWGS\MECH\1985004101-M05.DWG

PLOTTED: 1/20/2020 10:13 AM JOHN KRAMER

© Jones Edmunds 2234

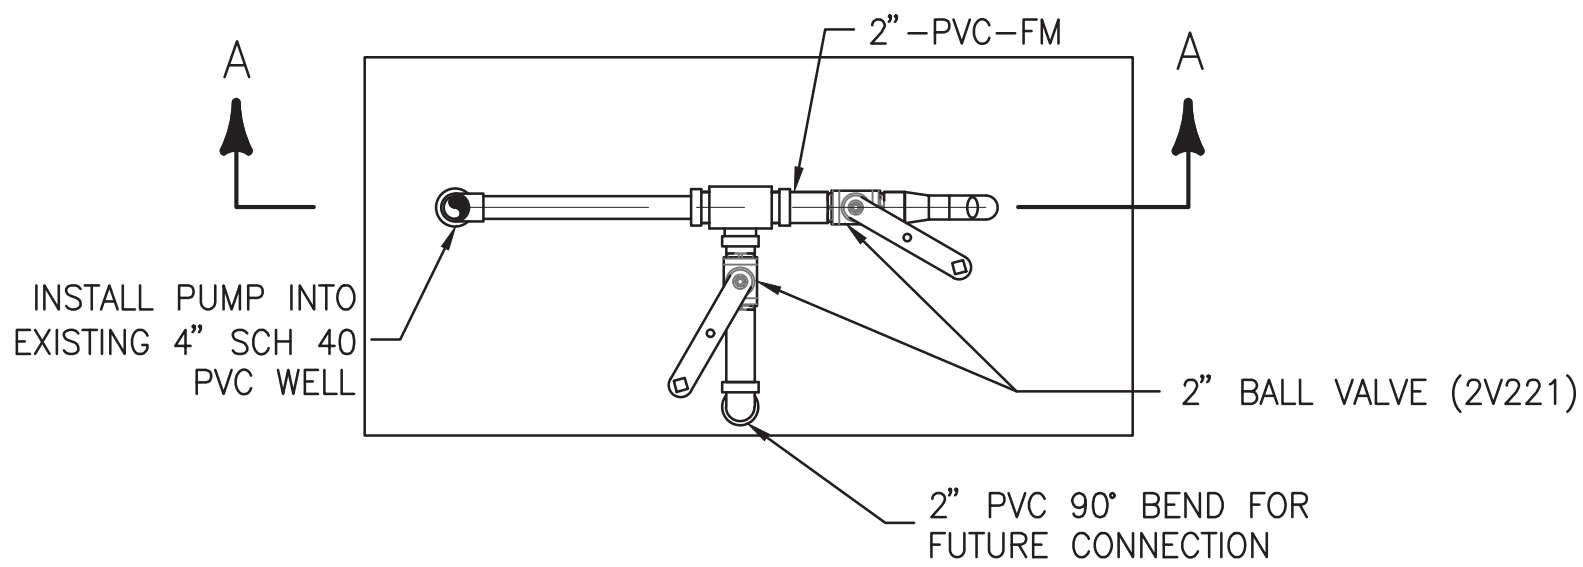

SUPPLY WELL PLAN

NTS




SUPPLY WELL PHOTO DETAIL

NTS

NOTES:

1. CONTRACTOR TO FIELD VERIFY ALL MEASUREMENTS AND ELEVATIONS.
2. THE SUBMERSIBLE SAMPLING PUMP SHALL BE 50' BLS FOR THE SUPPLY WELL. PUMP SHALL BE GRUNDFOS 22 SQ15-220 SERIES, WITH DESIGN POINT 20 GPM @ 254' TDH, OR ENGINEER APPROVED EQUAL.
3. FIELD VERIFY PUMP CABLE LENGTH FROM MOTOR TO JUNCTION BOX PRIOR TO INSTALLATION (NO SPLICES WILL BE ACCEPTED).
4. STRAP PUMP CABLE TO PIPE COLUMN AT 5' INTERVALS WITH NYLON STRAPS.
5. PROVIDE 1" HEX SHOULDER STILL COCK HOSE BIBB WITH A TEE HANDLE. HOSE BIBB TO HAVE MALE NPT THREADING FOR 1" FEMALE HOSE CONNECTION.
6. ENSURE WATER TIGHT SEALING. PROVIDE STRAIGHT MALE CORD CONNECTOR.
7. THE SUPPLY WELL SHALL HAVE A 12-INCH THICK LAYER OF #57 STONE EXTENDING A MINIMUM OF 10 FEET FROM ANY ABOVEGROUND CONCRETE SURFACE. THE STONE SHALL BE RESTING ON FILTER FABRIC.

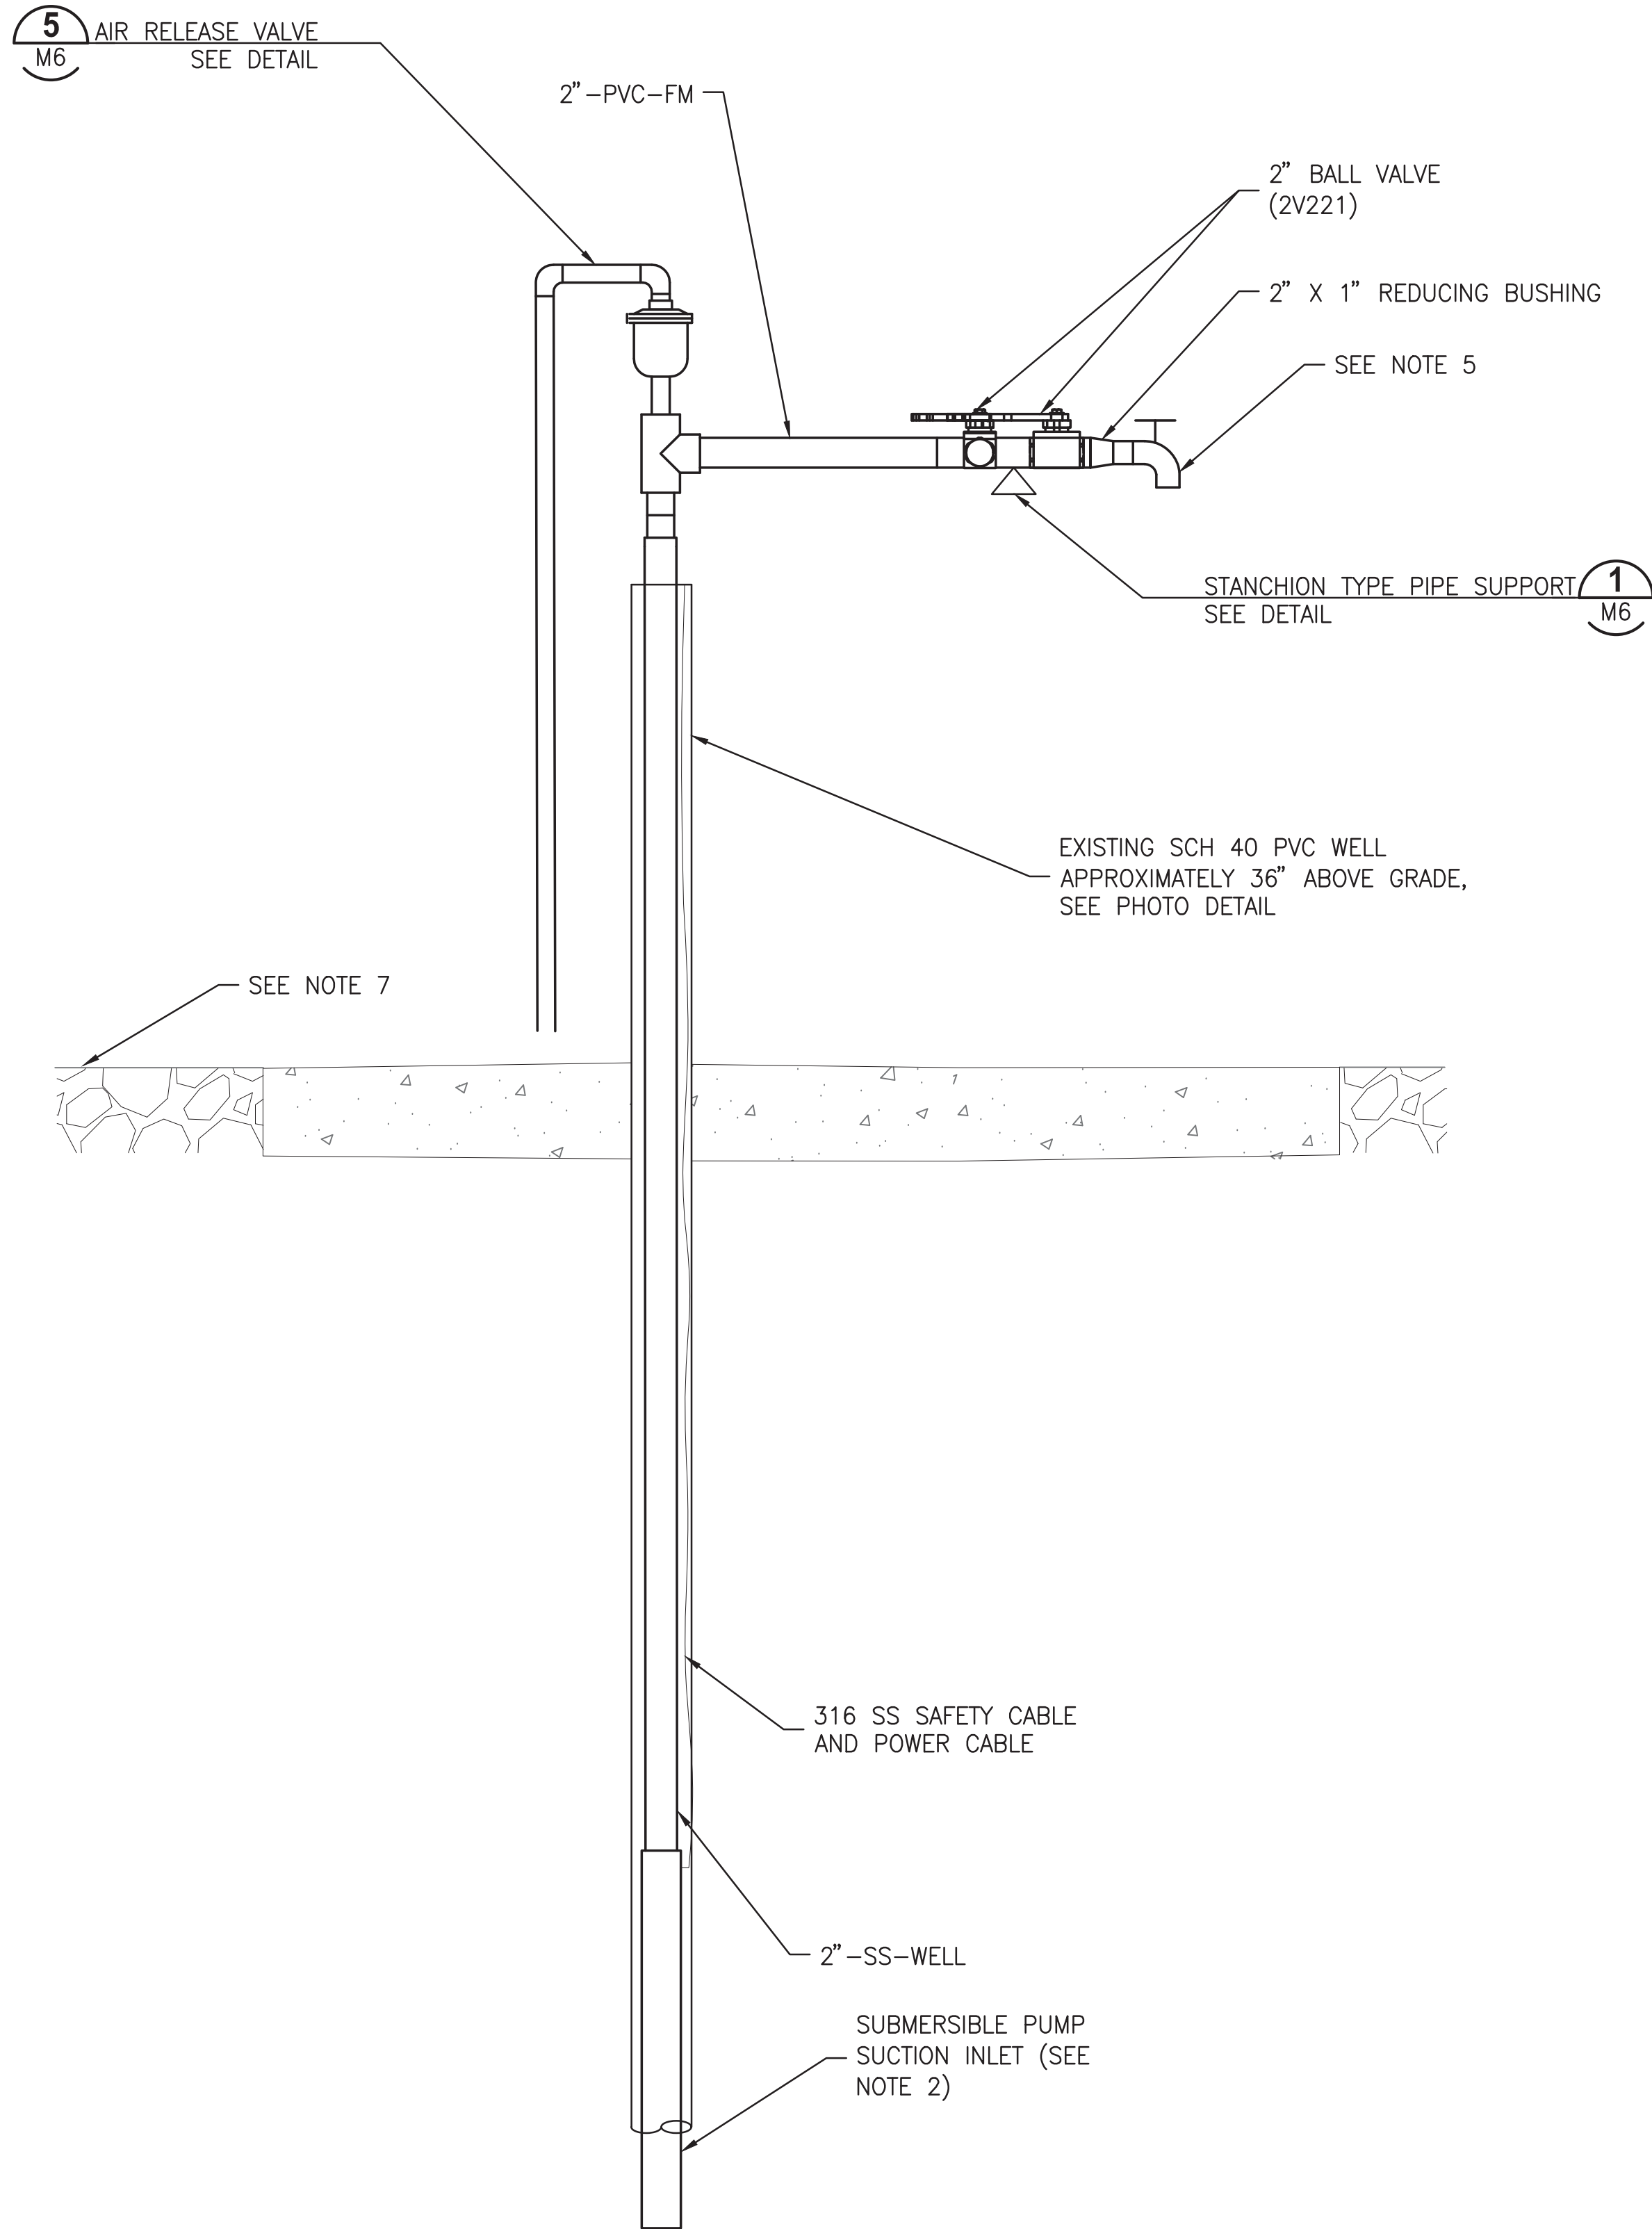

SUPPLY WELL SECTION A-A

NTS

LTR.	DATE	REVISIONS	BY	APPR.	CHECKED

DESIGNED SMENARD

DRAWN JKRAMER

CHECKED DYONGE

JonesEdmunds

CERTIFICATE OF AUTHORIZATION #1841
 730 NE WALDO ROAD, GAINESVILLE, FLORIDA 32641 / (352) 377-5821
 324 S HYDE PARK AVE, SUITE 250, TAMPA, FLORIDA 33606 / (813) 258-0703

AQUIFER RECHARGE AT FLATFORD SWAMP
 SOUTHWEST FLORIDA WATER MANAGEMENT DISTRICT

SUPPLY WELL PLAN AND SECTION

APPROVED BY

THOMAS W. FRIEDRICH
 P.E. 61281

PROJECT NO:
 19850-041-01

INDEX NO:

DATE:
 SEP. 2019


DWG NO:

M5

BID SET

8
 7
 6
 5
 4
 3
 2
 1
 F
 E
 D
 C
 B
 A
 Y:\19850-SWFWMD\PROJECTS\041-01_FLATFORD SWAMP AQUIFER RECHARGE\CAD\DWGS\MECH\1985004101-M06.DWG
 8/30/2019 9:17 AM RMEADOWS
 8
 7
 6
 5
 4
 3
 2
 1
 F
 E
 D
 C
 B
 A

PLOTTED: 1/20/2020 10:13 AM JOHN KRAMER

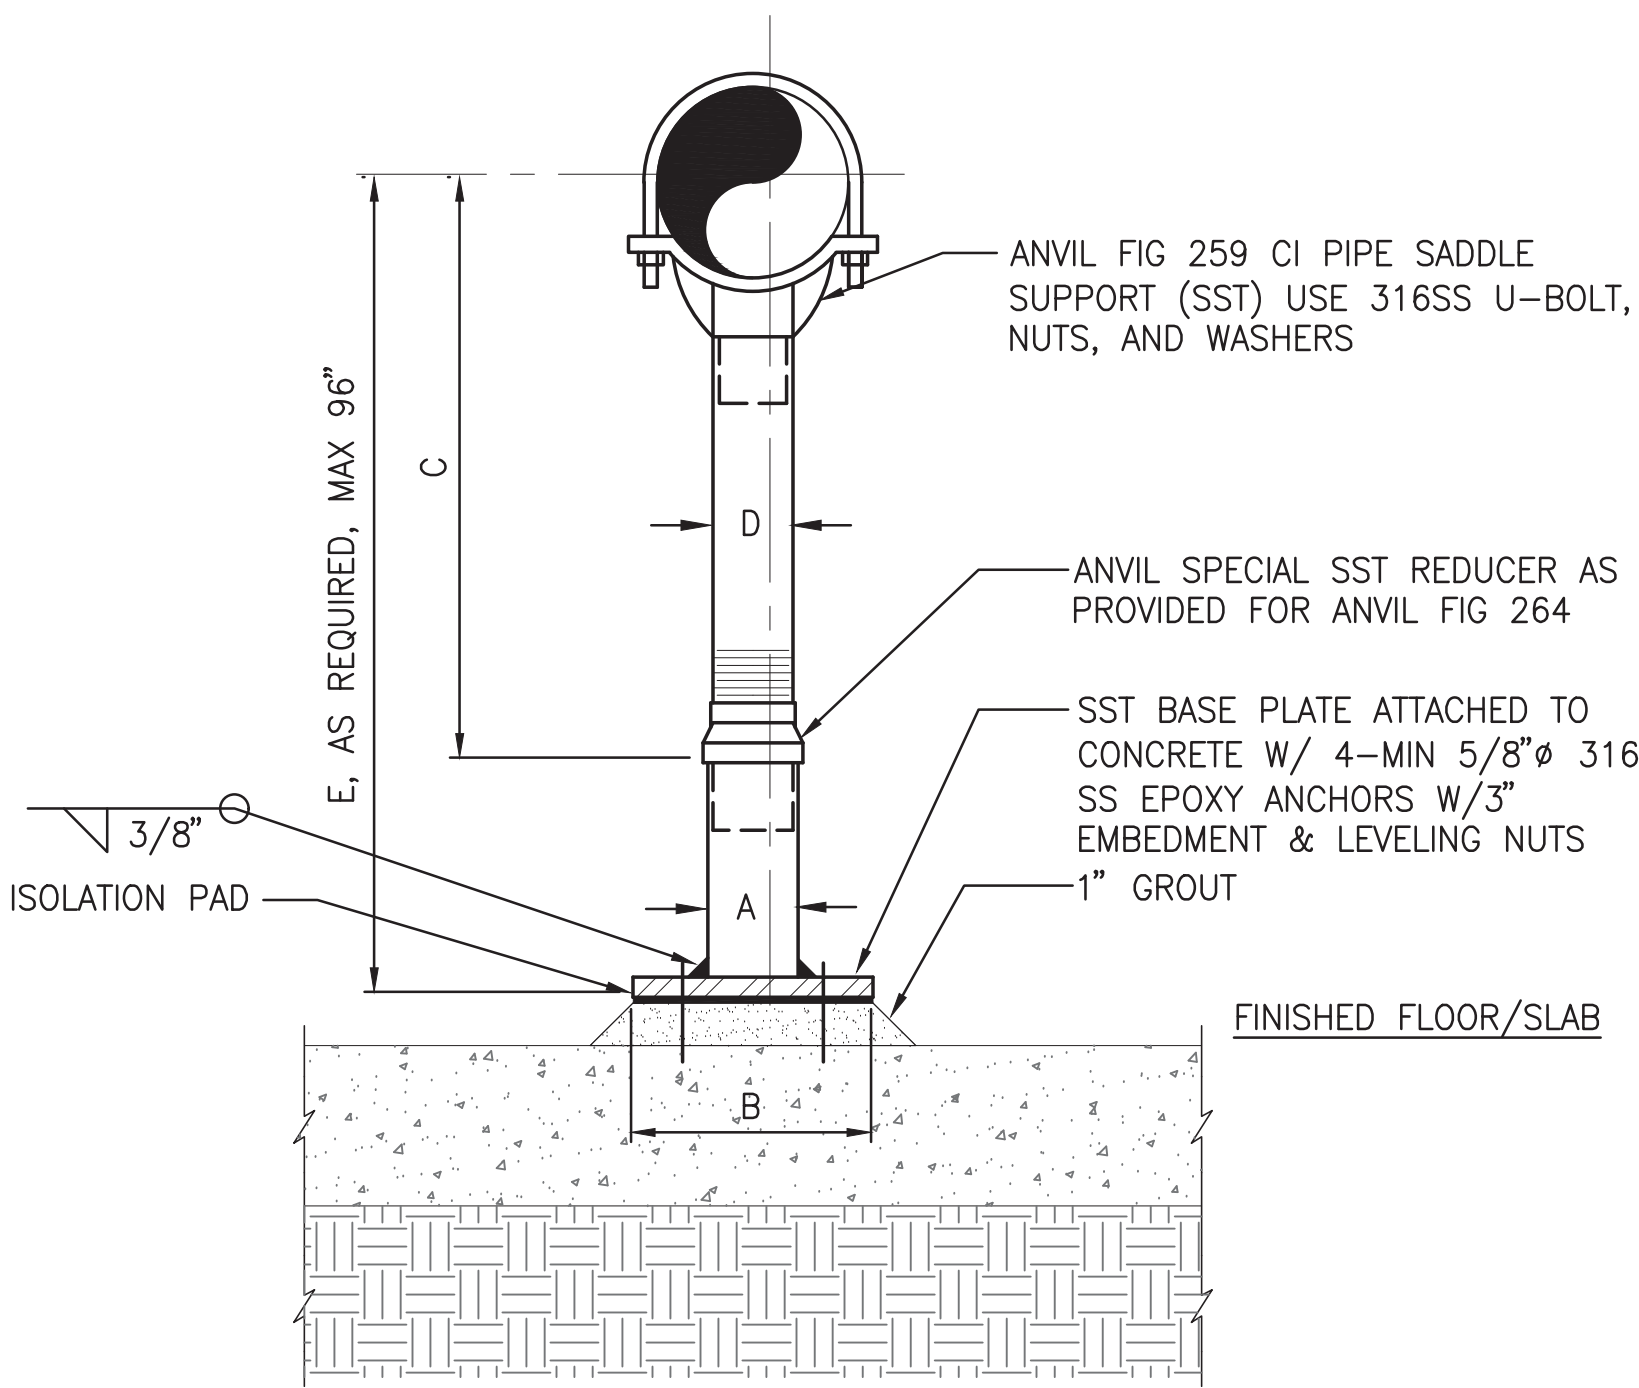


TYPICAL PIPE SUPPORT DIMENSION TABLE

PIPE SIZE	A	B	C		D
			MIN	MAX	
INCHES					
6	4	9	10 1/2	15 1/4	3
12	4	9	15	19 3/4	3
24	6	13 1/2	23 3/4	28 1/4	4


NOTES:

- SST (304 TYP) PIPE SUPPORT AND SST (304 TYP) BASE PLATE (WITH STAINLESS STEEL FASTENING HARDWARE).
- ALL HARDWARE SHALL BE 316 SS.
- PROVIDE NEOPRENE WAFFLE ISOLATION PAD, KORFUND KORPAD 40 UNDER SUPPORT FOOT WHEN PIPING IS ISOLATED OR SUPPORT IS ADJACENT TO MECHANICAL EQUIPMENT.
- FOR BASE, AND COMPONENT DIMENSIONS, SEE PIPE SUPPORT DIMENSION TABLE ABOVE. ALL DIMENSIONS IN INCHES.
- SEE PLANS AND SECTIONS FOR PIPE CENTERLINE ELEVATION REQUIREMENTS (DIMENSION "E").
- BASE PLATES SHALL BE SQUARE AND BE (SST) 1/2-INCH THICK FOR PIPE SIZES THROUGH 10-INCH. FOR ALL LARGER PIPES BEING SUPPORTED, THE BASE PLATES SHALL BE 3/4-INCH (SST) THICK OR USE COMPANION FLANGE THREADED TO PIPE (SST).
- FOR PIPE SUPPORTS 2 1/2", 3", AND 3 1/2" USE ANVIL FIG 191. USE 3X 3X 3/8 WASHER W/ 3/4" HOLE AND BOTTOM SECTION OF TYPICAL PIPE SUPPORT.
- THE ANVIL MODEL NUMBERS PROVIDE THE QUALITY AND SIZING OF THE REQUIRED SUPPORTS, BUT NOT THE MATERIAL. THE MATERIAL IS TO BE 304 OR 316 STAINLESS STEEL. SUPPORTS SHALL BE FABRICATED OF SST AS REQUIRED AND THIS IS TYPICAL FOR ALL SUPPORTS AND HANGERS SHOWN IN THE PLANS AND DESCRIBED IN THE SPECIFICATIONS.

STANCHION TYPE SUPPORT DETAIL 1

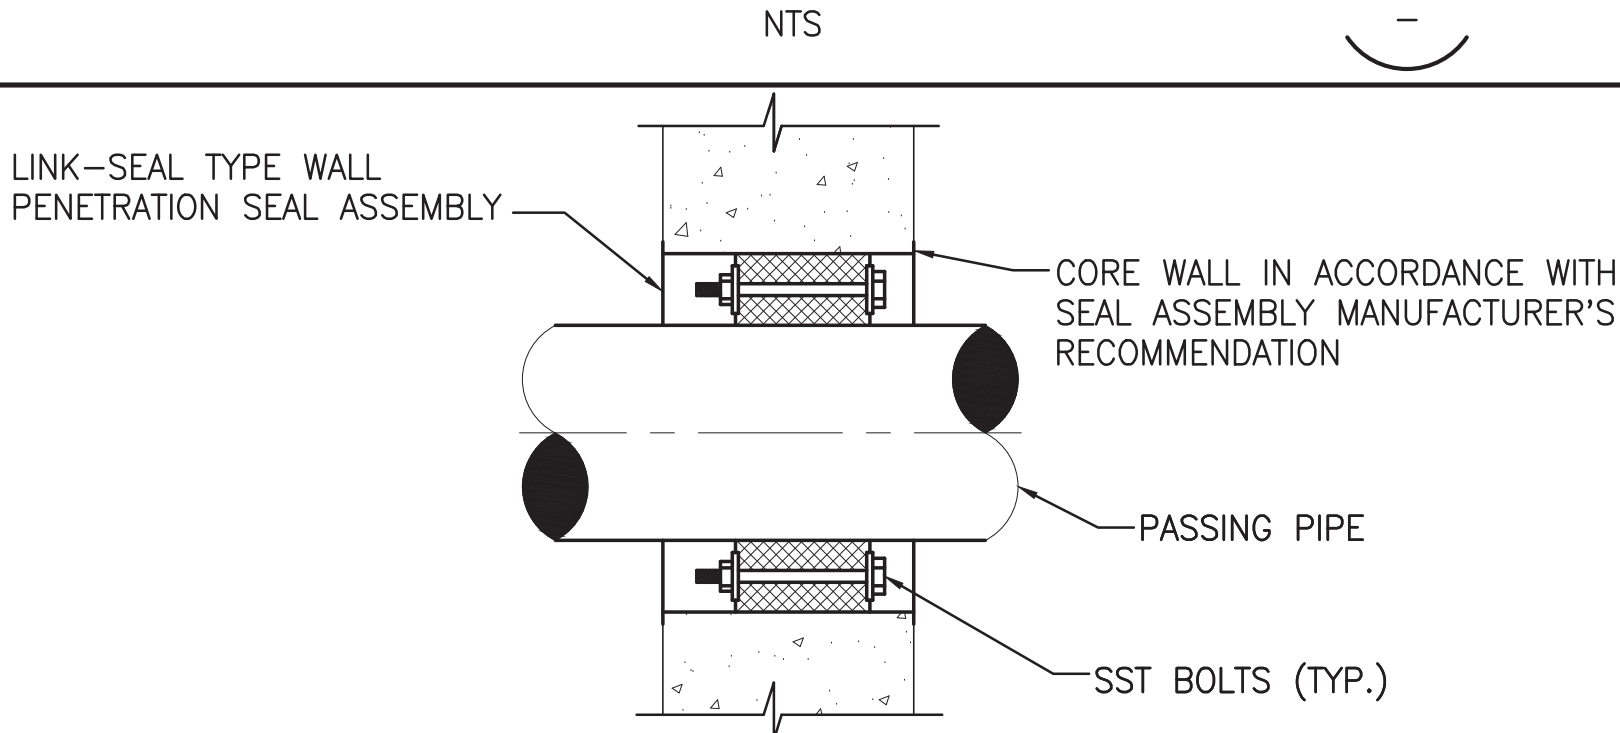


CONCRETE PENETRATION / SEAL DETAIL 2

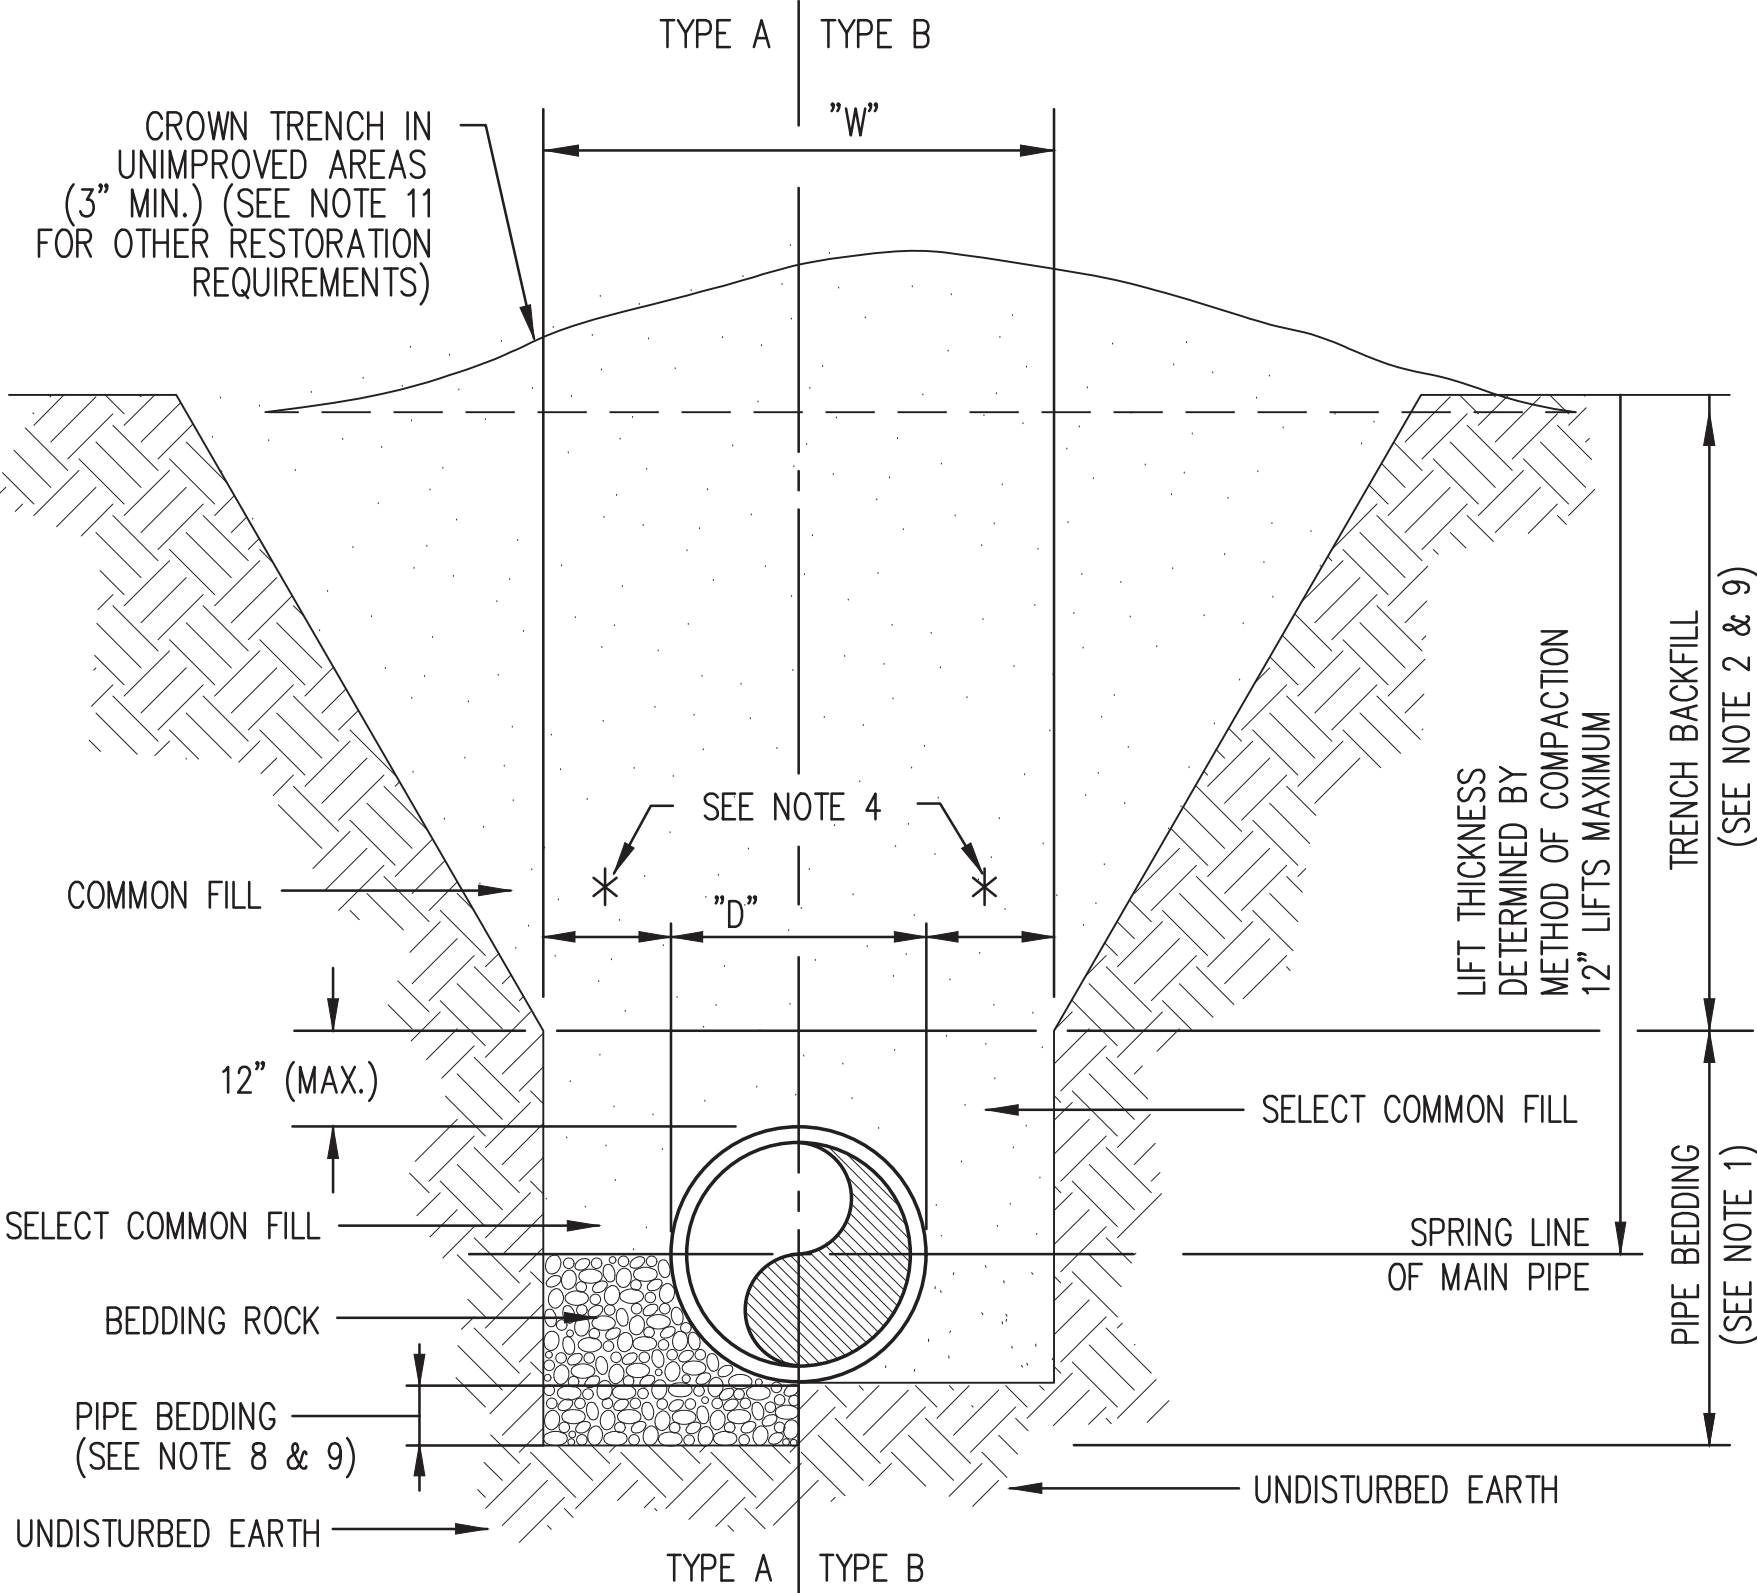

BEDDING AND TRENCHING DETAIL 3

BEDDING & TRENCHING NOTES:


- PIPE BEDDING: SELECT COMMON FILL COMPACTED TO 95% OF THE MAXIMUM DENSITY AS PER AASHTO T-180. COMPACTION SHALL BE 98% WITHIN 2' OF FINISHED ELEVATION UNDER ALL ROADWAYS, AND TO 2 LF BEHIND CONCRETE CURBS OR THE EDGE OF PAVEMENT.
- TRENCH BACKFILL: COMMON FILL COMPACTED TO 95% OF THE MAXIMUM DENSITY AS PER AASHTO T-180. COMPACTION SHALL BE 98% WITHIN 2' OF FINISHED ELEVATION UNDER ALL ROADWAYS, AND TO 2 LF BEHIND CONCRETE CURBS OR THE EDGE OF PAVEMENT.
- USE TYPE A BEDDING TO BE DETERMINED IN THE FIELD AS DIRECTED BY THE ENGINEER.
- 15" MAX. FOR PIPE DIAMETER LESS THAN 24", AND 24" MAX. FOR PIPE DIAMETER 24" AND LARGER.
- ALL NECESSARY MEASURES SHALL BE TAKEN TO KEEP THE TRENCH AS DRY AS POSSIBLE DURING CONSTRUCTION.
- ALL PIPE TO BE INSTALLED WITH BELL FACING UPSTREAM TO THE DIRECTION OF THE FLOW.
- REFER TO LAND DEVELOPMENT CODE FOR SHEETING AND BRACING IN EXCAVATIONS.
- GRAVITY PIPING SHALL UTILIZE TYPE A BEDDING. BEDDING DEPTH SHALL BE 4" MINIMUM FOR PIPE DIAMETER LESS THAN 15", AND 6" MINIMUM FOR PIPE DIAMETER 16" AND LARGER.
- THE ENGINEER MAY APPROVE ALTERNATE METHODS OF TRENCH BACKFILL COMPACTION ON A CASE BY CASE SITUATION.
- DEPTH FOR REMOVAL OF UNSUITABLE MATERIAL SHALL GOVERN DEPTH OF BEDDING ROCK BELOW THE PIPE. THE CITY SHALL DETERMINE IN THE FIELD REQUIRED REMOVAL OF UNSUITABLE MATERIAL TO REACH SUITABLE FOUNDATION.
- FINAL RESTORATION IN IMPROVED AREAS SHALL BE IN COMPLIANCE WITH ALL APPLICABLE REGULATIONS OF GOVERNING AGENCIES. SURFACE RESTORATION WITHIN THE COUNTY RIGHT-OF-WAY SHALL COMPLY WITH REQUIREMENTS OF RIGHT-OF-WAY UTILIZATION REGULATIONS AND ROAD CONSTRUCTION SPECIFICATIONS.

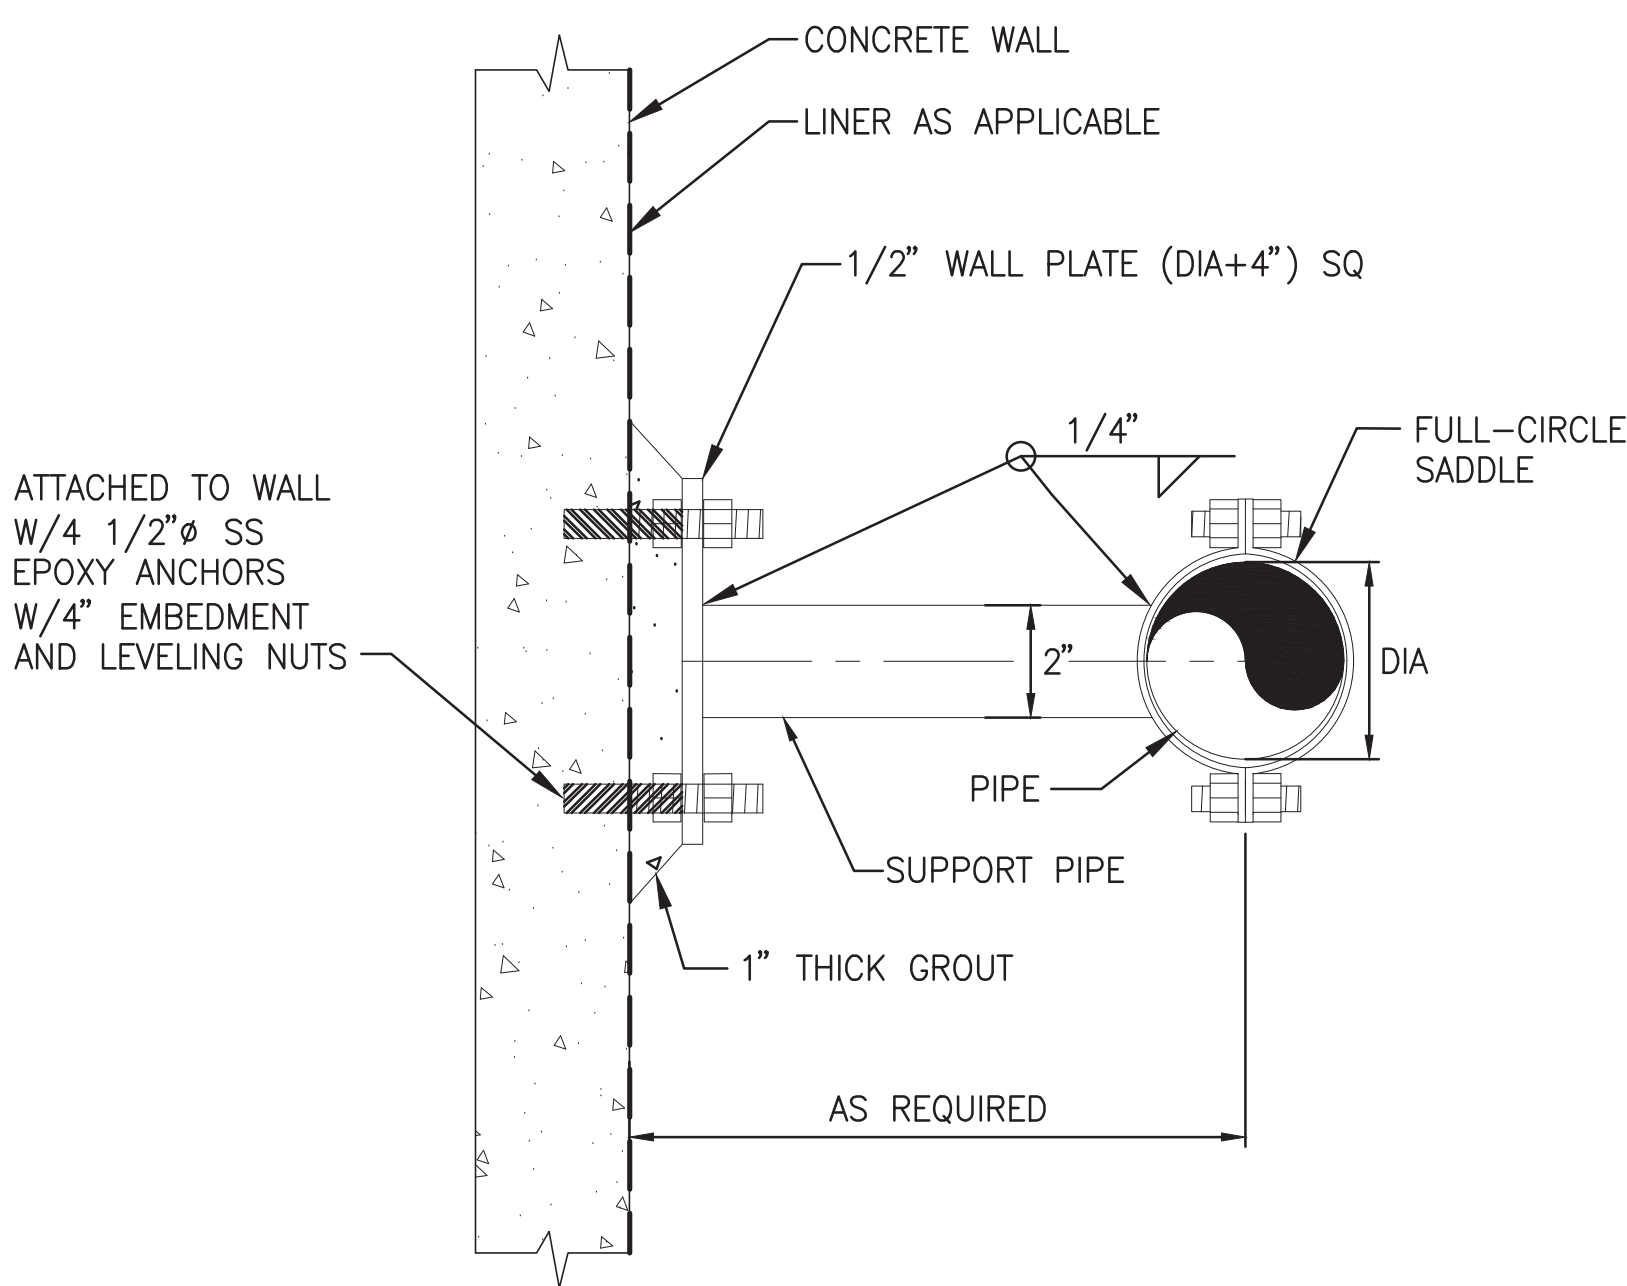

NOTES:

- ALL HARDWARE, PLATE, SADDLE, PIPE SUPPORT, ETC, SHALL BE 316 SERIES SS.
- SUPPORT PIPE SHALL BE SCH 40.

WALL-MOUNTED PIPE SUPPORT DETAIL 4

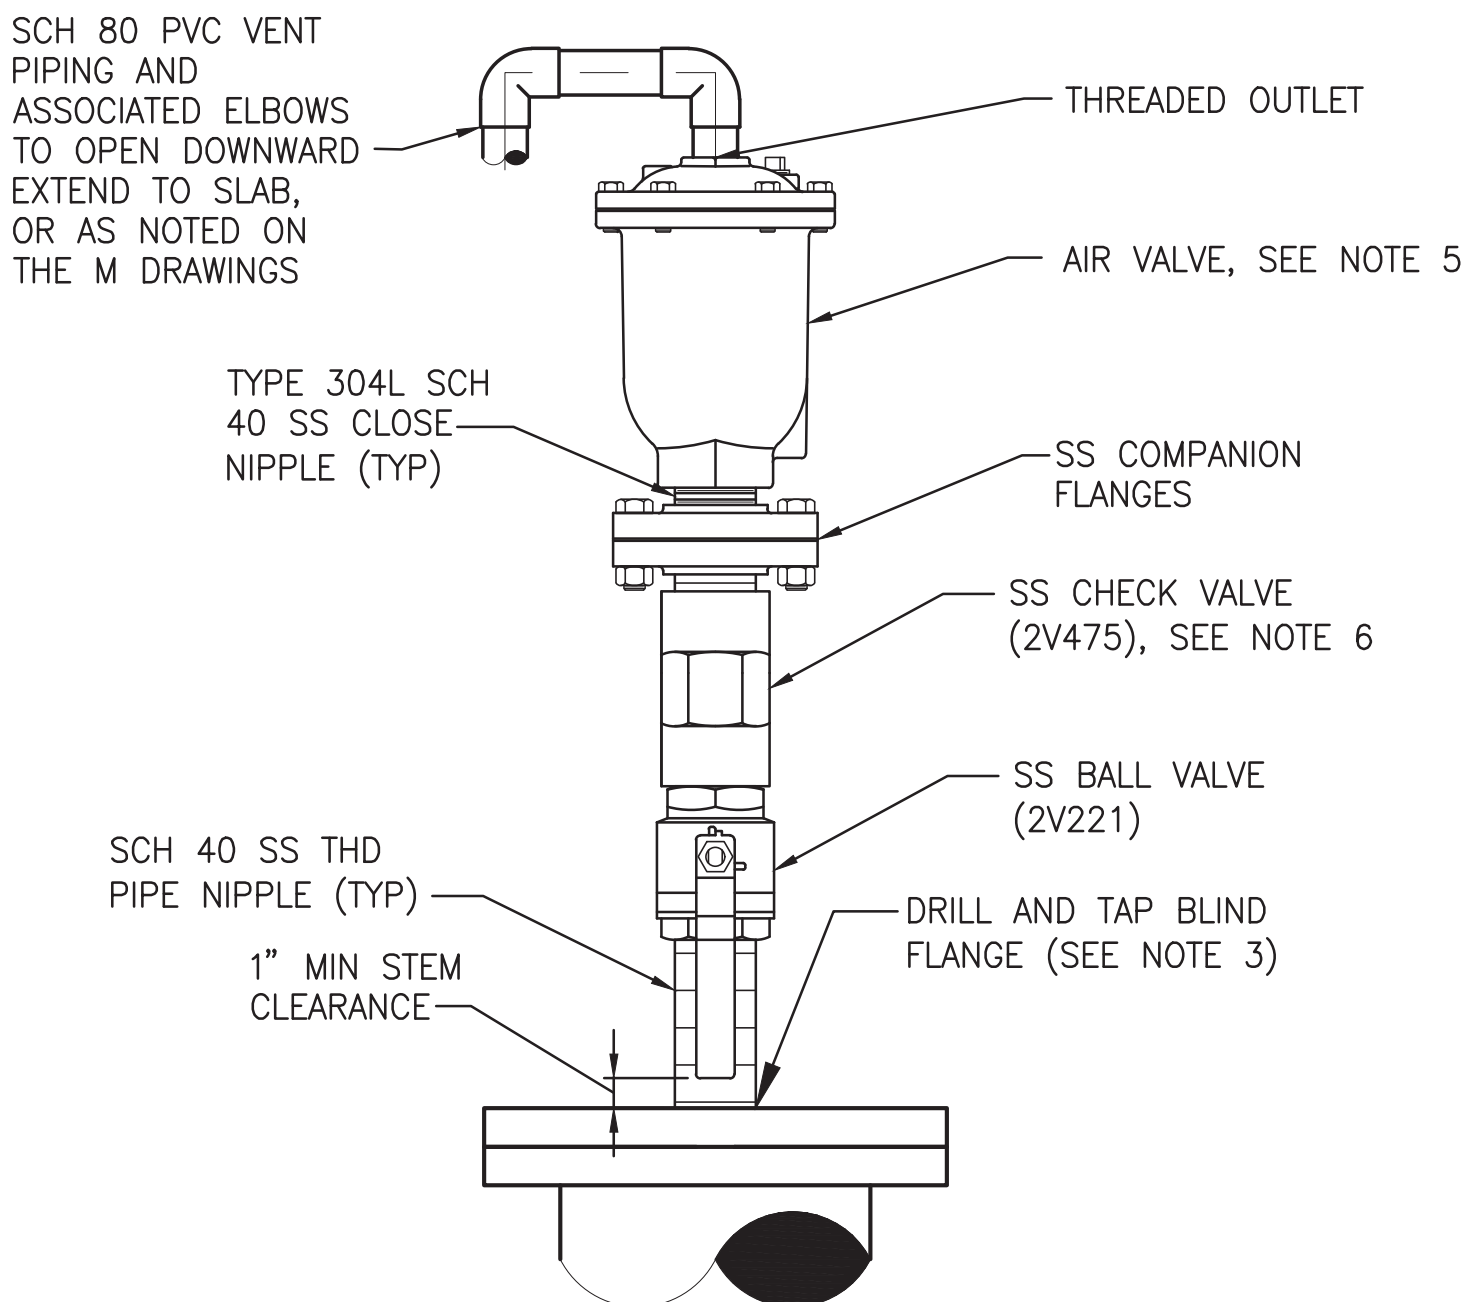

NOTES:

- AIR VALVE INLET DIAMETER SHALL BE 2-INCH.
- BALL VALVE AND NIPPLES SHALL HAVE THE SAME DIAMETER AS THE AIR VALVE INLET.
- VERIFY SIZE OF VALVE PRIOR TO ORDERING ANCILLARY PARTS, DRILLING OR TAPPING.
- EXTEND VENT TO 6" AFF, PROVIDE SS BUG SCREEN, AND S.S. UNI-STRUT SUPPORT, FOR RECHARGE PUMP BUILDING EXTEND VENT TO WET WELL AS SHOWN.
- FOR MONITORING WELLS RZMW-1, RZMW-2, SLMW-1, AND SUPPLY WELL INSTALL COMBINATION ARV/VACUUM VALVES AT WELL HEAD.
- CHECK VALVE ONLY REQUIRED AT RECHARGE WELL HEAD, AT CHEMICAL FEED, AND AT RECHARGE WELL PUMP BUILDING LOCATIONS

AIR RELEASE VALVE DETAIL 5

LTR.	DATE	REVISIONS	BY	APPRD.	

DESIGNED	SMENARD
DRAWN	JKRAMER
CHECKED	DYONGE

JonesEdmunds
 CERTIFICATE OF AUTHORIZATION #1841
 730 NE WALDO ROAD, GAINESVILLE, FLORIDA 32641 / (352) 377-5821
 324 S HYDE PARK AVE, SUITE 250, TAMPA, FLORIDA 33606 / (813) 258-0703

AQUIFER RECHARGE AT FLATFORD SWAMP
 SOUTHWEST FLORIDA WATER MANAGEMENT DISTRICT

MECHANICAL DETAILS

APPROVED BY	THOMAS W. FRIEDRICH P.E. 61281
-------------	-----------------------------------

PROJECT NO:	19850-041-01	DATE:	SEP. 2019
INDEX NO:		DWG NO:	M6



- ## TYPICAL CONCRETE ENCASEMENT DETAIL



FLOOR DRAIN DETAIL 6

DESIGNED SMENARD

DRAWN JKRAMER

CHECKED DYONGE

JonesEdmunds
 CERTIFICATE OF AUTHORIZATION #1841
 730 NE WALDO ROAD, GAINESVILLE, FLORIDA 32641 / (352) 377-5821
 324 S HYDE PARK AVE, SUITE 250, TAMPA, FLORIDA 33606 / (813) 258-0703

**AQUIFER RECHARGE AT FLATFORD SWAMP
SOUTHWEST FLORIDA WATER MANAGEMENT DISTRICT**


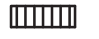







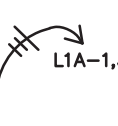







MECHANICAL DETAILS

APPROVED BY

THOMAS W. FRIEDRICH
P.E. 61281

PROJECT NO:	DATE:
19850-041-01	SEP. 2019

INDEX NO:	DWG NO: M7
-----------	---------------

ELECTRICAL SYMBOL LEGEND		
SYMBOL	DESCRIPTION	MOUNTING
	POWER (DISTRIBUTION) PANELBOARD, VOLTAGE AS NOTED	M.H. 6'-6" MIN. TO TOP
	POWER PANELBOARD, VOLTAGE AS NOTED	M.H. 6'-6" MIN. TO TOP
	BRANCH PANEL	M.H. 6'-6" MIN. TO TOP
	EQUIPMENT CONTROL PANEL	M.H. 6'-6" MIN. TO TOP
	SINGLE POLE SWITCH (20A, 120/277)	M.H. 40" MIN. TO BOTTOM
	DUPLEX RECEPTACLE (20A, 125V)	M.H. 18" TO CENTERLINE
	RACEWAY CONCEALED IN WALL OR ABOVE CEILINGS	SEE SPECIFICATIONS
	RACEWAY CONCEALED UNDER FLOOR OR BELOW GRADE	SEE SPECIFICATIONS
	RACEWAY EXPOSED ON WALL OR CEILING	SEE SPECIFICATIONS
	HOMERUN TO PANEL, LETTERS INDICATE PANEL, NUMBERS INDICATE CIRCUIT. NOTE: ANY CIRCUIT WITHOUT FURTHER DESIGNATION INDICATES A TWO WIRE CIRCUIT. A GREATER NUMBER OF WIRES IS INDICATED AS SHOWN:  EG (3 WIRES & EQUIPMENT GROUND),  (4 WIRES & EQUIPMENT GROUND), ETC.	SEE SPECIFICATIONS
	RACEWAY RISER, UP OR DOWN AS NOTED.	SEE SPECIFICATIONS
	JUNCTION BOX OR OUTLET BOX, 4"x2 1/8" DEEP BOX UNLESS OTHERWISE NOTED	SEE SPECIFICATIONS
	MOTOR, NUMERAL INDICATES HORSEPOWER	BY OTHER DIVISION
	NON-FUSIBLE SAFETY SWITCH	SEE SPECIFICATIONS
	DRY TYPE TRANSFORMER	FLOOR OR AS NOTED


1. THE CONTRACTOR SHALL PROVIDE RUBBER MATS AND PLYWOOD COVERS FOR ALL OWNERS EQUIPMENT SUSCEPTIBLE TO DAMAGE.
2. ALL WORK SHALL BE PERFORMED DURING TIME PERIODS ACCEPTABLE TO THE OWNER. SCHEDULE ALL WORK WITH THE OWNER'S REPRESENTATIVE BEFORE PROCEEDING.
3. THE CONTRACTOR SHALL PERFORM ALL TEMPORARY WORK NECESSARY TO MAINTAIN CONTINUITY OF ELECTRICAL SERVICE WHEN CONNECTION IS MADE TO EXISTING SYSTEMS AND FACILITIES. EXISTING SERVICE SHALL NOT BE INTERRUPTED WITHOUT PRIOR CONSENT OF THE OWNER'S REPRESENTATIVE AND MAY BE INTERRUPTED ONLY AT AND FOR THE SPECIFIED TIME DESIGNATED BY OWNER'S REPRESENTATIVE. THE CONTRACTOR SHALL BE GUIDED BY THE OWNER'S REPRESENTATIVE AT ALL TIMES IN MATTERS AFFECTING THE EXISTING FACILITIES.
4. UPON COMPLETION OF THE WORK, THE CONTRACTOR SHALL ENSURE THAT ALL SYSTEMS OPERATE AS DESIGNED AND REQUIRED AND SHALL REVIEW THEIR OPERATION WITH THE OWNER. COMPLETE SET OF AS-BUILT DRAWINGS SHALL BE COMPILED (BY THE CONTRACTOR) AND ISSUED (1 EACH) TO THE ENGINEER AND BUILDING MAINTENANCE PERSONNEL UPON COMPLETION OF CONSTRUCTION AND TESTING.
5. ALL ELECTRICAL AND INSTRUMENTATION WIRING AND CONDUIT SHALL BE INSTALLED BELOW GRADE AND SHALL NOT CROSS SIDEWALKS OR WALKWAYS. ABOVE GRADE WHERE POSSIBLE.

1. REMOVE AND/OR RELOCATE ALL CONDUIT WIRE, OUTLET BOXES, ETC. WHICH ARE MADE UNNECESSARY BECAUSE OF DEMOLITION/NEW CONSTRUCTION. VERIFY LOCATIONS AND QUANTITIES OF ELECTRICAL EQUIPMENT AND WIRING AT THE SITE. CONDUIT TO BE REMOVED OR ABANDONED SHALL BE REMOVED COMPLETELY IF POSSIBLE. WHERE (ABOVE GRADE) REMOVAL IS NOT POSSIBLE, CONDUIT SHALL BE CAPPED AND TAGGED AS SPARE. WHERE (BELOW GRADE) REMOVAL IS NOT POSSIBLE, CONDUIT SHALL BE CUT BELOW THE SURFACE AND CAPPED. ALL MATERIALS REMOVED SHALL BE DISPOSED OF BY THE CONTRACTOR. PATCH CONCRETE FLOOR TO MATCH EXISTING.
2. ANY DEMOLITION OR REMOVAL INDICATED IS SHOWN TO PROVIDE THE GENERAL EXTENT OF DEMOLITION. THIS INFORMATION IS NOT A RECORD DRAWING OF EXISTING CONDITIONS.
3. ANY DEMOLITION OF EXISTING ELECTRICAL EQUIPMENT (AS INDICATED IN NOTES 1 & 2 ABOVE) SHALL BE CONFIRMED AND APPROVED BY OWNER BEFORE EXISTING EQUIPMENT IS DISCONNECTED AND REMOVED.

CONTRACTOR SHALL FURNISH AND INSTALL CLASS I LIGHTNING PROTECTION SYSTEM ON RECHARGE WELL PUMP BUILDING, CHEMICAL FEED AREA AND RECHARGE PUMP BUILDING. ALL MATERIALS SHALL BE COPPER. SYSTEM SHALL COMPLY WITH ALL UL & NFPA REQUIREMENTS AND OBTAIN A UL "MASTER LABEL" CERTIFICATION.

BID SET

10/1/2019 4:07 PM RICHARD.BARBETTO P:\-6299\6231\ELEC\6231-E2.DWG

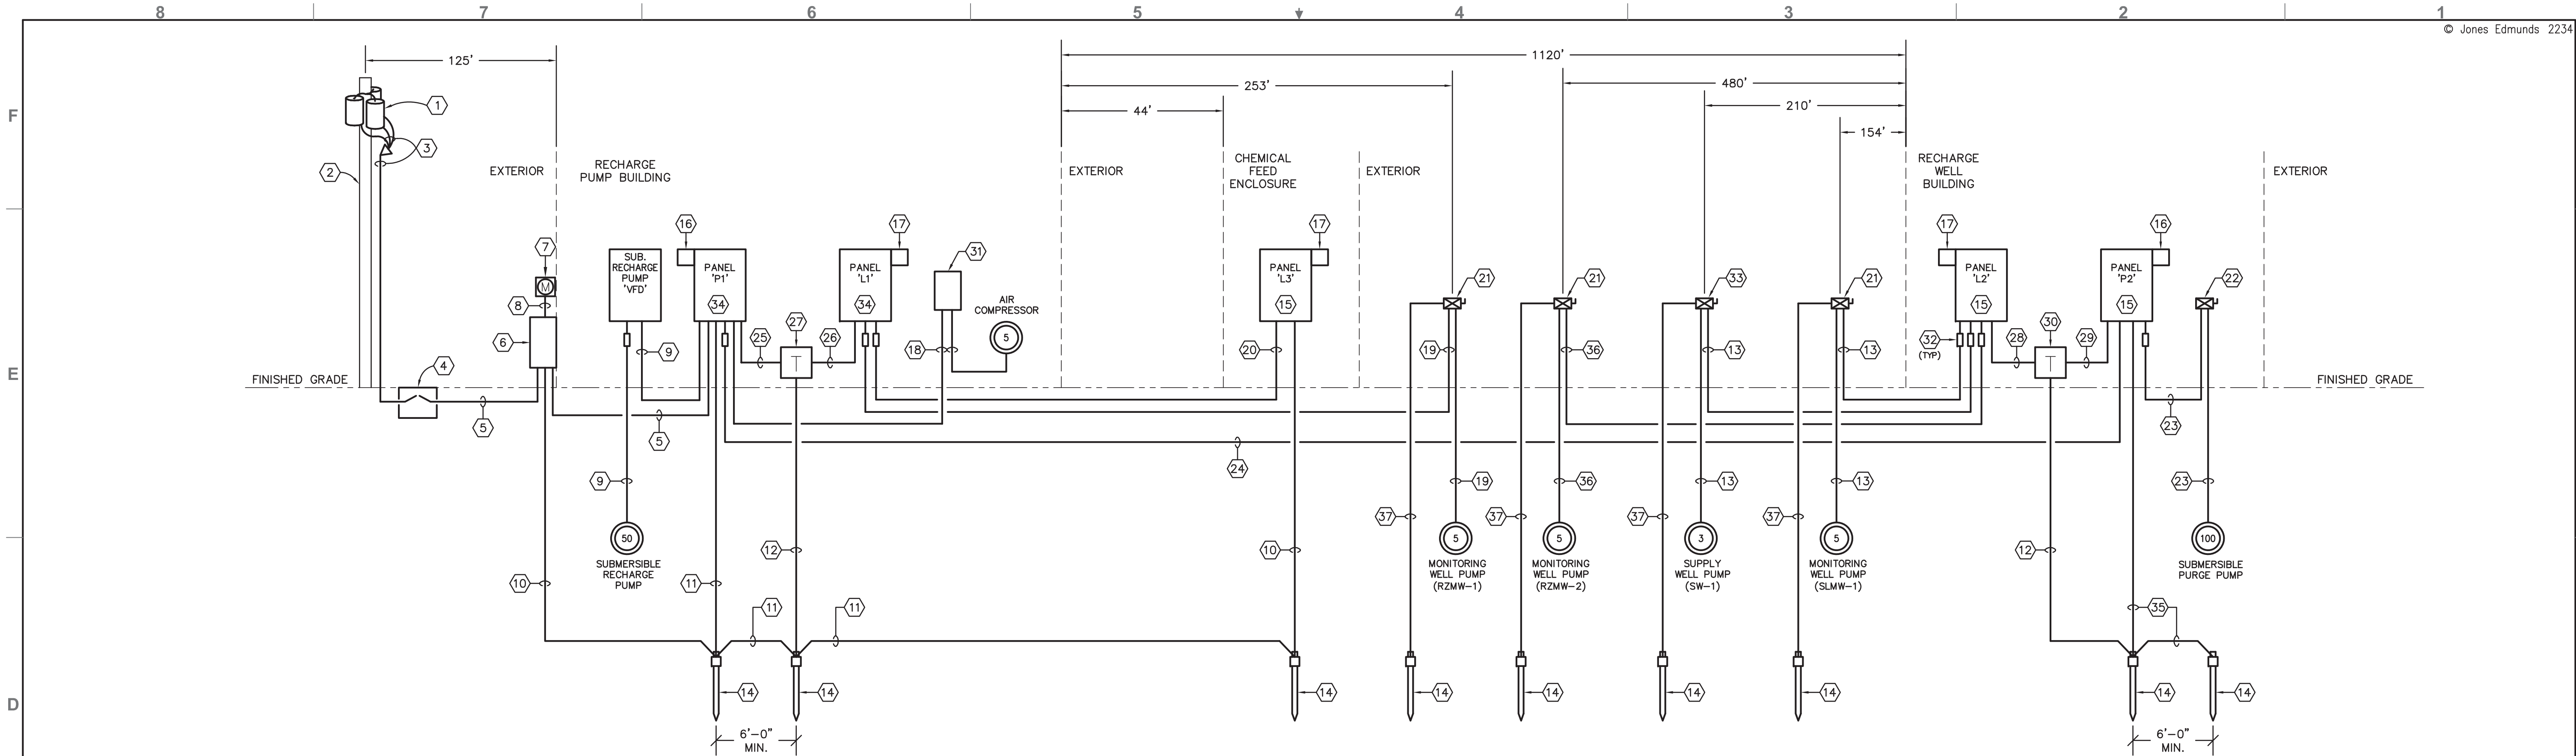

POWER ONE-LINE DIAGRAM

NOTES:

- 1 PEACE RIVER ELECTRIC TRANSFORMERS WITH 480/277., 3ø, 4W. SECONDARY SCA: 18,042 AMPS. COORDINATE SERVICE WITH KENDELL COKER AT (863) 767-4660.
- 2 NEW PEACE RIVER ELECTRIC POWER POLE.
- 3 SECONDARY CONDUCTORS AND CONDUIT BY PEACE RIVER ELECTRIC.
- 4 FLUSH AT-GRADE HANDHOLE PER PEACE RIVER ELECTRIC'S REQUIREMENTS. COORDINATE WITH PEACE RIVER ELECTRIC. HANDHOLE IS OWNERSHIP LINE. PEACE RIVER ELECTRIC WILL MAKE CONNECTIONS. FURNISHED AND INSTALLED BY CONTRACTOR.
- 5 2 SETS OF 4-350 MCM - 3 1/2"C.
- 6 CT METERING CABINET.
- 7 METER SOCKET AND CAN PER PEACE RIVER ELECTRIC'S REQUIREMENTS
- 8 1" EMPTY CONDUIT.
- 9 3 NO. 2 AND 1 NO. 6 E.G. - 1 1/4"C.
- 10 NO. 6 AWG COPPER GROUND CONDUCTOR.
- 11 NO. 2/0 AWG COPPER GROUND CONDUCTOR.
- 12 NO. 4 AWG COPPER GROUND CONDUCTOR.
- 13 3 NO. 10 AND 1 NO. 10 E.G. - 3/4"C.
- 14 3/4" X 20'-0" COPPERWELD GROUND ROD.
- 15 NEMA 4X (316 STAINLESS STEEL). SEE PANEL SCHEDULES.
- 16 SURGE PROTECTION DEVICE (PQ PROTECTION # PQC200) 480/277V., 3ø, 4W. OR PRE-APPROVED EQUIVALENT. CONNECT WITH 4 NO. 6 AND 1 NO. 8 E.G. - 3/4" C. MAX LENGTH 18" WITH NO SHARP BENDS.

- 17 SURGE PROTECTION DEVICE (PQ PROTECTION # PQC100) 120/240V., 3ø, 4W. OR PRE-APPROVED EQUIVALENT. CONNECT WITH 4 NO. 10 AND 1 NO. 10 E.G. - 3/4" C. MAX LENGTH 18" WITH NO SHARP BENDS.
- 18 3 NO. 12 AND 1 NO. 12 E.G. - 3/4"C.
- 19 3 NO. 8 AND 1 NO. 8 E.G. - 1"C.
- 20 4 NO. 3 AND 1 NO. 6 E.G. - 1 1/4"C.
- 21 30A, 3P, SIZE 1, COMBINATION MOTOR STARTER IN NEMA 4X (316 STAINLESS STEEL) ENCLOSURE. A ON-OFF SWITCH SHALL BE MOUNTED IN FRONT COVER.
- 22 400A, 3P, SIZE 4, COMBINATION MOTOR STARTER IN NEMA 4X (316 STAINLESS STEEL) ENCLOSURE. A HAND-OFF-AUTOMATICH, HOA SWITCH SHALL BE MOUNTED IN FRONT COVER.
- 23 3 NO. 2/0 AND 1 NO. 4 E.G. - 2"C.
- 24 2 SETS OF 4-500 MCM AND 1 NO 1/0 E.G. - 3 1/2"C.
- 25 3 NO. 4 AND 1 NO 4 G.C. - 1 1/4"C.
- 26 4 NO. 2/0 AND 1 NO 4 E.G. - 2"C.
- 27 45KVA, 480-120/208V, 3ø, 4W., DRY TYPE TRANSFORMER.
- 28 3 NO. 6 AND 1 NO 6 G.C. - 1"C.
- 29 4 NO. 2 AND 1 NO 6 E.G. - 1 1/2"C.
- 30 30KVA, 480-120/208V, 3ø, 4W., (NEMA 3R) DRY TYPE TRANSFORMER.
- 31 AIR COMPRESSOR CONTROL PANEL WITH MOTOR STARTER.

- 32 PROVIDE AND INSTALL "SEAL-OFF" FITTINGS ON ALL CONDUITS ENTERING AND LEAVING BUILDING.
- 33 30A, 3P, SIZE 0, COMBINATION MOTOR STARTER IN NEMA 4X (316 STAINLESS STEEL) ENCLOSURE. A ON-OFF SWITCH SHALL BE MOUNTED IN FRONT COVER.
- 34 SEE PANEL SCHEDULES.
- 35 NO. 1/0 AWG COPPER GROUND CONDUCTOR.
- 36 3 NO. 4 AND 1 NO. 6 E.G. - 1 1/4"C.
- 37 NO. 8 AWG COPPER GROUND CONDUCTOR.

CARASTRO & ASSOCIATES, INC.

CONSULTING ENGINEERS EB-0001160
 2609 W. DE LEON STREET TAMPA, FLORIDA 33609
 TELEPHONE: (813) 874-9494 WWW.CARASTRO.COM

JonesEdmunds

CERTIFICATE OF AUTHORIZATION #1841
 730 NE WALDO ROAD, GAINESVILLE, FLORIDA 32641 / (352) 377-5821
 324 S HYDE PARK AVE, SUITE 250, TAMPA, FLORIDA 33606 / (813) 258-0703

AQUIFER RECHARGE AT FLATFORD SWAMP
 SOUTHWEST FLORIDA WATER MANAGEMENT DISTRICT

POWER ONE-LINE DIAGRAM

APPROVED BY

PAUL S. CARASTRO
 P.E. # 45830

PROJECT NO:

19850-041-01

DATE:


SEPT 2019

INDEX NO:


DWG NO:

E2

10/1/2019 4:08 PM RICHARD.BARBETTO P:\-6299\6231\ELEC\6231-E3.DWG

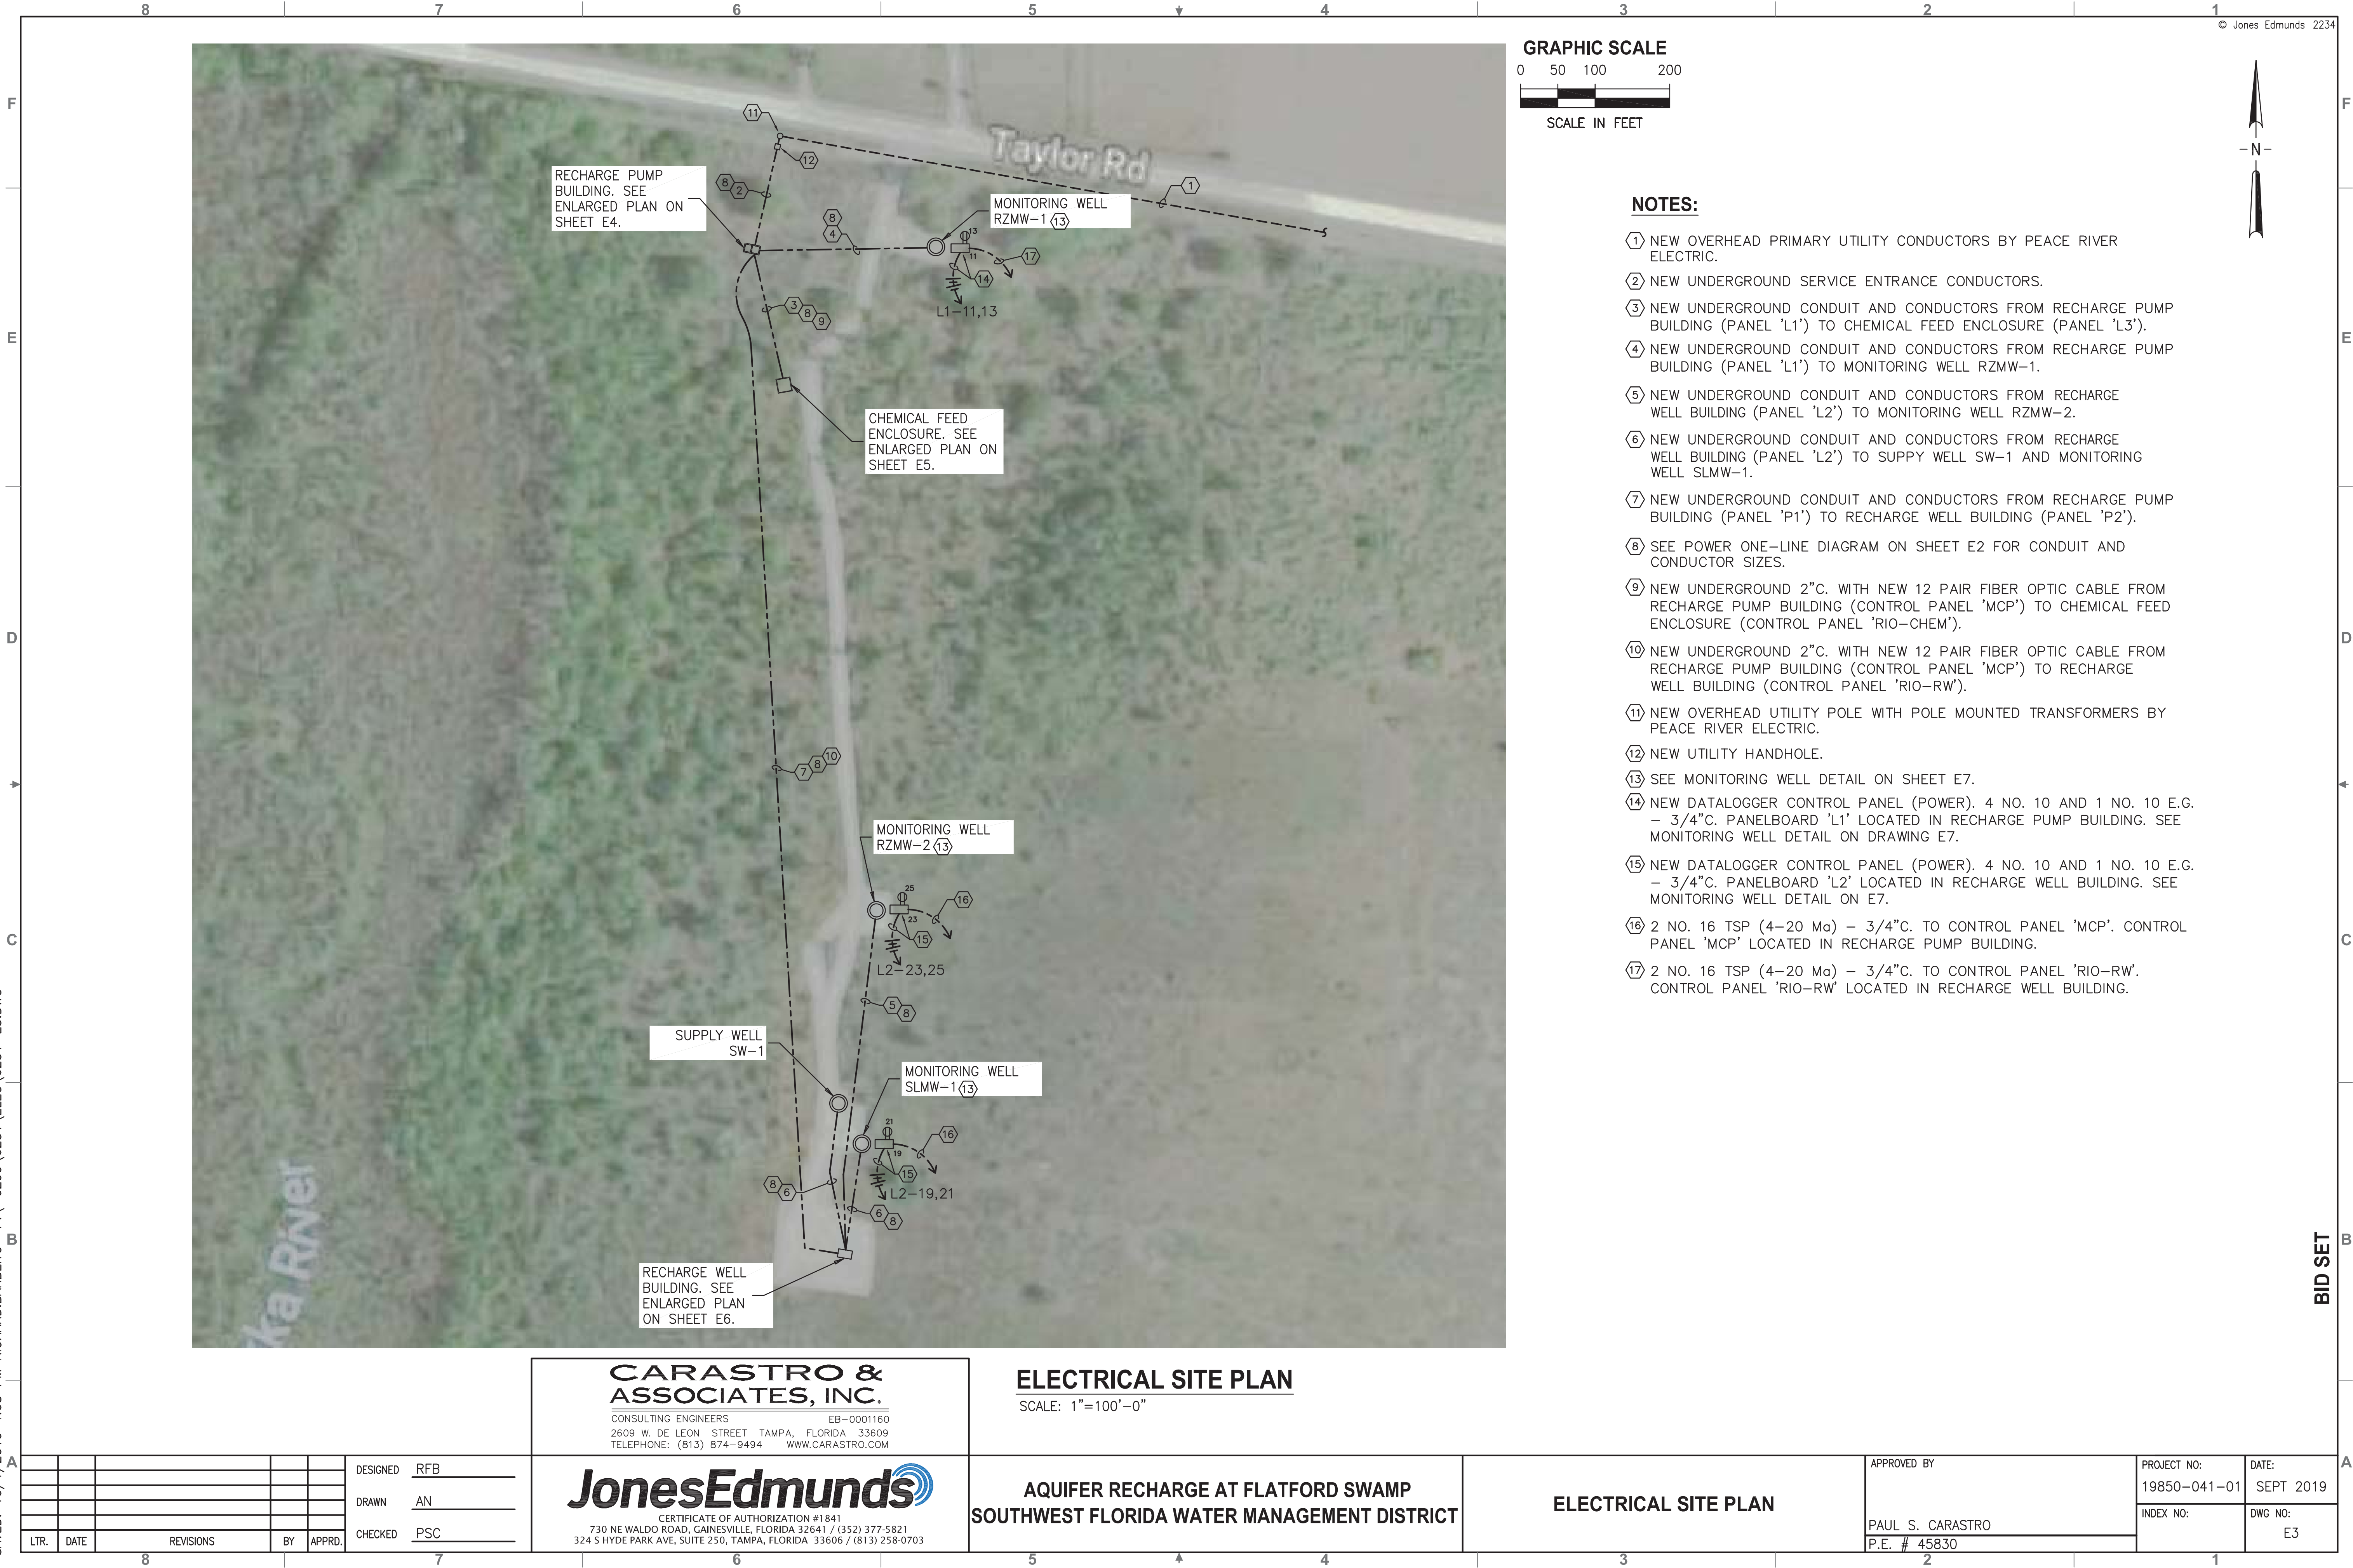

10/1/2019 4:37 PM RICHARD.BARBEITO P:\-6299\6231\ELEC\6231-E4.DWG

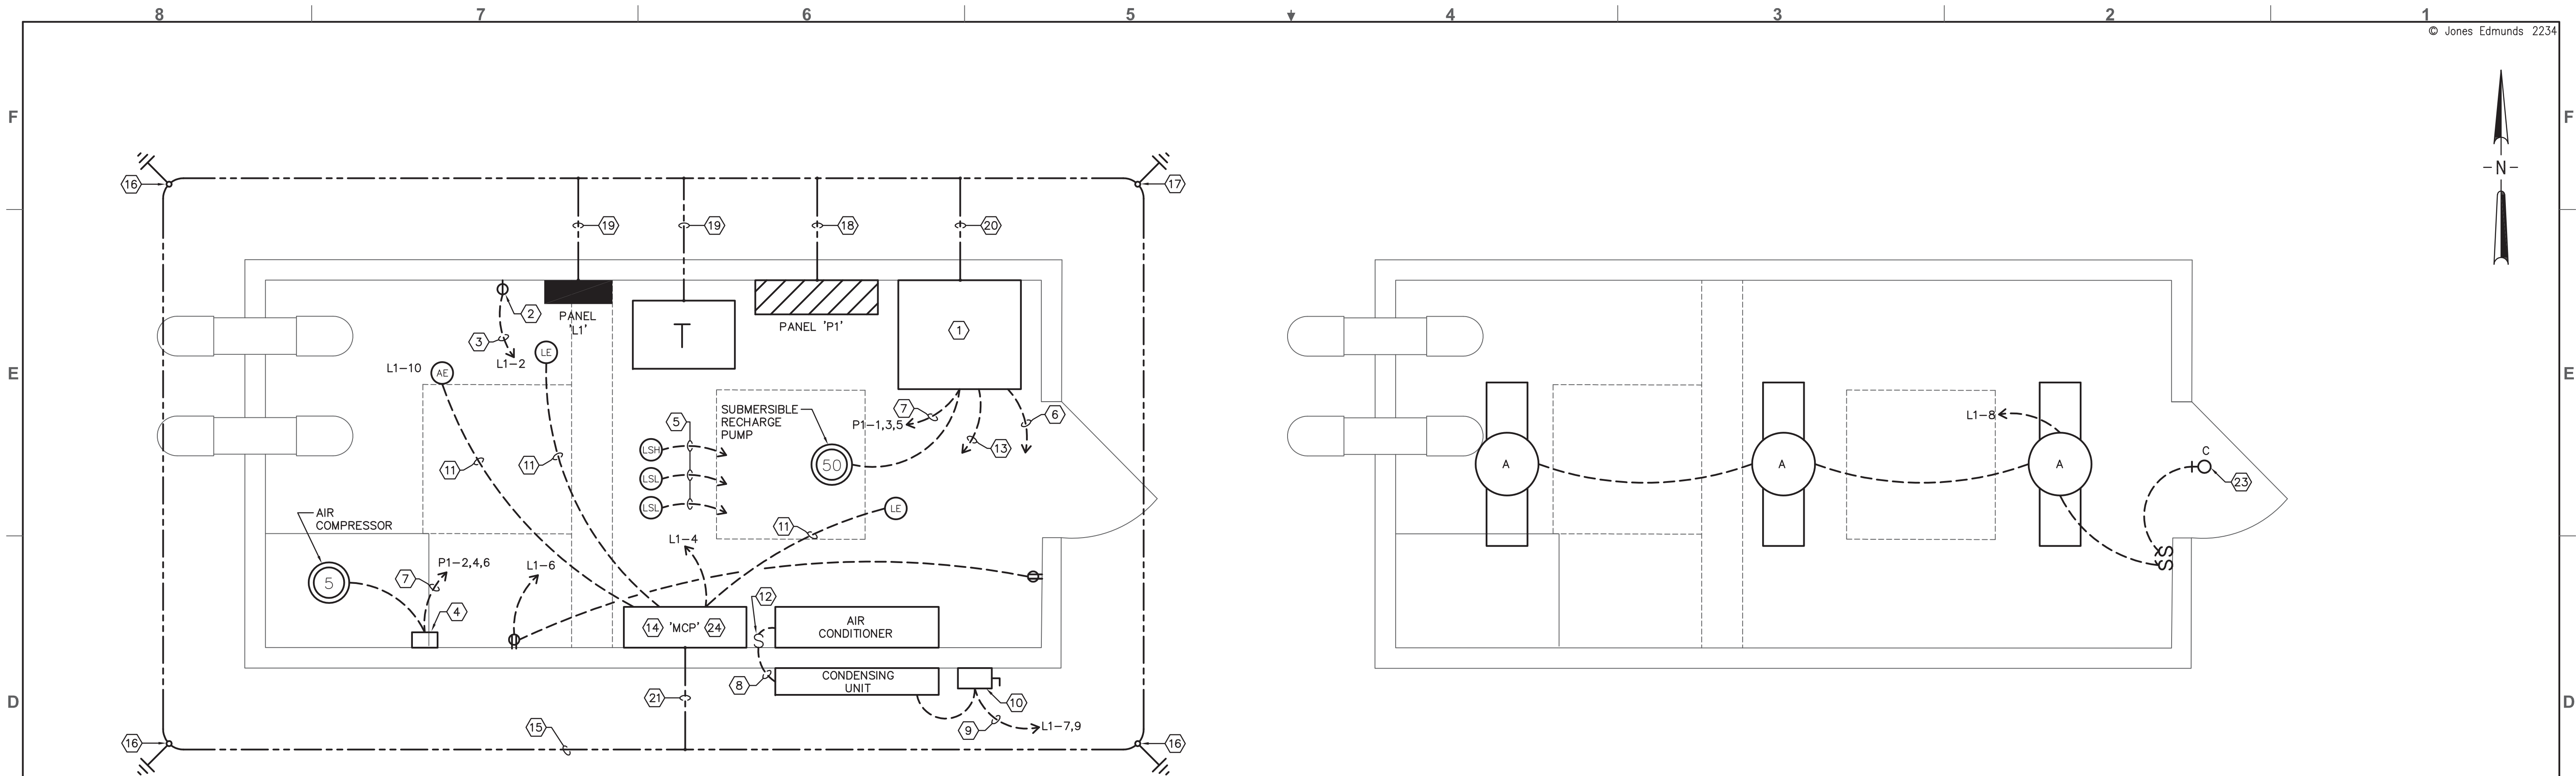

RECHARGE PUMP BUILDING - POWER PLAN

SCALE: 1/2"=1'-0"

RECHARGE PUMP BUILDING - LIGHTING PLAN


SCALE: 1/2"=1'-0"

NOTES:

- ① 460 VOLT, 12-PULSE, VFD DRIVE FOR SUBMERSIBLE WELL PUMP.
- ② 50A., 5-50R RECEPTACLE FOR PORTABLE TRASH PUMP. PORTABLE TRASH PUMP TO INCLUDE 5-50P PLUG. COORDINATE EXACT ELECTRICAL REQUIREMENTS WITH PUMP MANUFACTURER.
- ③ 2 NO. 8 AND 1 NO. 10 E.G. - 3/4"C.
- ④ AIR COMPRESSOR CONTROL PANEL.
- ⑤ 2 NO. 12 - 3/4"C. TO CONTROL PANEL 'MCP'.
- ⑥ 8 NO. 14 - 3/4"C. TO CONTROL PANEL 'MCP'.
- ⑦ SEE POWER ONE-LINE DIAGRAM FOR ADDITIONAL INFORMATION.
- ⑧ CONNECT BACK TO TERMINAL BLOCK LOCATED IN CONDENSING UNIT. USE 2 NO. 12 AND 1 NO. 12 E.G. - 3/4"C.
- ⑨ 3 NO. 10 AND 1 NO. 10 E.G. - 3/4"C. (ENTIRE CIRCUIT).
- ⑩ 30A., 2-POLE, NEMA 4X (304 STAINLESS STEEL) DISCONNECT SWITCH
- ⑪ MANUFACTURER SUPPLIED CABLE(S) IN 3/4"C. TO CONTROL PANEL 'MCP'.
- ⑫ 120 VOLT (MOTOR RATED) TOGGLE TYPE DISCONNECT SWITCH.
- ⑬ 3/4" CONDUIT WITH CAT6 (ETHERNET) CABLE FROM NEW VFD TO NEW CONTROL PANEL 'MCP'.

- ⑭ NEW MASTER CONTROL PANEL 'MCP'.
- ⑮ NO. 4/0 BARE COPPER CONDUCTOR FOR GROUND GRID.
- ⑯ NEW 5/8" X 20'-0" COPPER GROUND ROD.
- ⑰ NEW 5/8" X 20'-0" COPPER GROUND ROD WITH EXTERIOR TEST POINT.
- ⑱ NO. 1/0 GROUND CONDUCTOR IN 1"C TO GROUND GRID.
- ⑲ NO. 4 GROUND CONDUCTOR IN 1"C TO GROUND GRID.
- ⑳ NO. 6 GROUND CONDUCTOR IN 3/4"C TO GROUND GRID.
- ㉑ NO. 8 GROUND CONDUCTOR IN 3/4"C TO GROUND GRID.
- ㉒ 8 NO. 14 - 3/4"C. TO CONTROL PANEL 'MCP'.
- ㉓ LIGHT FIXTURE TO BE MOUNTED ABOVE DOOR.
- ㉔ CONTRACTOR TO FURNISH AND INSTALL PRESSURE TRANSDUCER, DATA LOGGER, COMMUNICATION EQUIPMENT, ETC. FOR A COMPLETE SYSTEM.

GRAPHIC SCALE

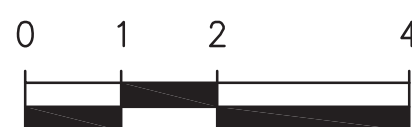

SCALE, IN FEET
 1/2"=1'-0"

LTR.	DATE	REVISIONS	BY	APPRD.	CHECKED

DESIGNED RFB
 DRAWN AN
 CHECKED PSC

CARASTRO & ASSOCIATES, INC.

CONSULTING ENGINEERS EB-0001160
 2609 W. DE LEON STREET TAMPA, FLORIDA 33609
 TELEPHONE: (813) 874-9494 WWW.CARASTRO.COM



CERTIFICATE OF AUTHORIZATION #1841
 730 NE WALDO ROAD, GAINESVILLE, FLORIDA 32641 / (352) 377-5821
 324 S HYDE PARK AVE, SUITE 250, TAMPA, FLORIDA 33606 / (813) 258-0703


AQUIFER RECHARGE AT FLATFORD SWAMP
 SOUTHWEST FLORIDA WATER MANAGEMENT DISTRICT

RECHARGE PUMP BUILDING
 ELECTRICAL PLANS

APPROVED BY	PROJECT NO:	DATE:
PAUL S. CARASTRO	19850-041-01	SEPT 2019
P.E. # 45830	INDEX NO:	DWG NO:
		E4


BID SET

10/1/2019 4:46 PM RICHARD BARBEITO P:\-6299\6231\ELEC\6231-E5.DWG

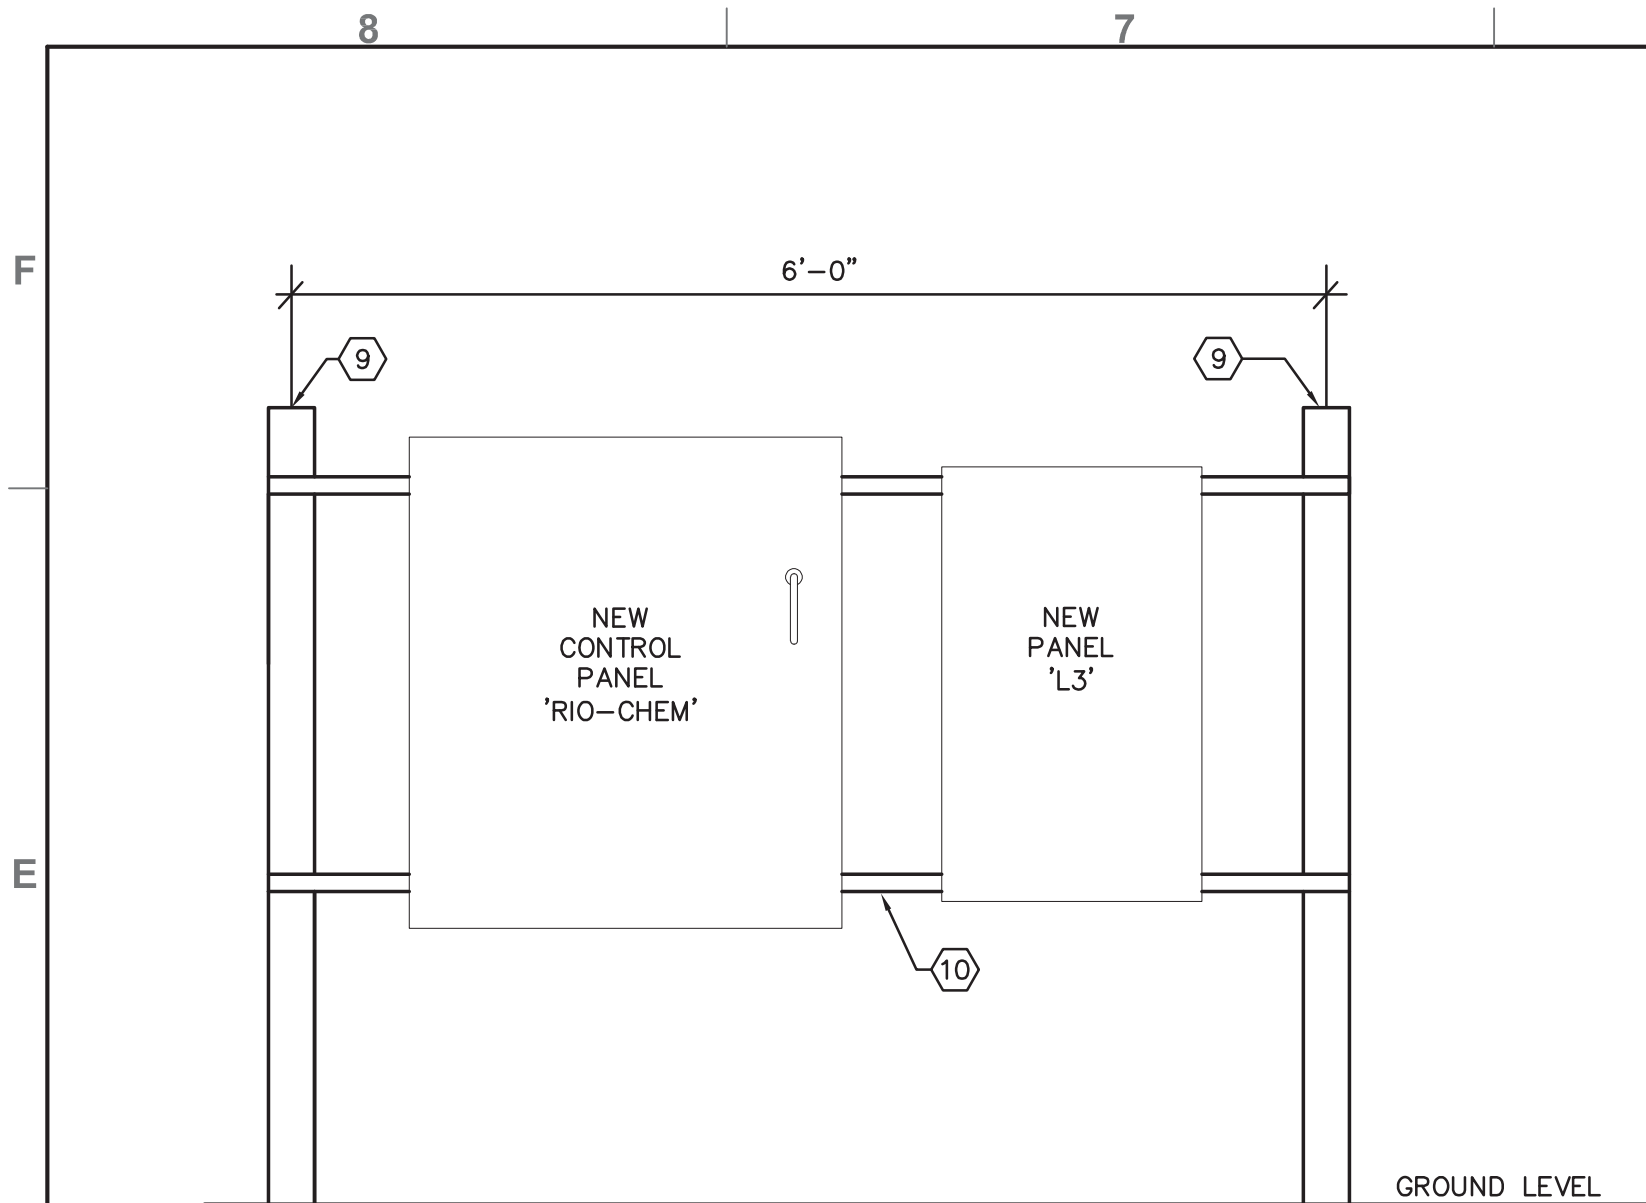


ELECTRICAL ELEVATION DETAIL

SCALE: NONE

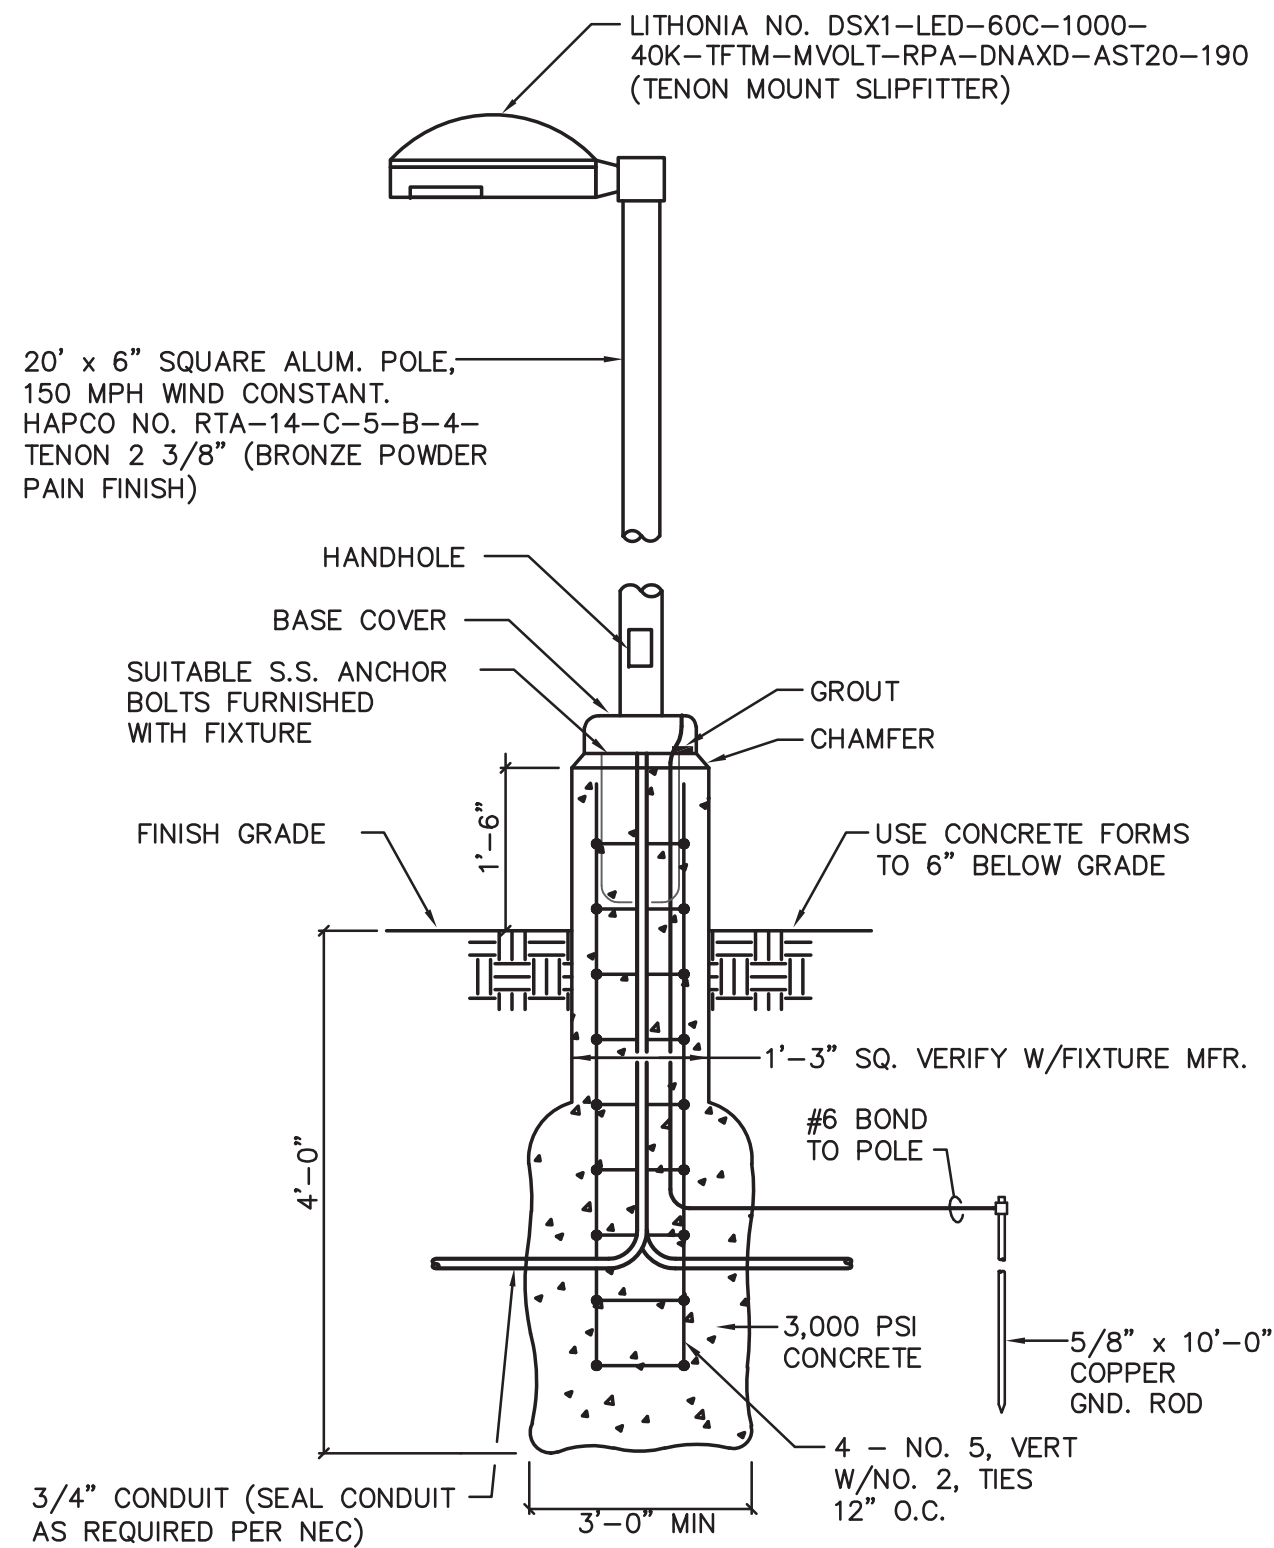

POLE MOUNTED LIGHT FIXTURE DETAIL

SCALE: NONE

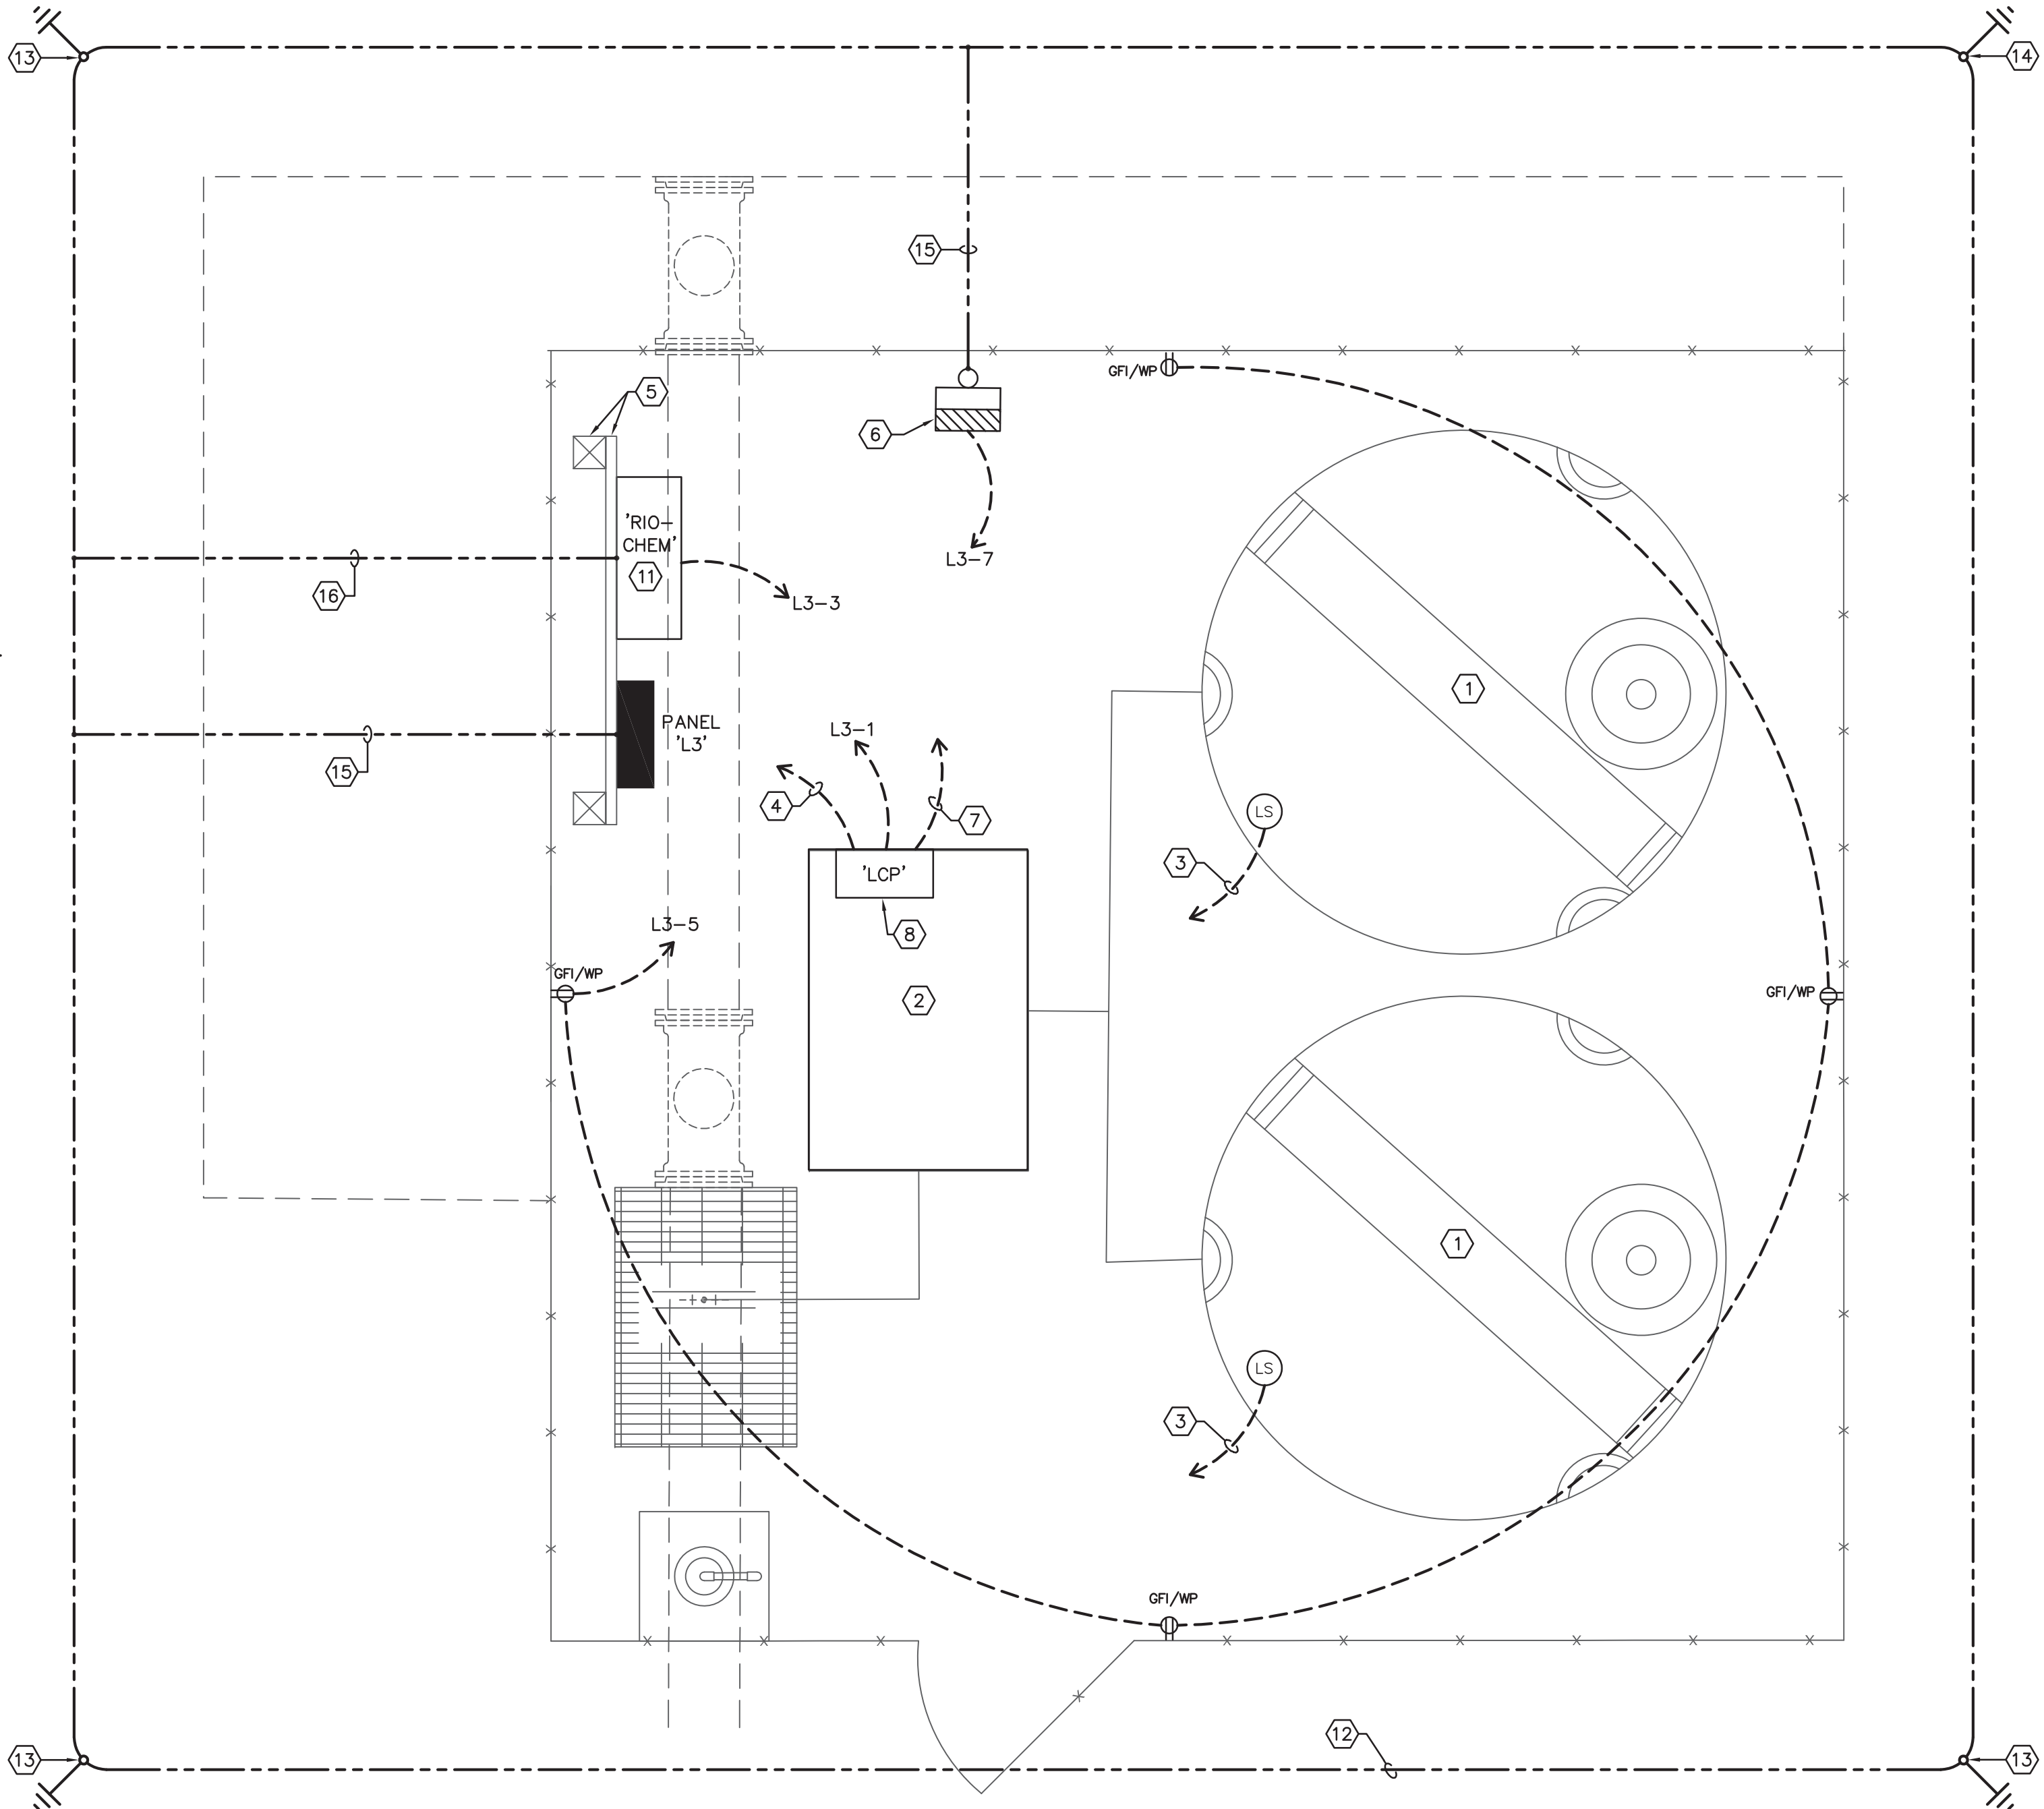

CHEMICAL FEED ENCLOSURE - ELECTRICAL PLAN

SCALE: 1/2"=1'-0"


GENERAL NOTES:

1. COORDINATE ALL LOCATIONS OF PROPOSED EQUIPMENT WITH ENGINEER AND OWNER PRIOR TO INSTALLATION.

NOTES:

- ① DUAL CONTAINMENT CHEMICAL STORAGE.
 ② CHEMICAL FEED METERING SKID.
 ③ 2 NO. 12 - 3/4"C. TO CONTROL PANEL 'RIO-CHEM'.
 ④ 4 NO. 16 TSP (4-20 mA) - 3/4"C. TO CONTROL PANEL 'RIO-CHEM'.
 ⑤ NEW CONCRETE POST AND UNISTRUT SUPPORT SYSTEM. SEE ELECTRICAL ELEVATION LAYOUT THIS SHEET.
 ⑥ NEW POLE MOUNTED LIGHT LOCATION, REFER TO DETAIL. COORDINATE LOCATION WITH OWNER.
 ⑦ 16 NO. 14 - 1"C. TO CONTROL PANEL 'RIO-CHEM'.
 ⑧ CHEMICAL FEED METERING LOCAL CONTROL PANEL.
 ⑨ 10'-0" CONCRETE 6"x6" POSTS. 6' ABOVE FINISHED GRADE.
 ⑩ 2 1/2"x2 1/2"x1/4" ALUMINUM ANGLE. (TYPICAL).
 ⑪ NEW CONTROL PANEL 'RIO-CHEM'.
 ⑫ NO. 4/0 BARE COPPER CONDUCTOR FOR GROUND GRID.
 ⑬ NEW 5/8" X 20'-0" COPPER GROUND ROD.
 ⑭ NEW 5/8" X 20'-0" COPPER GROUND ROD WITH EXTERIOR TEST POINT.
 ⑮ NO. 6 GROUND CONDUCTOR IN 3/4"C TO GROUND GRID.
 ⑯ NO. 8 GROUND CONDUCTOR IN 3/4"C TO GROUND GRID.

GRAPHIC SCALE

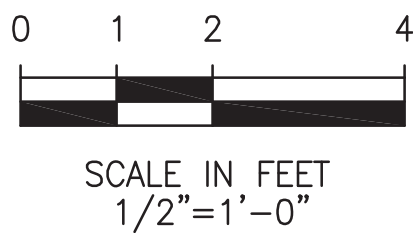

CARASTRO & ASSOCIATES, INC.

CONSULTING ENGINEERS EB-0001160
 2609 W. DE LEON STREET TAMPA, FLORIDA 33609
 TELEPHONE: (813) 874-9494 WWW.CARASTRO.COM



CERTIFICATE OF AUTHORIZATION #1841
 730 NE WALDO ROAD, GAINESVILLE, FLORIDA 32641 / (352) 377-5821
 324 S HYDE PARK AVE, SUITE 250, TAMPA, FLORIDA 33606 / (813) 258-0703


AQUIFER RECHARGE AT FLATFORD SWAMP
 SOUTHWEST FLORIDA WATER MANAGEMENT DISTRICT

CHEMICAL FEED ENCLOSURE
 ELECTRICAL PLANS

APPROVED BY	PROJECT NO:	DATE:
PAUL S. CARASTRO	19850-041-01	SEPT 2019
P.E. # 45830	INDEX NO:	DWG NO:
		E5

BID SET

10/1/2019 4:31 PM RICHARD BARBEITO P:\-6299\6231\ELEC\6231-E6.DWG

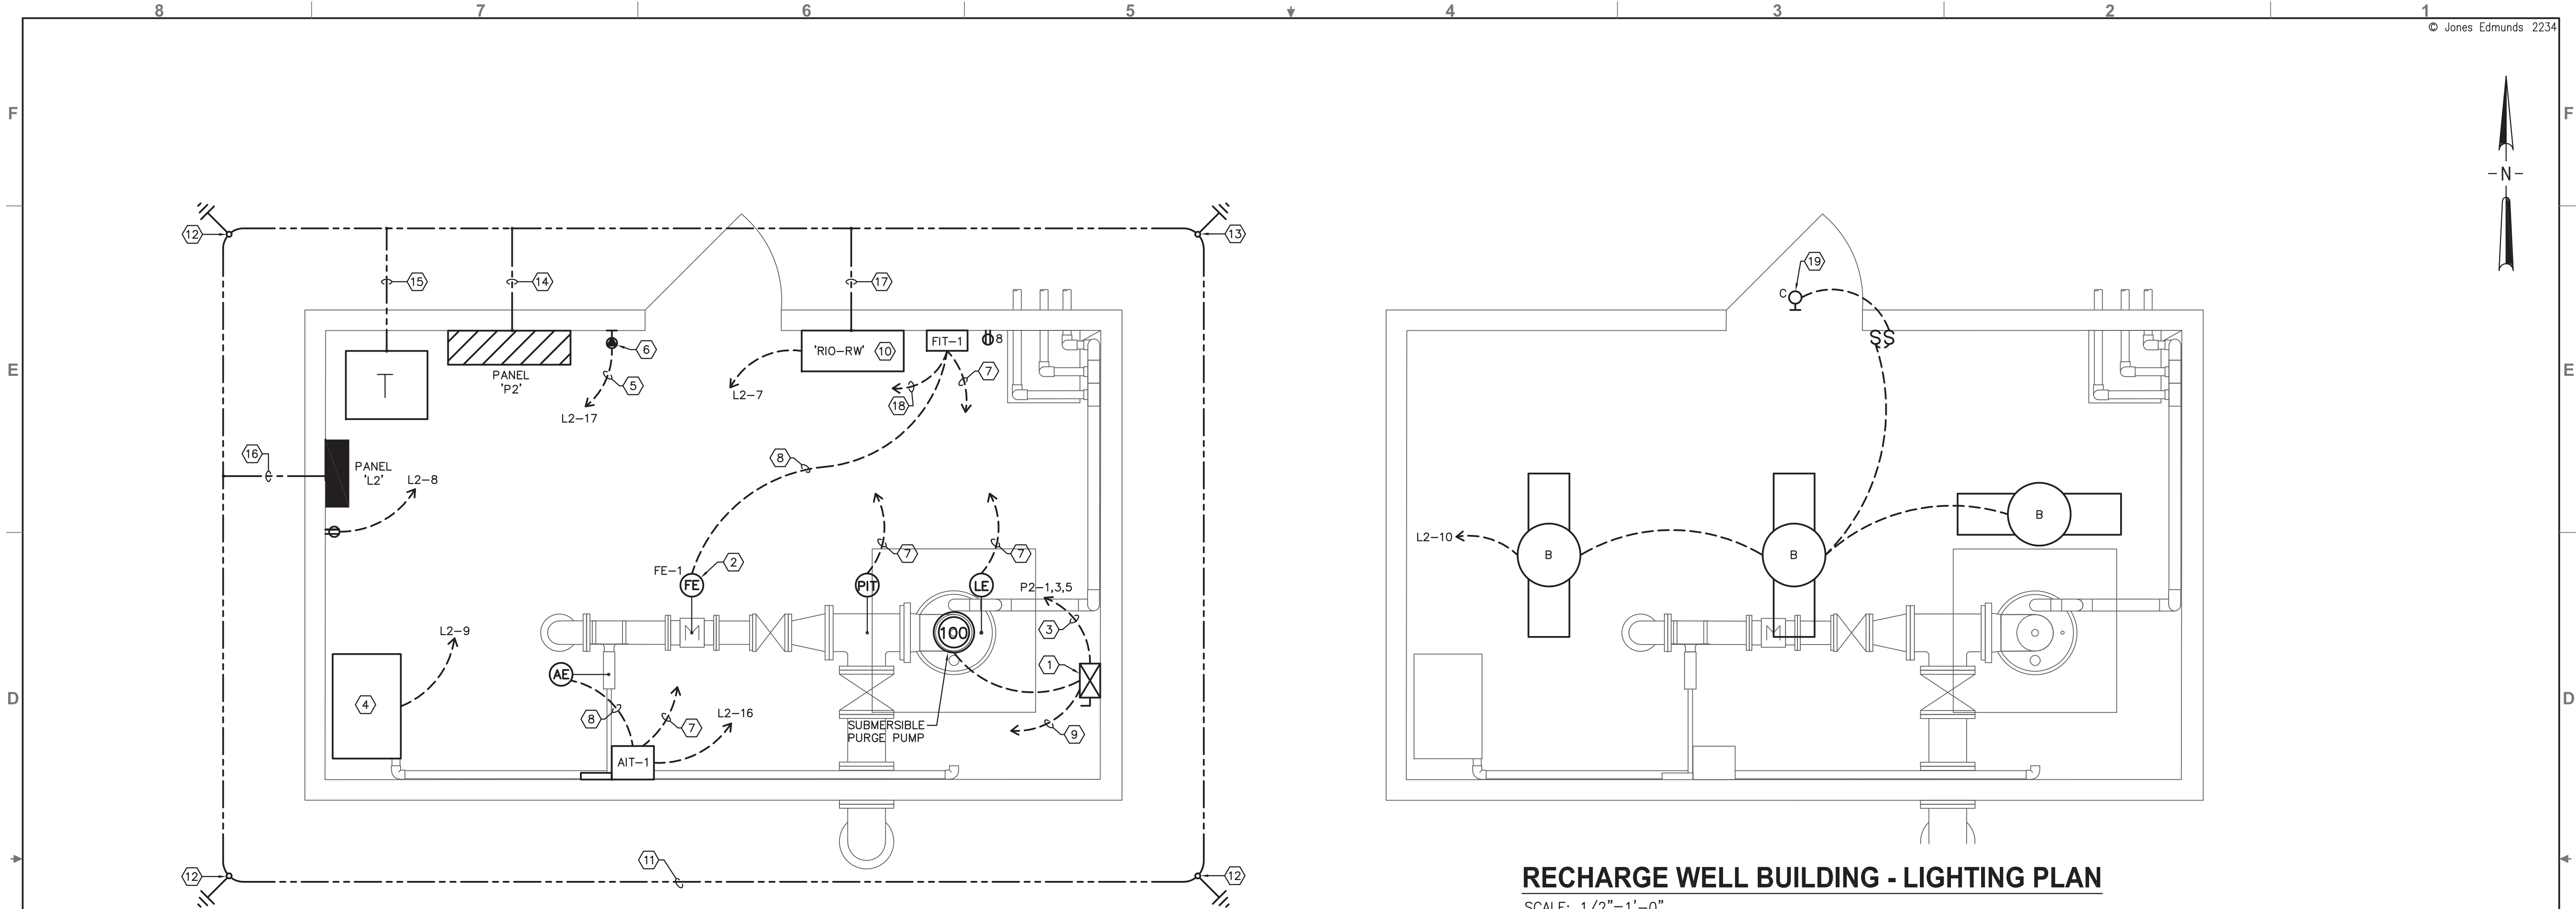


RECHARGE WELL BUILDING - POWER PLAN
 SCALE: 1/2"=1'-0"

RECHARGE WELL BUILDING - LIGHTING PLAN
 SCALE: 1/2"=1'-0"

NOTES:

- ① COMBINATION MOTOR STARTER FOR SUBMERSIBLE PURGE PUMP.
- ② MAGNETIC FLOW METER – FLOW ELEMENT. ENDRESS & HOUSER PROMAG W400.
- ③ SEE POWER ONE-LINE DIAGRAM FOR ADDITIONAL INFORMATION.
- ④ HYDRAULIC POWER UNIT FOR BOREHOLE INJECTION CONTROL VALVE LEVEL INDICATION.
- ⑤ 2 NO. 10 AND 1 NO. 10 E.G. – 3/4"C.
- ⑥ 30A., RECEPTACLE FOR FUTURE EQUIPMENT.
- ⑦ 2 NO. 16 TSP (4-20mA) – 3/4"C. TO CONTROL PANEL 'RIO-RW'.
- ⑧ MANUFACTURER SUPPLIED CABLE(S) IN 3/4"C.
- ⑨ 10 NO. 12 – 3/4"C. TO CONTROL PANEL 'RIO-RW'.
- ⑩ NEW CONTROL PANEL 'RIO-RW'.

- ⑪ NO. 4/0 BARE COPPER CONDUCTOR FOR GROUND GRID.
- ⑫ NEW 5/8" X 20'-0" COPPER GROUND ROD.
- ⑬ NEW 5/8" X 20'-0" COPPER GROUND ROD WITH EXTERIOR TEST POINT.
- ⑭ NO. 1/0 GROUND CONDUCTOR IN 1"C TO GROUND GRID.
- ⑮ NO. 4 GROUND CONDUCTOR IN 1"C TO GROUND GRID.
- ⑯ NO. 6 GROUND CONDUCTOR IN 3/4"C TO GROUND GRID.
- ⑰ NO. 8 GROUND CONDUCTOR IN 3/4"C TO GROUND GRID.
- ⑱ 2 NO. 12 AND 1 NO. 12 E.G. – 3/4"C. TO CONTROL PANEL 'RIO-RW'.
- ⑲ LIGHT FIXTURE TO BE MOUNTED ABOVE DOOR.

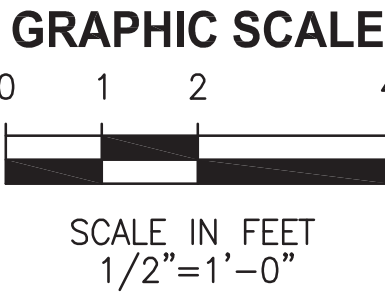

LTR.	DATE	REVISIONS	BY	APPRD.	CHECKED


DESIGNED RFB
 DRAWN AN
 CHECKED PSC

CARASTRO & ASSOCIATES, INC.
 CONSULTING ENGINEERS
 2609 W. DE LEON STREET TAMPA, FLORIDA 33609
 TELEPHONE: (813) 874-9494 WWW.CARASTRO.COM

CERTIFICATE OF AUTHORIZATION #1841
 730 NE WALDO ROAD, GAINESVILLE, FLORIDA 32641 / (352) 377-5821
 324 S HYDE PARK AVE, SUITE 250, TAMPA, FLORIDA 33606 / (813) 258-0703


AQUIFER RECHARGE AT FLATFORD SWAMP SOUTHWEST FLORIDA WATER MANAGEMENT DISTRICT	RECHARGE WELL BUILDING - ELECTRICAL PLANS	APPROVED BY PAUL S. CARASTRO P.E. # 45830	PROJECT NO: 19850-041-01	DATE: SEPT 2019
			INDEX NO: 	DWG NO: E6

MONITORING WELL ENCLOSURE
IN ACCORDANCE WITH THE
SOUTHWEST FLORIDA WATER
MANAGEMENT DISTRICT
(SWFWMD). SEE DRAWING M4.

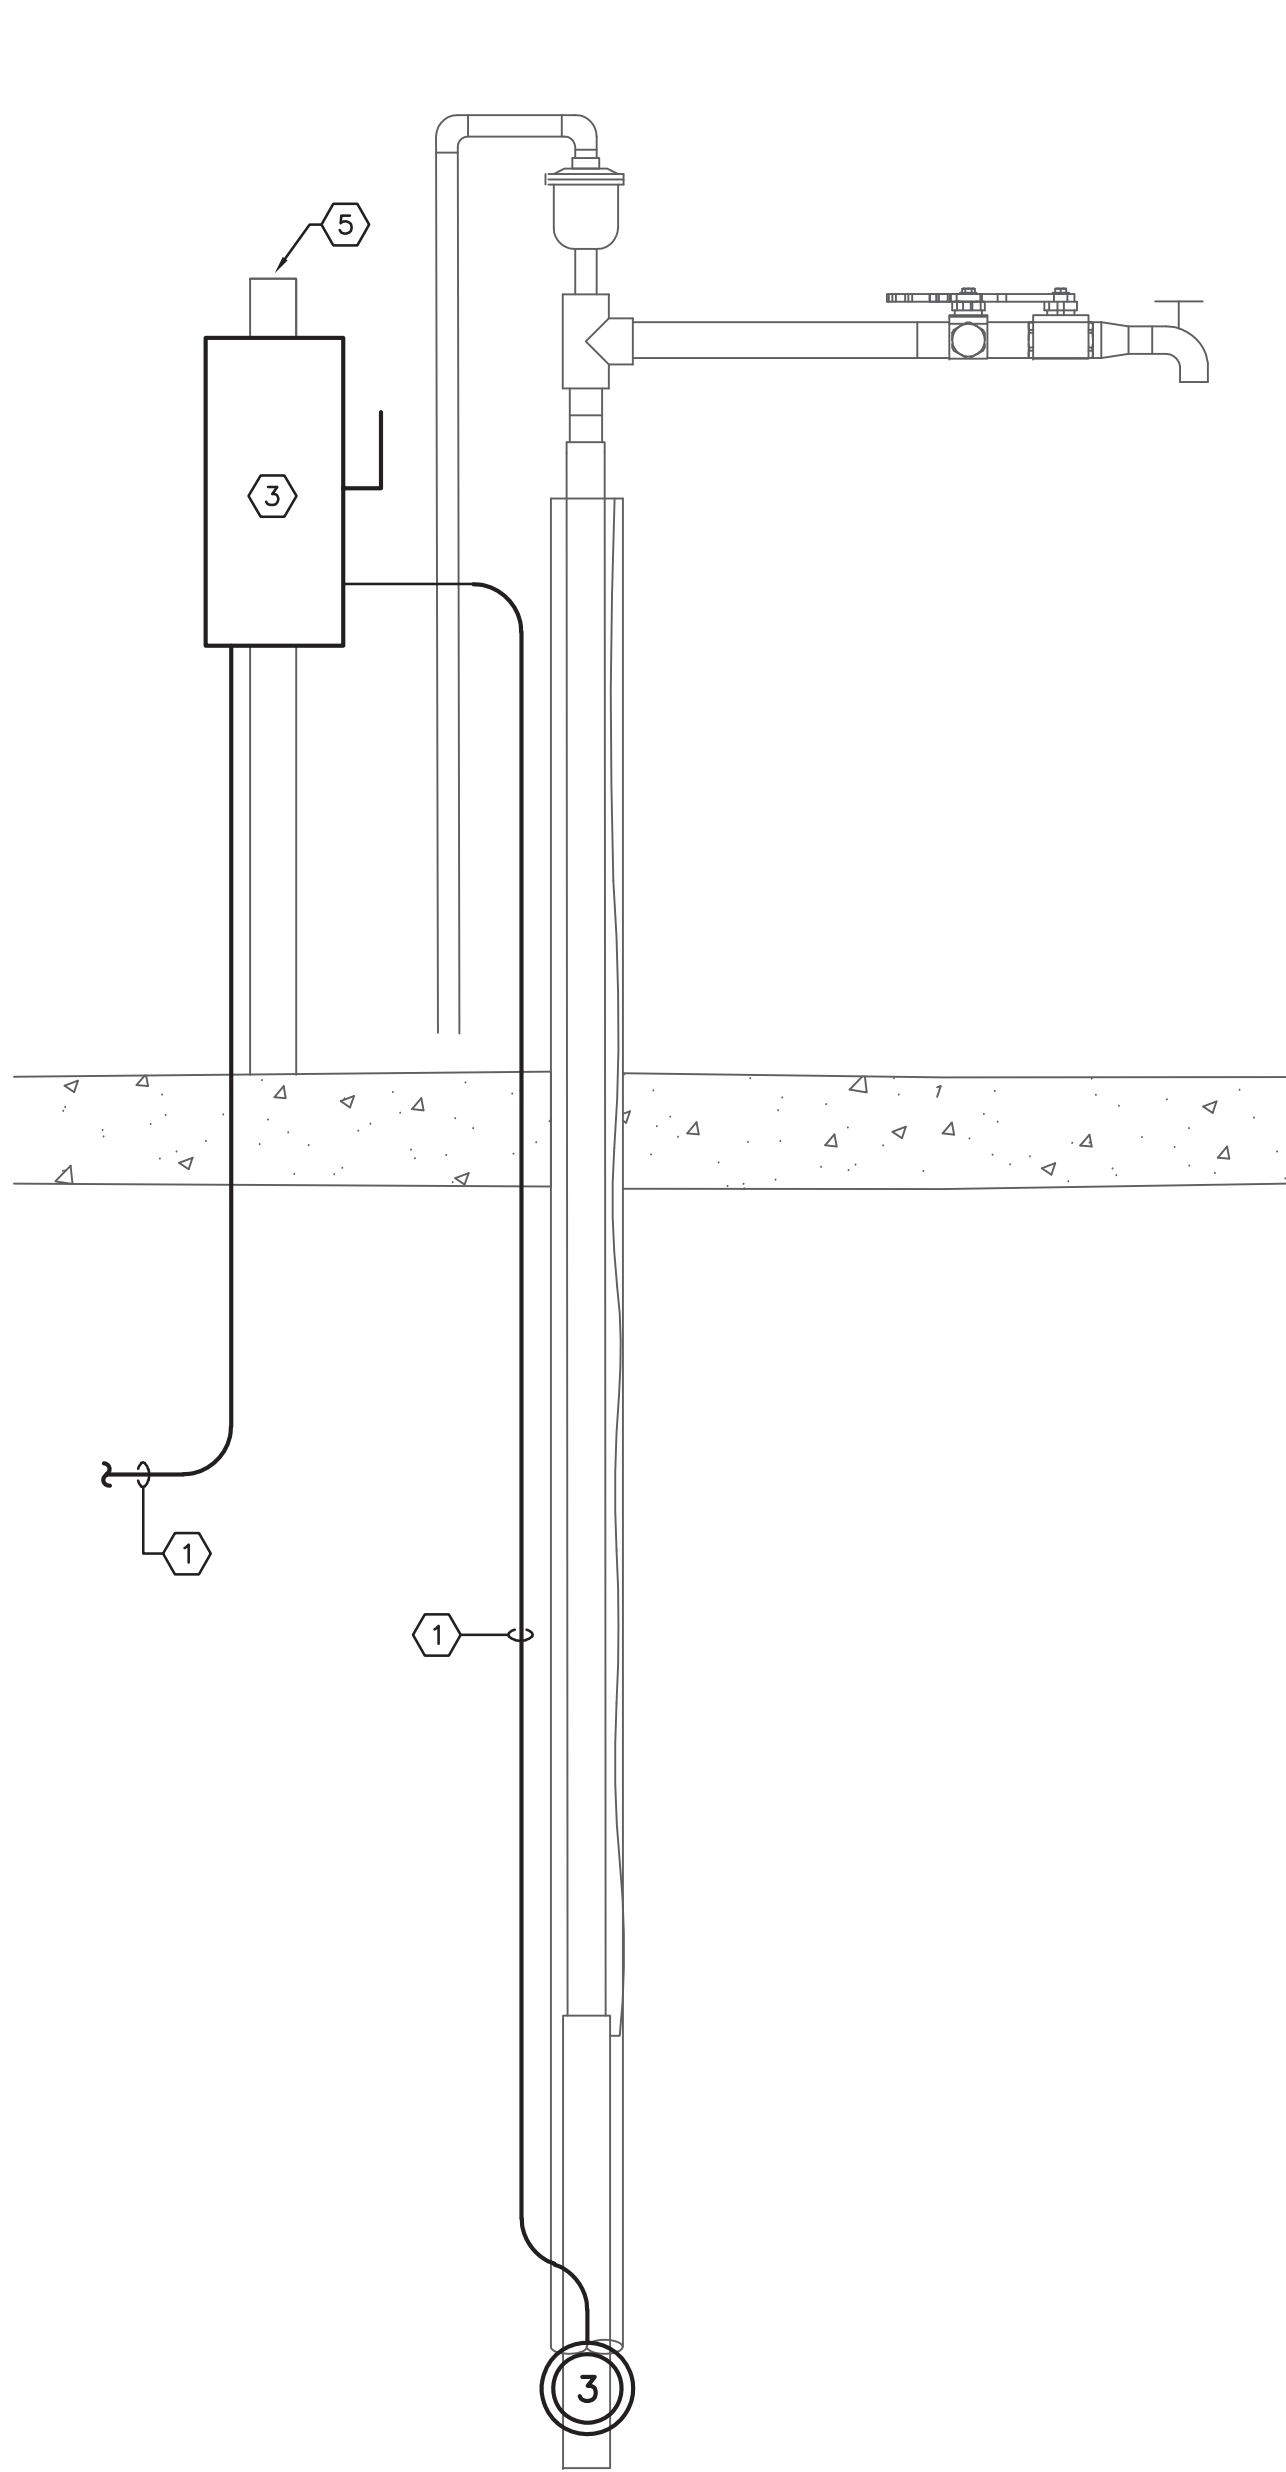

SUPPLY WELL DETAIL - ELECTRICAL

NOT TO SCALE

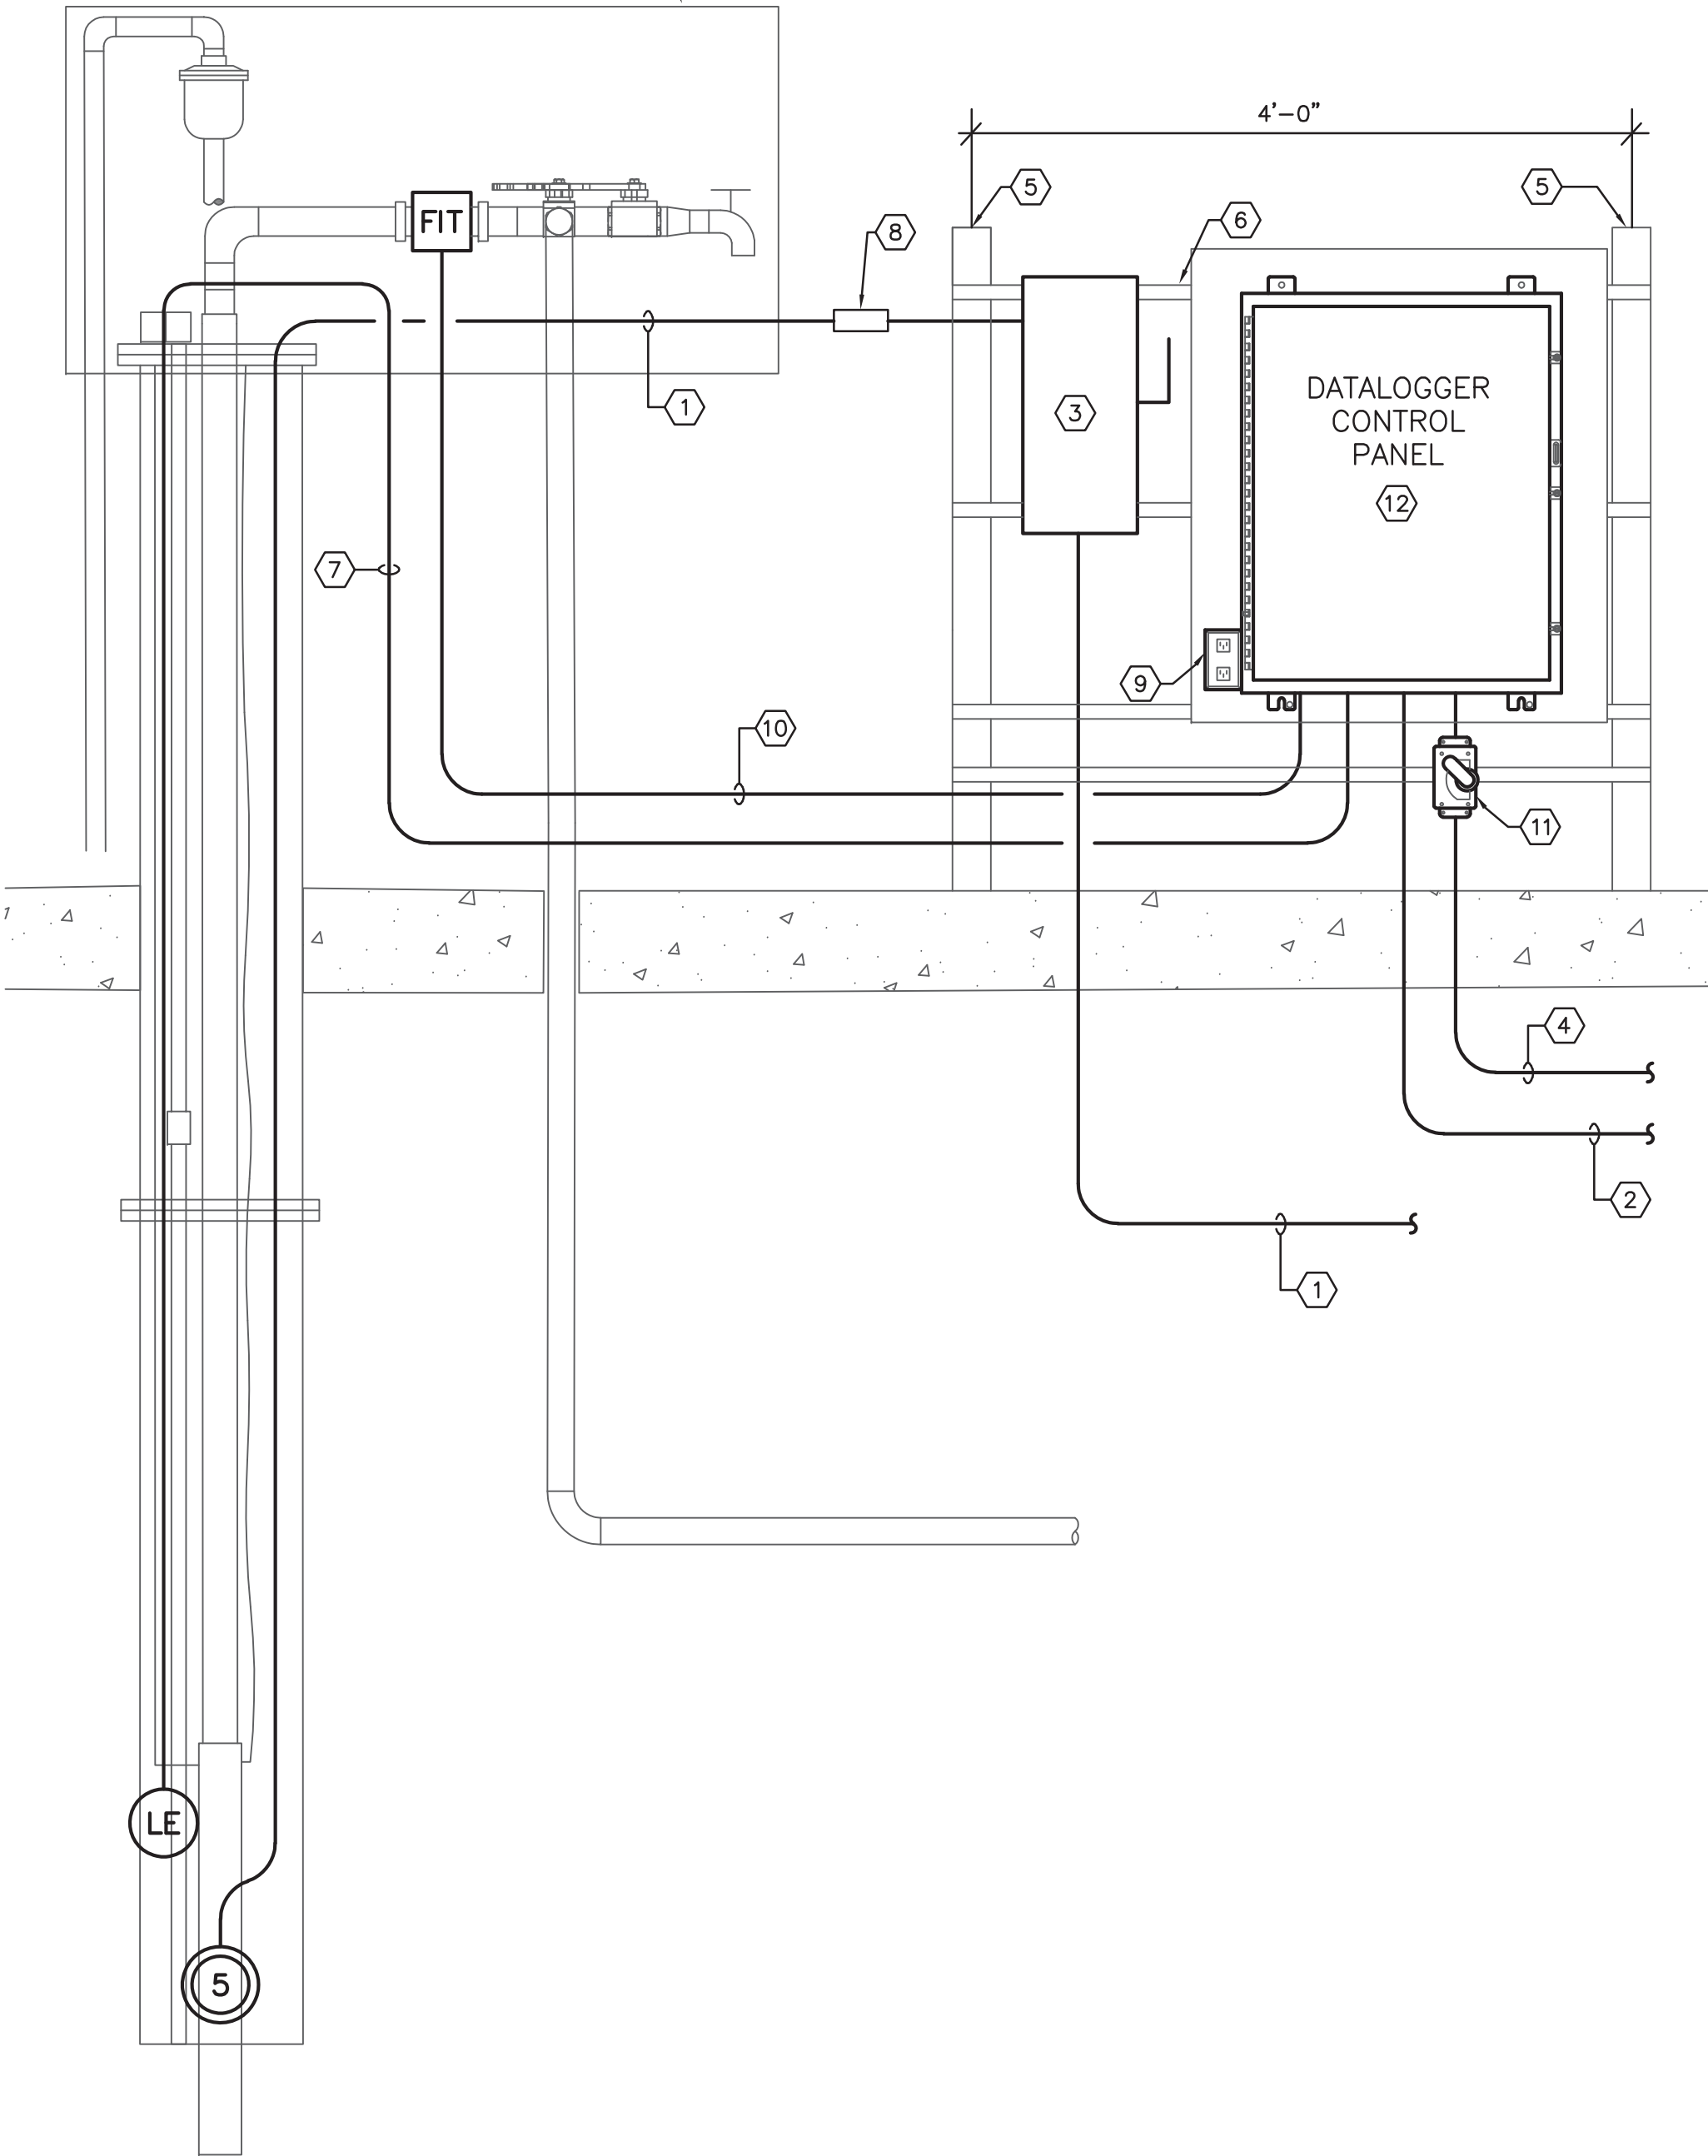

MONITORING WELL DETAIL - ELECTRICAL

NOT TO SCALE (TYPICAL FOR RZMW-1, RZMW-2 AND SLMW-1)

GENERAL NOTES:

1. COORDINATE EXACT ELECTRICAL REQUIREMENTS WITH 'SWFWMD TYPICAL DATA GROUND SITE INSTALLATION DIAGRAM'.

NOTES:

- ① SEE POWER ONE-LINE DIAGRAM FOR CONDUIT AND CONDUCTOR SIZES.
- ② TO NEAREST CONTROL PANEL 'CP1' OR 'CP2'.
- ③ SEE POWER ONE-LINE DIAGRAM FOR COMBINATION MOTOR STARTER SIZE.
- ④ NEW 120 VOLT CIRCUIT (POWER). SEE ELECTRICAL SITE PLAN AND PANEL SCHEDULE FOR ADDITIONAL INFORMATION.
- ⑤ 10'-0" CONCRETE 6"x6" POST. 6' ABOVE FINISHED GRADE.
- ⑥ 2 1/2"x2 1/2"x1/4" ALUMINUM ANGLE. (TYPICAL).
- ⑦ MANUFACTURER SUPPLIED CABLE(S) IN 3/4"C.
- ⑧ FURNISH AND INSTALL CONDUIT SEAL-OFF FITTING.
- ⑨ FURNISH AND INSTALL 120 VOLT (GFI) DUPLEX RECEPTACLE. DUPLEX RECEPTACLE ENCLOSURE TO BE PRECAST ALUMINUM WITH ALUMINUM (IN-USE) WEATHERPROOF COVERPLATE.
- ⑩ 2 NO.16 TSP (4-20mA) IN 3/4"C.
- ⑪ NEW 120 VOLT TOGGLE TYPE DISCONNECT SWITCH. FURNISH AND INSTALL NEW PRECAST ALUMINUM (1GANG) JUNCTION BOX AND ALUMINUM (WEATHERPROOF) COVER PLATE.
- ⑫ DISTRICT (OWNER) WILL PROVIDE CAMPBELL SCIENTIFIC TRANSDUCERS, DATA LOGGERS, AND THE WIFI FOR ALL (3) MONITORING WELLS.

CARASTRO &
ASSOCIATES, INC.

CONSULTING ENGINEERS EB-0001160
2609 W. DE LEON STREET TAMPA, FLORIDA 33609
TELEPHONE: (813) 874-9494 WWW.CARASTRO.COM


JonesEdmunds

CERTIFICATE OF AUTHORIZATION #1841
730 NE WALDO ROAD, GAINESVILLE, FLORIDA 32641 / (352) 377-5821
324 S HYDE PARK AVE, SUITE 250, TAMPA, FLORIDA 33606 / (813) 258-0703

AQUIFER RECHARGE AT FLATFORD SWAMP
SOUTHWEST FLORIDA WATER MANAGEMENT DISTRICT


MONITORING WELL DETAIL - ELECTRICAL

PROJECT NO: 19850-041-01	DATE: SEPT 2019
INDEX NO:	DWG NO: E7

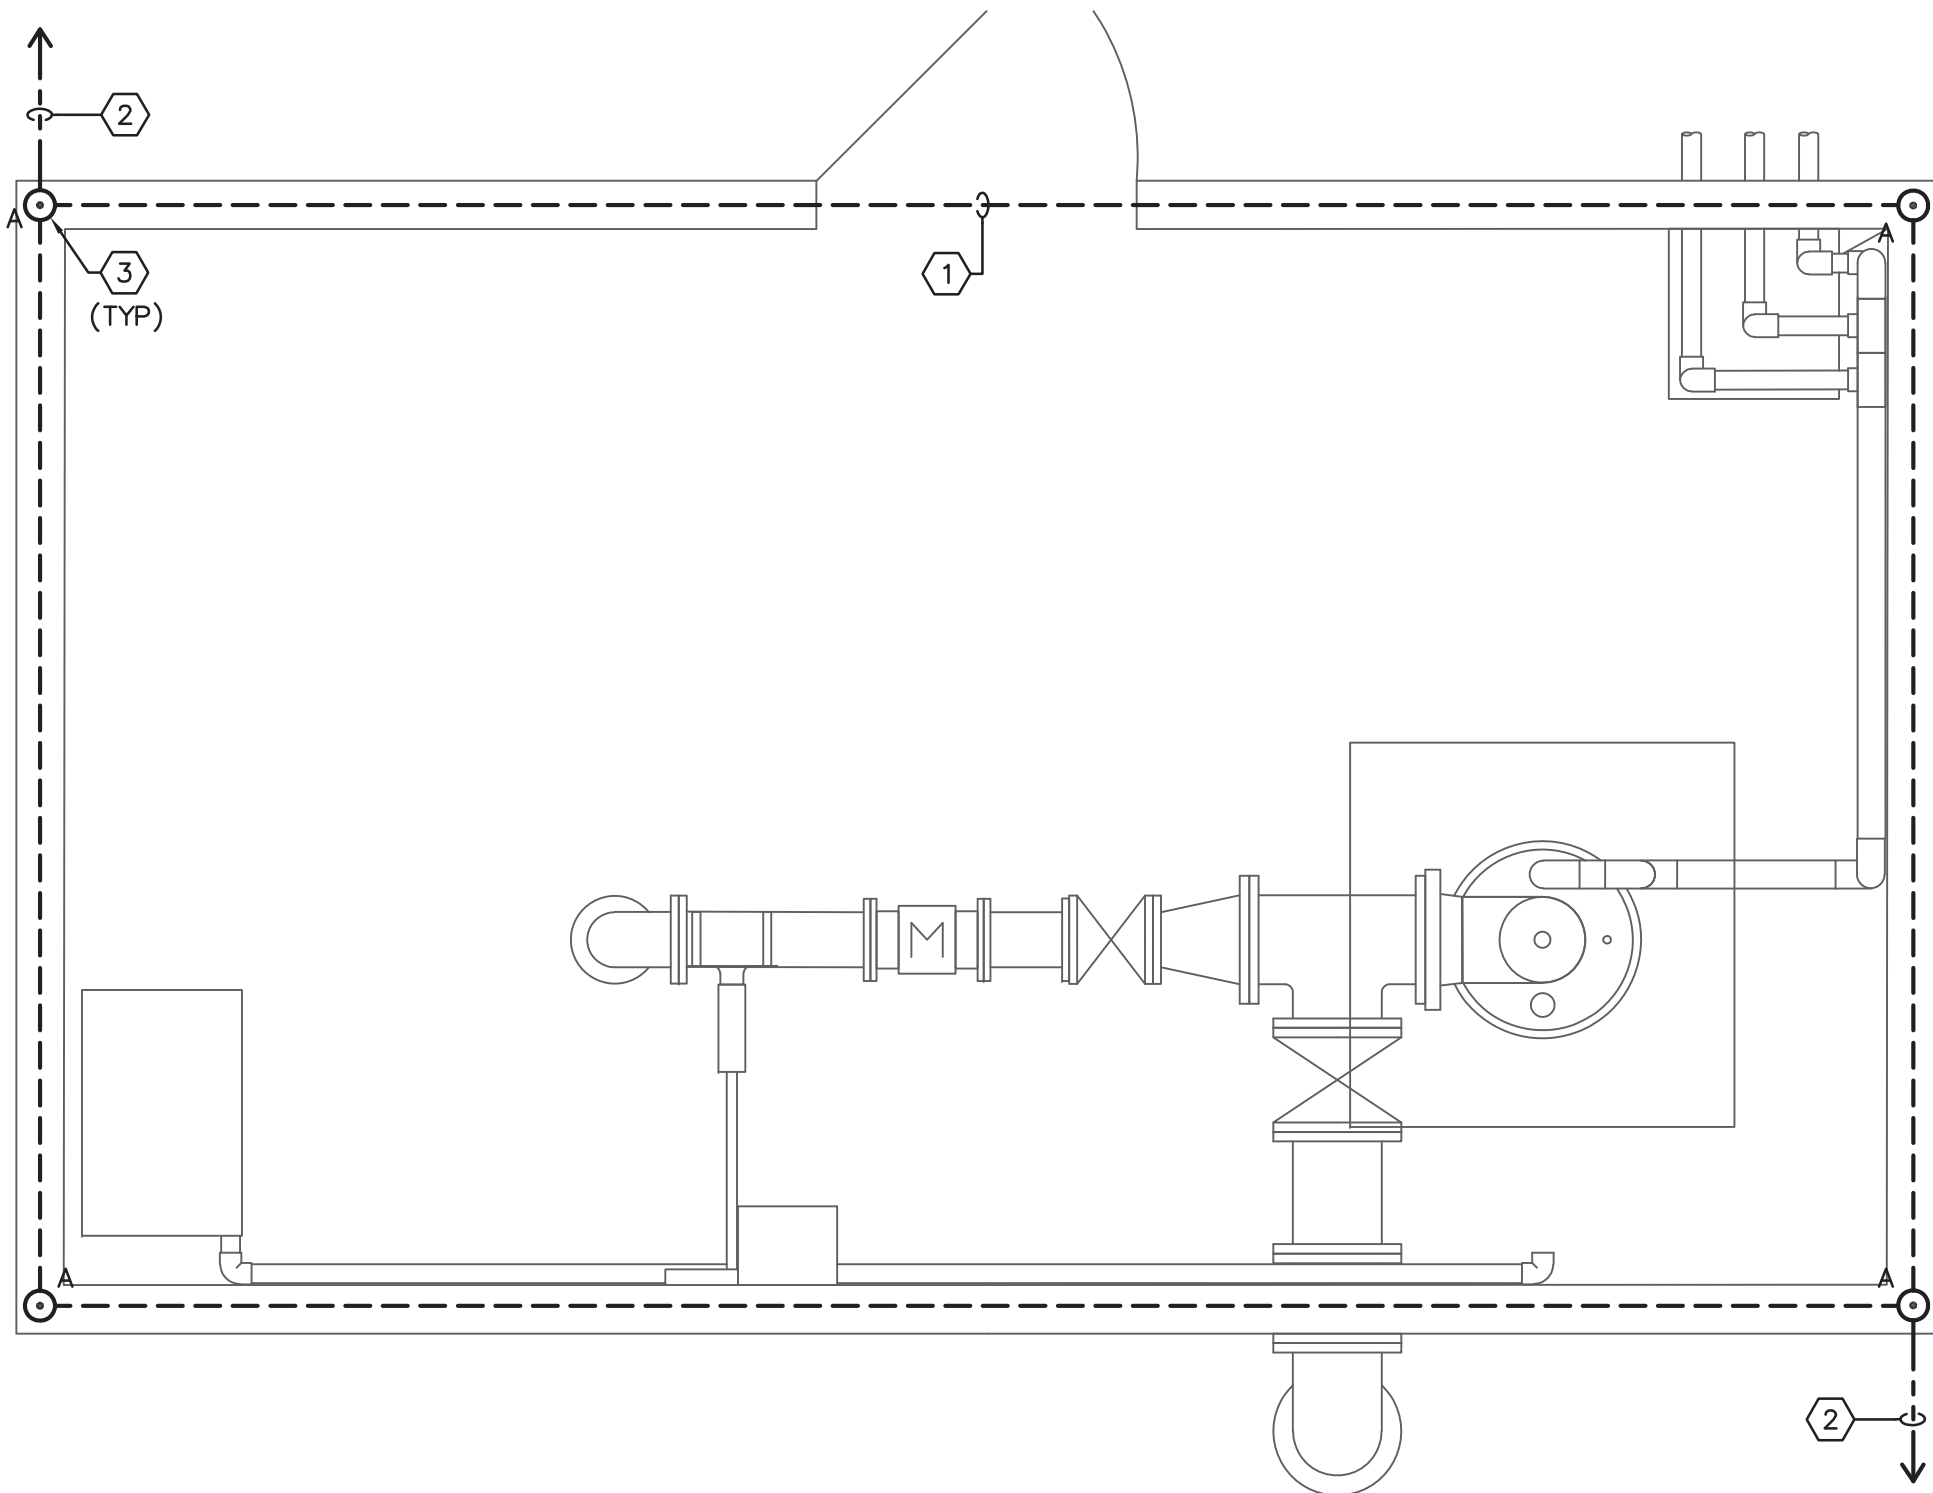

RECHARGE WELL BUILDING - LIGHTNING PROTECTION PLAN


SCALE: 1/2"=1'-0"

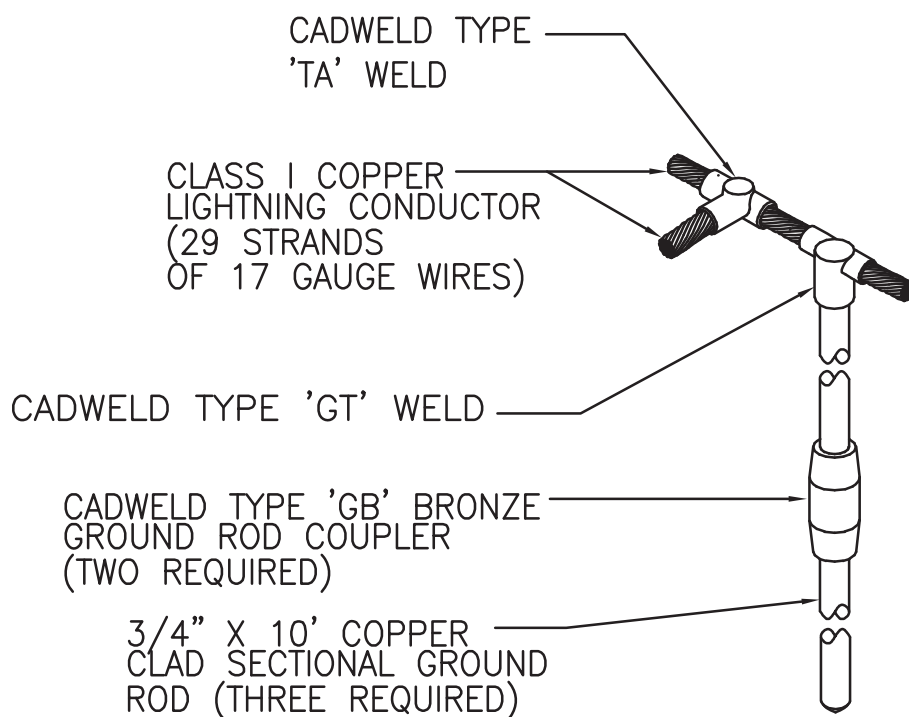


NOT TO SCALE

LIGHTNING PROTECTION AND GROUNDING SYSTEM GENERAL NOTES:


8. LIGHTNING CONDUCTORS ARE TO MAINTAIN A HORIZONTAL OR DOWNWARD PATH, AND ALL BENDS IN THE CONDUCTOR SHALL HAVE A RADIUS OF NOT LESS THAN 8" AND SHALL NOT BE LESS THAN 90°.
9. ATTACH ALL EXPOSED ROOF, DOWN LEAD, AND BONDING CABLES AT 3'-0" ON CENTER MAXIMUM. VERIFY COMPATIBILITY OF ADHESIVE ON MEMBRANE ROOF APPLICATIONS PRIOR TO INSTALLATION.
10. GROUND ELECTRODES SHALL BE INSTALLED AS SHOWN BUT IN NO INSTANCE SHALL THEY BE LESS THAN 36 INCHES BELOW GRADE AND 6'-0" FROM FOUNDATION WALL.
11. ALL MATERIAL TO BE UNDERWRITER'S LABORATORIES APPROVED WITH LABELS ON CONDUCTORS @ 10'-0" INTERVALS AND LABELS ON AIR TERMINALS.
12. PVC CONDUITS CONTAINING LIGHTNING PROTECTION SYSTEM CONDUCTORS SHALL BE FREE OF ALL METAL SUPPORTS AND CLAMPS. USE NON-METALLIC STRAYS AND FASTENERS.
13. ALL ABOVE GRADE BONDING CONNECTIONS UNLESS OTHERWISE NOTED SHALL BE STAINLESS STEEL OR SOLID COPPER. NO STEEL CADMIUM PLATED MATERIALS WILL BE ACCEPTED.
14. UPON COMPLETION OF LIGHTNING PROTECTION AND GROUNDING SYSTEMS, FURNISH U.L. MASTER LABEL AND INSTALL ON EXTERIOR WALL OF BUILDING WHERE DIRECTED BY OWNER.
15. NO ROOF PENETRATIONS WILL BE ALLOWED.

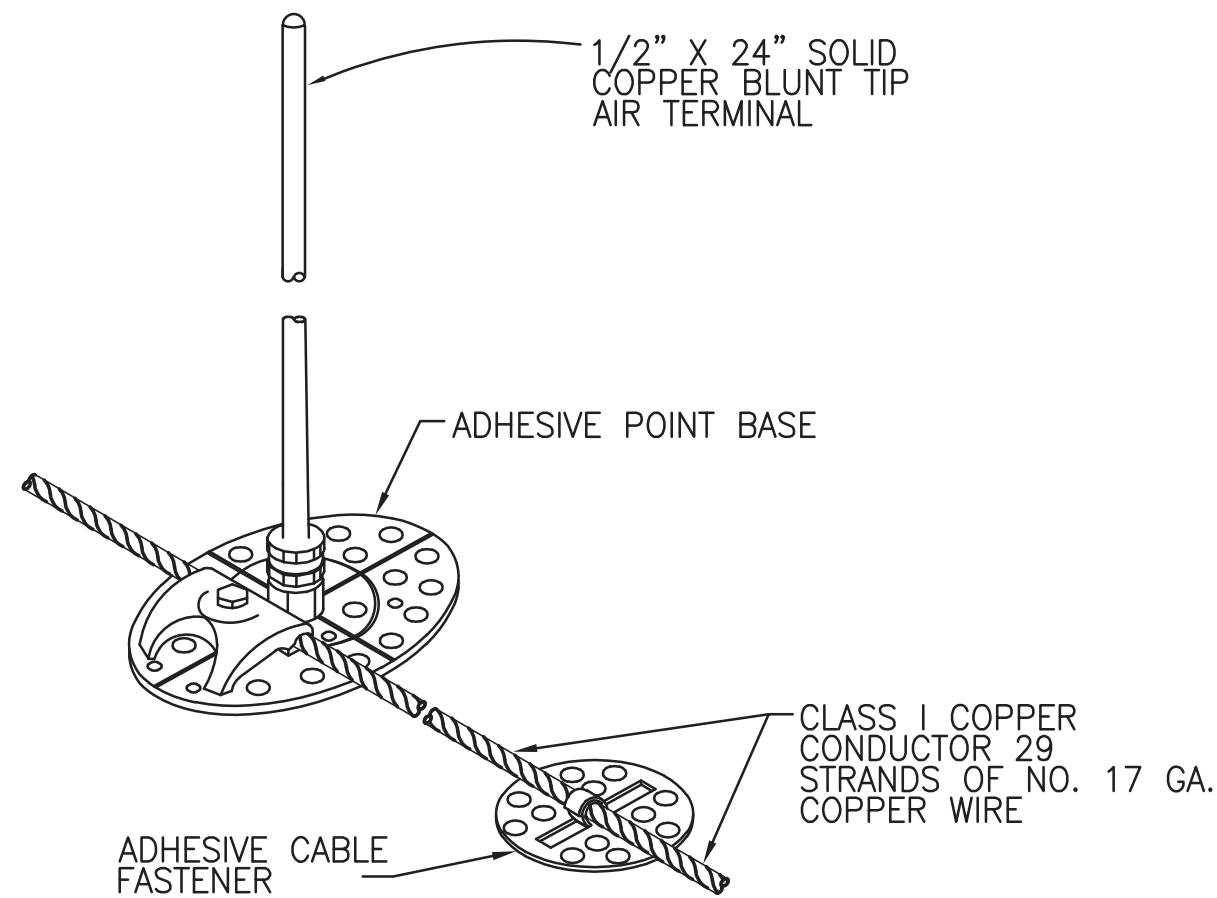

NOT TO SCALE

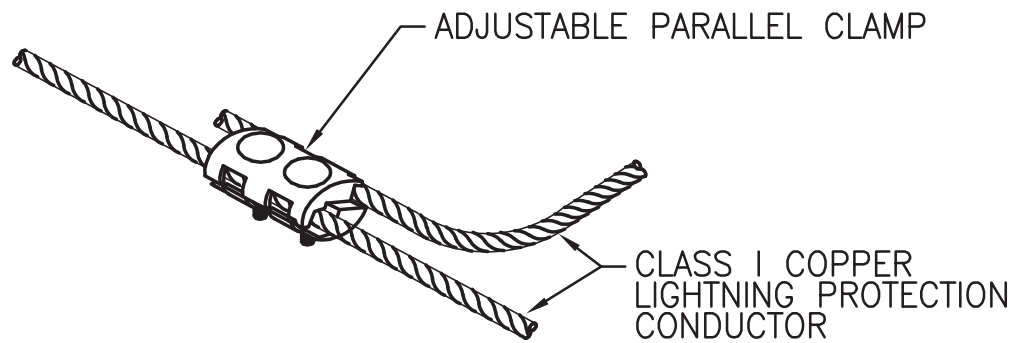

NOT TO SCALE

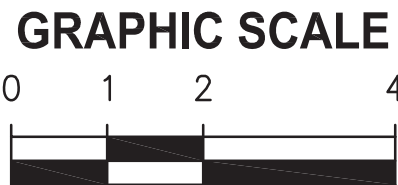

SCALE IN FEET
1/2"=1'-0"

					DESIGNED	<u>RFB</u>
					DRAWN	<u>AN</u>
					CHECKED	<u>PSC</u>
LTR.	DATE	REVISIONS	BY	APPRD.		

CONSULTING ENGINEERS EB-0001160
2609 W. DE LEON STREET TAMPA, FLORIDA 33609
TELEPHONE: (813) 874-9494 WWW.CARASTRO.COM

AQUIFER RECHARGE AT FLATFORD SWAMP
SOUTHWEST FLORIDA WATER MANAGEMENT DISTRICT


RECHARGE PUMP AND RECHARGE WELL BUILDING LIGHTNING PROTECTION PLANS

APPROVED BY	PROJECT NO:	DATE:
	19850-041-01	SEPT 2019
PAUL S. CARASTRO	INDEX NO:	DWG NO:
	P.E. # 45830	E8

① CIRCUIT BREAKER TO INCLUDE TERMINATION LUGS TO SUPPORT LARGER CONDUCTORS. SEE POWER ONE-LINE DIAGRAM.

② PANELBOARD CONTAINS HI-LEG ON (B-PHASE). DO NOT CONNECT 120 VOLT CIRCUIT ON (B-PHASE) LEG.

BA

					DESIGNED	RFB	<div><p>CERTIFICATE OF AUTHORIZATION #1841 730 NE WALDO ROAD, GAINESVILLE, FLORIDA 32641 / (352) 377-5821 324 S HYDE PARK AVE, SUITE 250, TAMPA, FLORIDA 33606 / (813) 258-0703</p></div>	AQUIFER RECHARGE AT FLATFORD SWAMP SOUTHWEST FLORIDA WATER MANAGEMENT DISTRICT	PANEL SCHEDULES	APPROVED BY	PROJECT NO:	DATE:
				DRAWN	AN	19850-041-01				SEPT 2019		
				CHECKED	PSC	INDEX NO:				DWG NO:		
LTR.	DATE	REVISIONS	BY	APPRD.	P.E. # 45830	E9						

P:\-6299\6231\ELEC\6231-E10.DWG
 RICHARD BARBEITO
 9/27/2019 1:45 PM

BID SET

PANELBOARD:					MAIN: 400 A MCB ①										MOUNT: SURFACE				
P2					ENCLOSURE: NEMA 4X (316 STAINLESS STEEL)										AIC: 42,000				
SERVICE: 277 / 480 V, 3Φ, 4W					FEED THRU LUGS: NO														
CKT NUM	DESCRIPTION	CODE	BREAKER		CONNECTED LOAD (KVA)										BREAKER		CODE	DESCRIPTION	CKT NUM
			A	P	A	B	C	A	B	C	A	P							
1	SUBMERSIBLE PURGE PUMP	MTR	225	3	32.89									--	1	--	SPACE	2	
3	↓	MTR	↓	↓		32.89								--	1	--	SPACE	4	
5	↓	MTR	↓	↓			32.98							--	1	--	SPACE	6	
7	SPACE	--	--	1										--	1	--	SPACE	8	
9	SPACE	--	--	1										--	1	--	SPACE	10	
11	SPACE	--	--	1										--	1	--	SPACE	12	
13	SPACE	--	--	1										--	1	--	SPACE	14	
15	SPACE	--	--	1										--	1	--	SPACE	16	
17	SPACE	--	--	1										--	1	--	SPACE	18	
19	SPACE	--	--	1										--	1	--	SPACE	20	
21	SPACE	--	--	1										--	1	--	SPACE	22	
23	SPACE	--	--	1										--	1	--	SPACE	24	
25	SPACE	--	--	1										--	1	--	SPACE	26	
27	SPACE	--	--	1										--	1	--	SPACE	28	
29	SPACE	--	--	1										--	1	--	SPACE	30	
31	SPACE	--	--	1										--	1	--	SPACE	32	
33	SPACE	--	--	1										--	1	--	SPACE	34	
35	SPACE	--	--	1										--	1	--	SPACE	36	
37	L2	PNL	50	3	7.45									30	3	--	SPD (SURGE PROTECTION DEVICE)	38	
39	↓	PNL	↓	↓		7.82								↓	↓	--	↓	40	
41	↓	PNL	↓	↓			5.71							↓	↓	--	↓	42	
					TOTAL KVA	Phase A 40.34	Phase B 40.71	Phase C 38.7											
					CONNECTED LOAD (KVA)	DEMAND FACTOR	DEMAND LOAD (KVA)	MIN NEC LOAD (KVA)	MIN NEC LOAD (AMPS)										
LIGHTING (LTG)					0.7	1.25	0.7	0.9		* PER NEC 215.3									
RECEPTACLES (REC)					0.7	*	0.7	0.7		* PER NEC 220.44									
AC (NON COINCID)(AC NC)					0.0	1.0	0.0	0.0		* PER NEC 220.60									
HEAT (NON COINCID)(H NC)					0.0	1.0	0.0	0.0		* PER NEC 220.60									
HVAC (COINCID)(HVAC C)					0.0	1.0	0.0	0.0											
EQUIPMENT (EQ)					0.0	1.0	0.0	0.0											
MOTORS (MTR)					15.93	1.0	15.9	15.9											
LARGEST MOTOR					98.76	1.25	98.8	123.5		* PER NEC 430.24									
MISCELLANEOUS (MISC)					3.6	1.0	3.6	3.6											
EXISTING DEMAND (NEC 220.87)					N/A		0.0	0.0											
TOTAL					119.7		119.7	144.6		173.9 AMPS									

PANELBOARD:					MAIN: 100 A MC3										MOUNT: SURFACE				
L2 ②					ENCLOSURE: NEMA 4X (316 STAINLESS STEEL)										AIC: 10,000				
SERVICE: 120 / 240 V, 3Ø, 4W					FEED THRU LUGS: NO														
CKT NUM	DESCRIPTION	CODE	BREAKER		CONNECTED LOAD (KVA)							BREAKER		CODE	DESCRIPTION	CKT NUM			
			A	P	A	B	C		A	B	C		A				P		
1	MONITORING WELL PUMP (RZMW-2)	MTR	35	3	2.02				2.02				35	3	MTR	MONITORING WELL PUMP (SLMW-1)	2		
3	↓	MTR	↓	↓		2.02				2.02			↓	↓	MTR	↓	4		
5	↓	MTR	↓	↓			2.02				2.02		↓	↓	MTR	↓	6		
7	CONTROL PANEL 'RIO-ASR'	MISC	20	1	1.20				0.36				20	1	REC	RECEPTACLES	8		
9	BOREHOLE INJ. VALVE CONTROL PANEL	MISC	20	1		1.20				0.73			20	1	LTG	LIGHTING	10		
11	SUPPLY WELL PUMP (SW-1)	MTR	20	3			1.27						20	1		SPARE	12		
13	↓	MTR	↓	↓	1.27								20	1		SPARE	14		
15	↓	MTR	↓	↓		1.27				0.40			20	1	MISC	DO PROBE MODULE & DISPLAY (AIT-1)	16		
17	RECEPTACLE	REC	30	1									20	1		SPARE	18		
19	DATALOGGER (SLMW-1)	MISC	20	1	0.40									1		SPACE	20		
21	DATALOGGER (RZMW-2) RECEPTACLE	REC	20	1		0.18								1	--	SPACE	22		
23	DATALOGGER (RZMW-2)	MISC	20	1			0.40							1	--	SPACE	24		
25	DATALOGGER (RZMW-2) RECEPTACLE	REC	20	1	0.18									1	--	SPACE	26		
27	SPARE	--	20	1									--	1	--	SPACE	28		
29	SPARE	--		1										1	--	SPACE	30		
31	SPARE	--		1									--	1	--	SPACE	32		
33	SPACE	--	--	1									--	1	--	SPACE	34		
35	SPACE	--		1									--	1	--	SPACE	36		
37	SPD (SURGE PROTECTION DEVICE)	--	30	3									--	1	--	SPACE	38		
39	↓	--	↓	↓									--	1	--	SPACE	40		
41	↓	--	↓	↓									--	1	--	SPACE	42		
					TOTAL KVA	Phase A 7.45	Phase B 7.82	Phase C 5.7											
					CONNECTED LOAD (KVA)	DEMAND FACTOR	DEMAND LOAD (KVA)	MIN NEC LOAD (KVA)	MIN NEC LOAD (AMPS)										
LIGHTING (LTG)					0.7	1.25	0.7	0.9	* PER NEC 215.3										
RECEPTACLES (REC)					0.7	*	0.7	0.7	* PER NEC 220.44										
AC (NON COINCID)(AC NC)					0.0	1.0	0.0	0.0	* PER NEC 220.60										
HEAT (NON COINCID)(H NC)					0.0	1.0	0.0	0.0	* PER NEC 220.60										
HVAC (COINCID)(HVAC C)					0.0	1.0	0.0	0.0											
EQUIPMENT (EQ)					0.0	1.0	0.0	0.0											
MOTORS (MTR)					9.87	1.0	9.9	9.9											
LARGEST MOTOR					6.06	1.25	6.1	7.6	* PER NEC 430.24										
MISCELLANEOUS (MISC)					3.6	1.0	3.6	3.6											
EXISTING DEMAND (NEC 220.87)					N/A		0.0	0.0											
TOTAL					21.0		21.0	22.7	54.6 AMPS										

NOTES:

- ① CIRCUIT BREAKER TO INCLUDE TERMINATION LUGS TO SUPPORT LARGER CONDUCTORS. SEE POWER ONE-LINE DIAGRAM.
- ② PANELBOARD CONTAINS HI-LEG ON (B-PHASE). DO NOT CONNECT 120 VOLT CIRCUIT ON (B-PHASE) LEG.

CARASTRO &
 ASSOCIATES, INC.

CONSULTING ENGINEERS
 2609 W. DE LEON STREET TAMPA, FLORIDA 33609
 TELEPHONE: (813) 874-9494 WWW.CARASTRO.COM

JonesEdmunds

CERTIFICATE OF AUTHORIZATION #1841
 730 NE WALDO ROAD, GAINESVILLE, FLORIDA 32641 / (352) 377-5821
 324 S HYDE PARK AVE, SUITE 250, TAMPA, FLORIDA 33606 / (813) 258-0703

AQUIFER RECHARGE AT FLATFORD SWAMP
 SOUTHWEST FLORIDA WATER MANAGEMENT DISTRICT

PANEL SCHEDULES

APPROVED BY

PAUL S. CARASTRO
 P.E. # 45830

PROJECT NO:
 19850-041-01

SAVED: 10/1/2019 5:10 PM RICHARD.BARBETTO P:\-6299\6231\p&id\FLATFORD-BIDSET 10-1-19\1- FLATFORD SYMBOLS & ABBREVIATIONS.DWG

GENERAL INSTRUMENT OR FUNCTION SYMBOLS	
	DISTRIBUTED CONTROL—NORMALLY ACCESSIBLE TO OPERATOR
	DISCRETE INSTRUMENT — FIELD MOUNTED
	DISCRETE INSTRUMENT — PRIMARY LOCATION NORMALLY ACCESSIBLE TO OPERATOR ①
	DISCRETE INSTRUMENT — AUXILIARY LOCATION NORMALLY ACCESSIBLE TO OPERATOR ①
	INSTRUMENTS SHARING COMMON HOUSING
	INSTRUMENT FURNISHED WITH SPECIFIC FIELD COMPONENT (EG. PUMP, NLOWER, VALVE, CONVEYOR, ETC.)
	CONTROL INTERLOCK
	CONTROL SYSTEM I/O INTERFACE — ANALOG SIGNAL TRIANGLE DENOTES WHETHER INPUT OR OUTPUT.
	CONTROL SYSTEM I/O INTERFACE — DISCRETE SIGNAL TRIANGLE DENOTES WHETHER INPUT OR OUTPUT.
	DIAPHRAGM SEAL
	FIBER OPTIC CABLE
	ETHERNET CABLE
	ANALOG CABLE

PROCESS DEVICE SYMBOLS	
	REDUCER OR ENLARGER
	PRIMARY ELEMENT VENTURI TUBE
	PRIMARY ELEMENT MAGNETIC FLOWMETER
	PRIMARY ELEMENT ULTRASONIC DOPPLER FLOWMETER
	PRIMARY ELEMENT PARSCHALL FLUME
	PRIMARY ELEMENT ORIFICE PLATE
	PRIMARY ELEMENT WEIR FLOWMETER
	PRIMARY ELEMENT TURBINE OR PROPELLER TYPE METER
	PRIMARY ELEMENT PITOT TUBE
	PRIMARY ELEMENT ROTAMETER
	PRIMARY ELEMENT ULTRASONIC TRANSIT TIME METER
	PRIMARY ELEMENT ULTRASONIC DOPPLER METER
	PRIMARY ELEMENT ULTRASONIC FLOW OR LEVEL METER
	FLOAT SWITCH
	DRAIN
	CHEMICAL INJECTION POINT
	MIXER

PROCESS DEVICE SYMBOLS (CONTINUED)	
	VALVE: GLOBE OR OTHER IN-LINE TYPE, UNLESS OTHERWISE INDICATED.
	BUTTERFLY VALVE
	CHECK VALVE WITH FLOW DIRECTION AS INDICATED
	PLUG VALVE
	PRESSURE REGULATING VALVE — SELF CONTAINED
	FLOW CONTROL GATE OR GATE VALVE
	CENTRIFUGAL BLOWER
	POSITIVE DISPLACEMENT BLOWER
	CENTRIFUGAL PUMP
	SUBMERSIBLE PUMP
	DIAPHRAGM PUMP & MOTOR
	DISC FLOW OR PROGRESSIVE CAVITY PUMP
	VERTICAL PUMP
	MOTOR — MAY BE ELECTRIC, HYDRAULIC, OR PNEUMATIC ARROW DENOTES VARIABLE SPEED

ABBREVIATIONS


AIT	ANALYSIS INDICATING TRANSMITTER
AFD	ADJUST FREQUENCY DRIVE
BC	BYPASS CONTACTOR
BFI	BLOWN FUSE INDICATOR
C	CONTACTOR
CB	CIRCUIT BREAKER
CPT	CONTROL POWER TRANSFORMER
CR	CONTROL RELAY
CRI	CONTROL RELAY, INTRINSIC
CRL	CONTROL RELAY, LATCH
DFR	DRIVE FAIL RELAY
DI	DIGITAL INDICATOR
DUP	DUPLEXOR
DRR	DRIVE RUN RELAY
DSC	DISCONNECT SWITCH
ETM	ELAPSED TIME METER
FE	FLOW ELEMENT
FIT	FLOW INDICATING TRANSMITTER
FSR	FLOAT SWITCH RELAY
FU	FUSE
GRD	GROUND
HS	HAND SWITCH
IC	ISOLATION CONTACTOR
ISO	SIGNAL ISOLATOR/BOOSTER
LT	PILOT LIGHT
LE	LEVEL ELEMENT/TRANSDUCER
LIT	LEVEL INDICATING TRANSMITTER
LS	LEVEL SWITCH
M	MOTOR STARTER
MCC	MOTOR CONTROL CENTER
MCP	MOTOR CIRCUIT PROTECTOR
MSP	MAIN SURGE PROTECTOR
OL	OVERLOAD
PB	PUSH BUTTON
PDB	POWER DISTRIBUTION BLOCK
PI	PRESSURE INDICATOR (PRESSURE GAUGE)
PIT	PRESSURE INDICATING TRANSMITTER
RIO	REMOTE I/O PANEL
POT	POTENTIOMETER
PM	PHASE MONITOR
PS	POWER SUPPLY
RCR	RUN COMMAND RELAY
RES	RESISTOR
S	SWITCH
SP	SURGE PROTECTOR
SS	SELECTOR SWITCH
SSRV	SOLID STATE REDUCED VOLTAGE STARTER
TB	TERMINAL BOARD, TERMINAL BLOCK
TC	TIME CLOCK
TR	TIME DELAY RELAY
TS	TEMPERATURE SWITCH
VFD	VARIABLE FREQUENCY DRIVE
XFMR	TRANSFORMER
ZS	LIMIT SWITCH

GENERAL NOTES

- THIS IS A GENERAL LEGEND SHEET. SOME SYMBOLS & ABBREVIATIONS MAY NOT APPLY TO THIS SPECIFIC PROJECT
- THIS LEGEND APPLIES TO INSTRUMENTATION DIAGRAM ONLY, & ITS SYMBOLS MAY NOT BE APPLICABLE TO NON-INSTRUMENTATION DRAWINGS
- THIS LEGEND SHEET & THE INSTRUMENTATION DIAGRAMS & I -DRAWINGS ARE GENERALLY BASED ON THE INSTRUMENT SOCIETY OF AMERICA'S STANDARDS FOR PRACTICES IN INSTRUMENTATION SOME MODIFICATIONS, ADDITIONS, & ALTERATIONS MAY HAVE BEEN MADE TO ACCOMMODATE INDIVIDUAL PROJECT REQUIREMENTS
- SOME PROCESS ITEMS (SUCH AS EQUIPMENT ISOLATION VALVES, BYPASS LINES, ETC.) WHICH ARE NOT CRITICAL FOR AN UNDERSTANDING OF THE INSTRUMENTATION FUNCTIONS ARE NOT SHOWN ON THE INSTRUMENTATION SHEETS.
- SEE ELECTRICAL SHEETS & SPECIFICATIONS FOR ADDITIONAL CONTROL & INTERLOCK REQUIREMENTS FOR EQUIPMENT NOT SHOWN OR NOT PROVIDED BY THE INSTRUMENTATION SUPPLIER

INSTRUMENT IDENTIFICATION

EXAMPLE

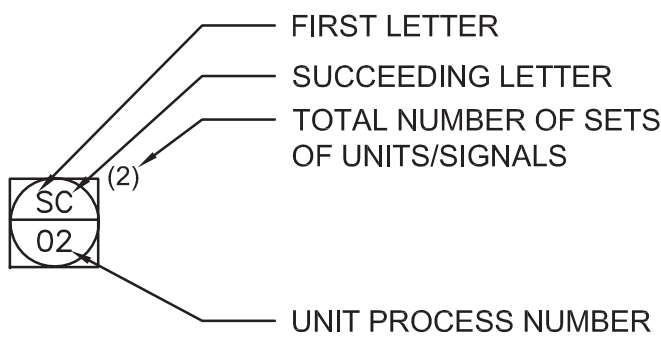

INSTRUMENTATION IDENTIFICATION LETTERS

	FIRST LETTER		SUCCEEDING LETTERS		
	MEASURED OR INITIATING VARIABLE	MODIFIER	READOUT OR PASSIVE FUNCTION	OUTPUT FUNCTION	MODIFIER
A	ANALYSIS		ALARM		
B	BURNER, COMBUSTION		EMERGENCY	USER'S CHOICE	USER'S CHOICE
C	USER'S CHOICE		CLEANER	CONTROL	
D	DENSITY (MASS) OR SPECIFIC GRAVITY	DIFFERENTIAL			
E	VOLTAGE (EMF)		PRIMARY ELEMENT		
F	FLOW RATE	RATIO (FRACTION)			
G	GAUGING (DIMENSIONAL)		GLASS		
H	HAND (MANUALLY INITIATED)				HIGH OR OPEN
I	CURRENT (ELECTRICAL)		INDICATE		
J	POWER	SCAN			
K	TIME OR TIME SCHEDULE			CONTROL STATION	
L	LEVEL		LIGHT (PILOT)		LOW OR CLOSED
M	USER'S CHOICE	MOMENTARY			MIDDLE OR INTERMEDIATE
N	USER'S CHOICE		USER'S CHOICE	USER'S CHOICE	USER'S CHOICE
O	USER'S CHOICE		ORIFICE (RESTRICTION)		
P	PRESSURE OR VACUUM		POINT (TEST CONNECTION)		
Q	QUANTITY	INTEGRATE OR TOTALIZE			
R	RUN		RECORD		
S	SPEED OR FREQUENCY	SAFETY		SWITCH	
T	TEMPERATURE			TRANSMIT	
U	MULTIVARIABLE		MULTIFUNCTION	MULTIFUNCTION	MULTIFUNCTION
V	VISCOSITY, VIBRATION			VALVE, DAMPER, OR LOUVER	
W	WEIGHT OR TORQUE		WELL		
X	FAILURE	X AXIS			
Y	EVENT, STATE, OR PRESENCE	Y AXIS		RELAY, COMPUTE, CONVERT	
Z	POSITION, DIMENSION	Z AXIS		DRIVE, ACTUATE, OR UNCLASSIFIED CONTROL ELEMENT	

NETWORK DIAGRAM LEGEND	
FIBER OPTIC CABLE	-----
ETHERNET CABLE	-----
MODBUS CABLE (RS-232)	-----
COAXIAL CABLE	-----

CARASTRO & ASSOCIATES, INC.

CONSULTING ENGINEERS EB-0001160

2609 W. DE LEON STREET TAMPA, FLORIDA 33609

TELEPHONE: (813) 874-9494 WWW.CARASTRO.COM

JonesEdmunds

CERTIFICATE OF AUTHORIZATION #1841

730 NE WALDO ROAD, GAINESVILLE, FLORIDA 32641 / (352) 377-5821

324 S HYDE PARK AVE, SUITE 250, TAMPA, FLORIDA 33606 / (813) 258-0703



AQUIFER RECHARGE AT FLATFORD SWAMP
SOUTHWEST FLORIDA WATER MANAGEMENT DISTRICT

SYMBOLS & ABBREVIATIONS

					DESIGNED	RFB
					DRAWN	AN
LTR.	DATE	REVISIONS	BY	APPRD.	CHECKED	PSC

APPROVED BY	PROJECT NO:	DATE:
PAUL S. CARASTRO	19850-041-01	SEPT 2019
P.E. # 45830	INDEX NO:	DWG NO:
		11




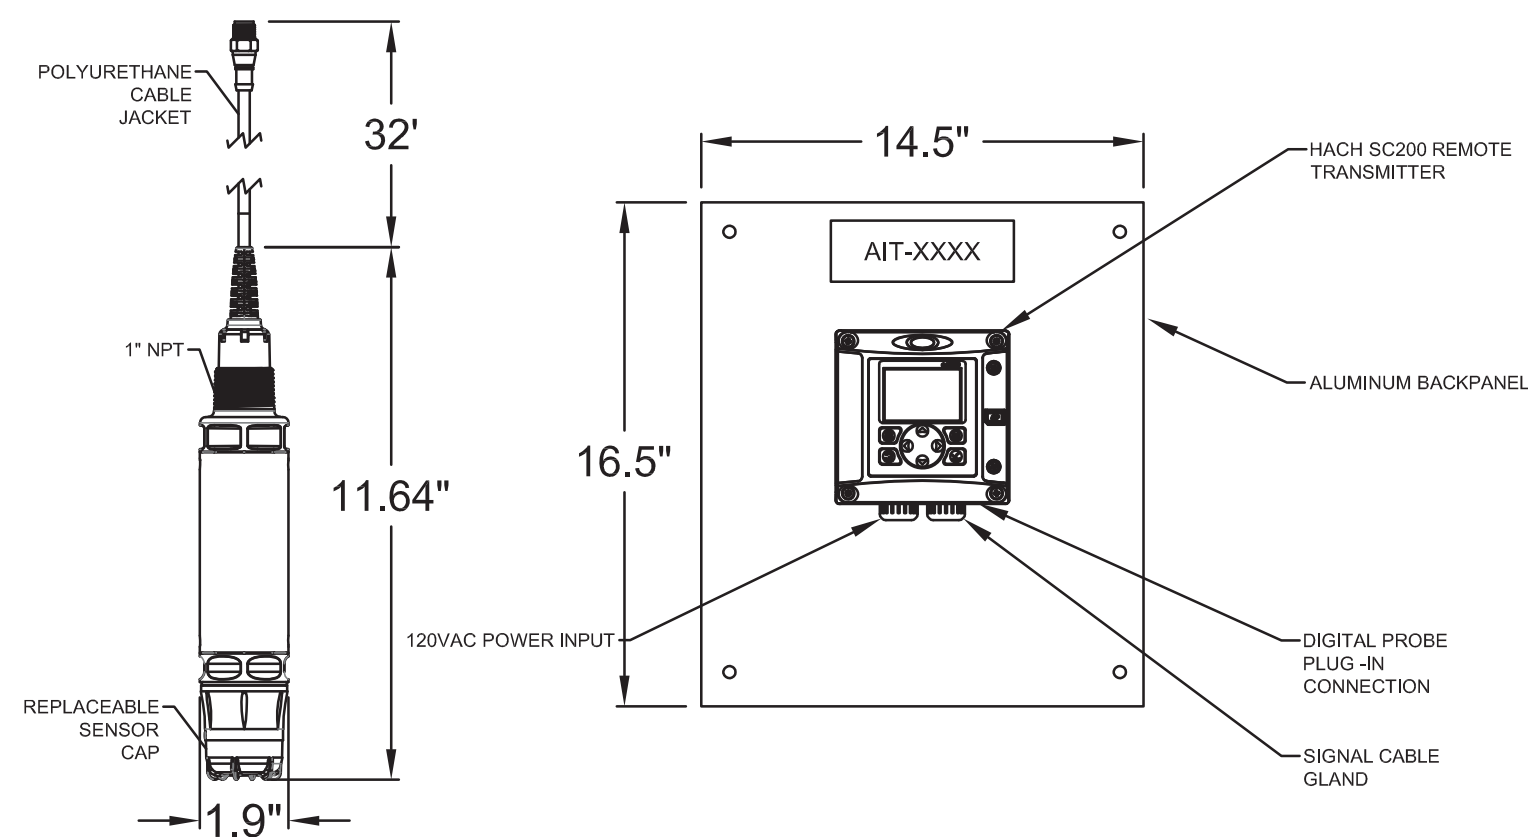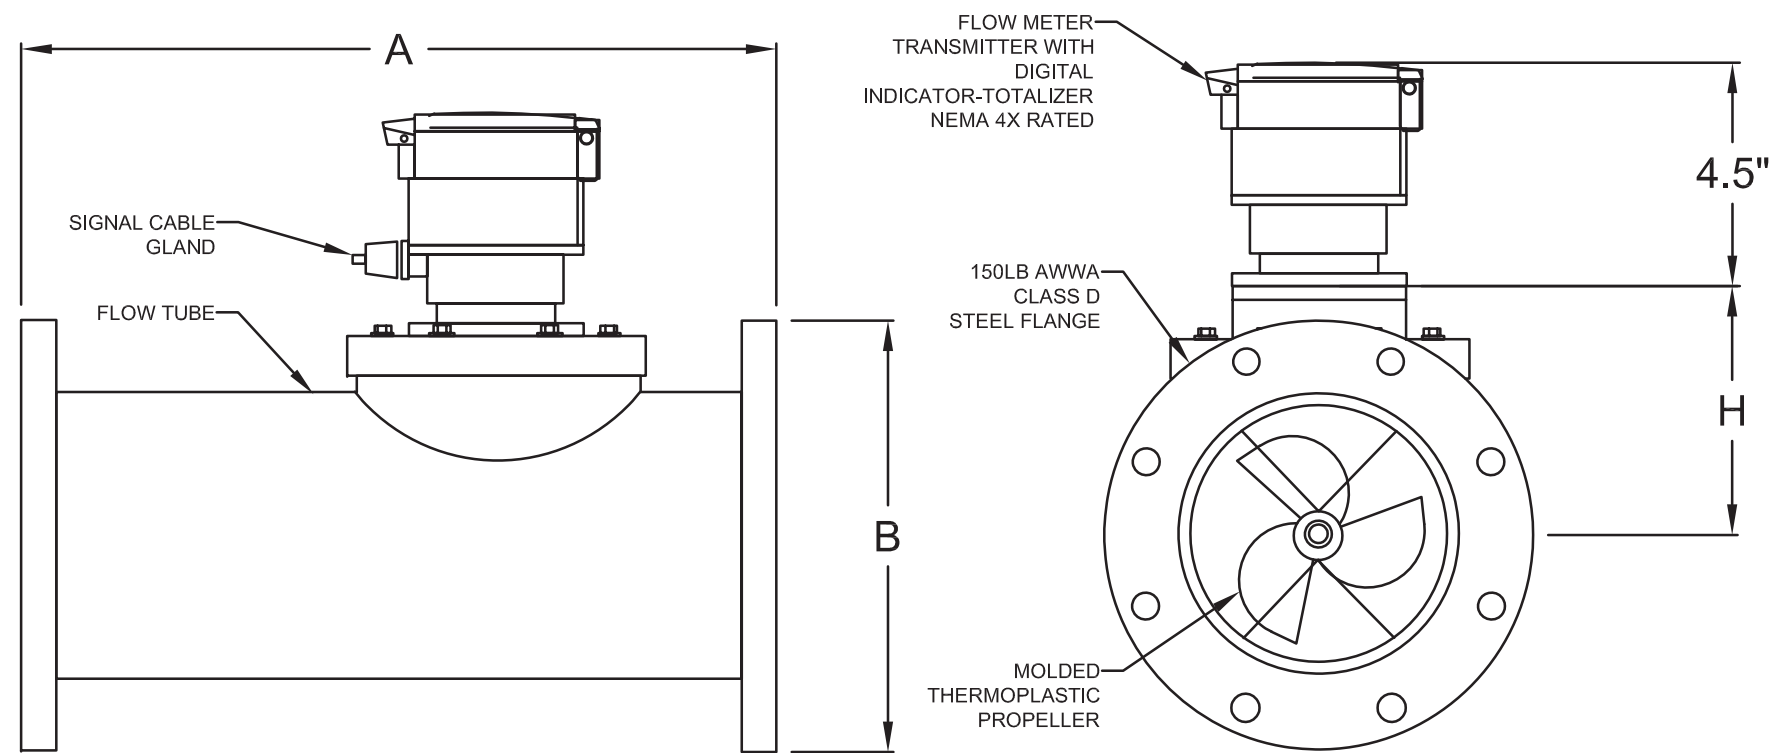


DISSOLVED OXYGEN ANALYZER DETAIL

- NOTES:**
1. REFER TO MECHANICAL DRAWING M7 FOR PROBE MOUNTING DETAILS
 2. 120VAC POWER FOR TRANSMITTER SHALL BE PROVIDED RIO-RW
 3. PROBE COMES EQUIPPED WITH 32' CABLE. PROVIDE EACH DIGITAL EXTENSION CABLE IF REQUIRED
 4. TRANSMITTER SHALL BE A HAT SC2000 CONTROLLER WITH LDO2 PROBE (9020000) AND UNION MOUNT KIT (9253000)

DO ANALYZER SCHEDULE		
TAG	LOCATION	RANGE
AE/AIT-01	RECHARGE WELL PIPING	0-40 PPM

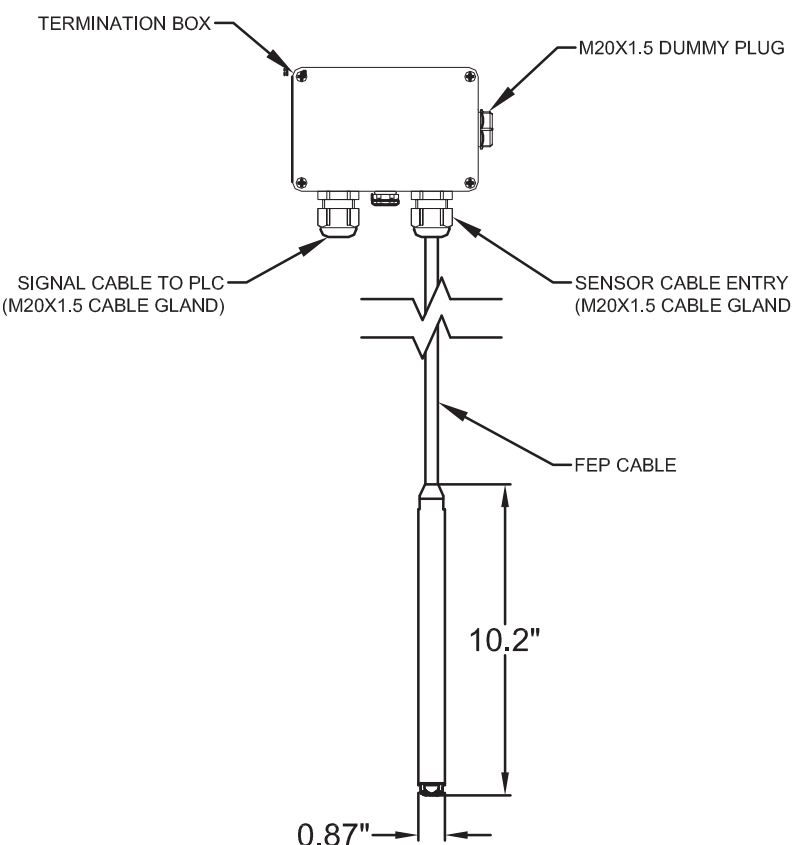


FLOW TUBE

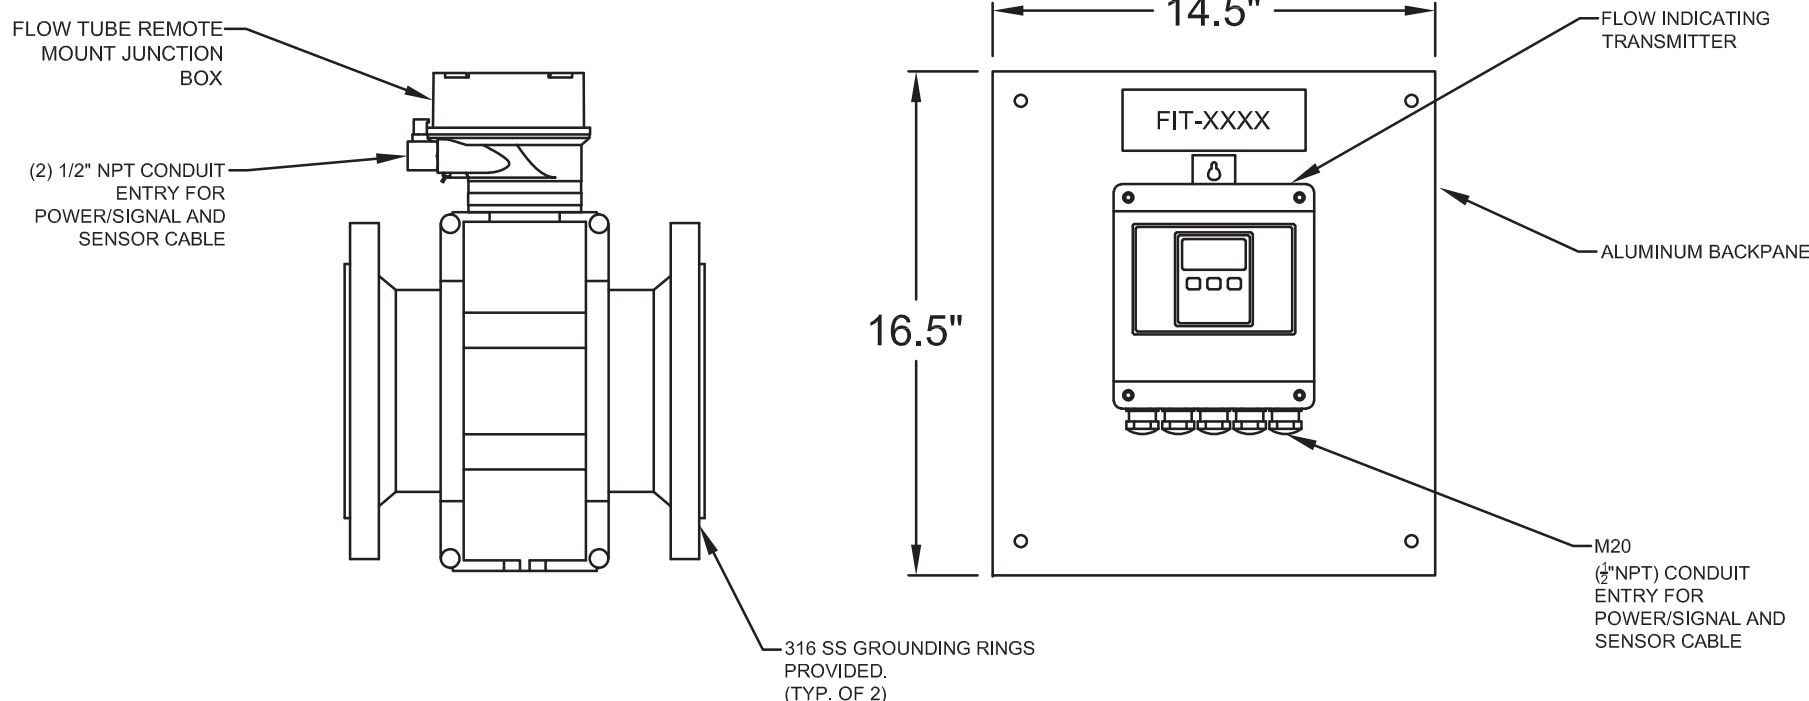

TURBIDITY ANALYZER CARRIER PROBE DETAIL
N.T.S

- NOTES:**
1. PROBE SHALL COME EQUIPPED WITH FEP CABLE. SHORTCABLE. COORDINATE WITH CONTRACTOR ON PROPER CABLE LENGTH AND RANGE
 2. SUSPENSION CLAMP AND TERMINAL BOX SHALL BE PROVIDED.
 3. SEE DRAWING M6 FOR INFORMATION REGARDING CONCRETE PENETRATIONS/SEALS
 4. SUBMERSIBLE LEVEL TRANSDUCER SHALL BE AN ENDRESS & HAUSER FMX21 WATERPILOT

NOTES:
 REFER TO CONTRACT DRAWINGS FOR PROCESS PIPING SIZE AND MATERIAL
 MAGNETIC FLOW METER COMES EQUIPPED WITH TWO 3/16 SDR GROUND RINGS
 AND GROUNDING RINGS REQUIRED FOR METALLIC AND NON-METALLIC PIPE
 INSTALLATIONS
 CONNECT GROUND GRID CONDUCTOR TO TRANSMITTER GROUND SCREW
 COORDINATE WITH MANUFACTURER TO ENSURE PROPER UPSTREAM AND
 DOWNSTREAM REQUIREMENTS FOR THE FLOW TUBE ARE MET
 MAGNETIC FLOW METER SHALL BE A 6" DENDRESS & HAUSER PROMAG W 400
 WITH REMOTE TRANSMITTER
 120V POWER SHALL BE SUPPLIED BY RIO-RW
 REFER TO MANUFACTURER LITERATURE FOR PROPER GROUNDING AND FLOW
 TUBE LAY LENGTHS.

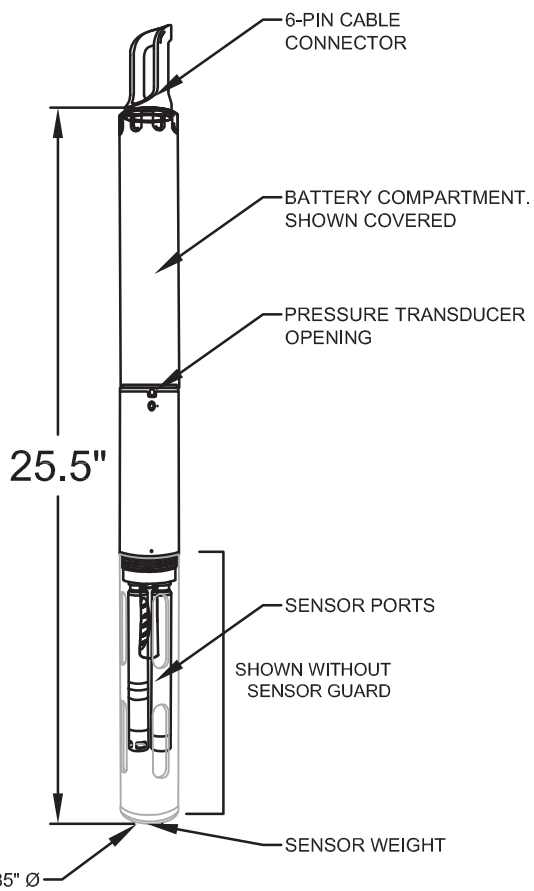

TURBIDITY ANALYZER CARRIER PROBE DETAIL
N.T.S

- NOTES:
1. CARRIER PROBE HAS THE ABILITY TO HOUSE UP TO 4 SENSORS
2. ANALYZER PROBE REQUIRES (2) D-CELL BATTERIES
3. SIGNAL OUTPUT ADAPTER REQUIRED TO CONVERT SIGNAL TO SIGNAL 2 (59907)
4. COORDINATE WITH CONTRACTOR TO SELECT APPROPRIATE LENGTH OF 6-PIN SENSOR CABLE WITH FLYING LEAD
5. PROVIDE MANUFACTURER'S STRAIN RELIEF AND MOUNT PER DRAWING M1
6. TURBIDITY ANALYZER SHALL BE YSI EX601 SONDE (599501-00) WITH EXO TURBIDITY SENSOR (599101-01) AND CONDUCTIVITY/TEMPERATURE SENSOR (599670). TEMPERATURE COMPENSATION REQUIRED FOR ACCURATE TURBIDITY READINGS

MAGNETIC FLOW METER SCHEDULE		
TAG	LOCATION	RANGE
FE/FIT-01	RECHARGE WELL	0-1500 GPM

**CARASTRO &
ASSOCIATES, INC.**

CONSULTING ENGINEERS EB-0001160
2609 W. DE LEON STREET TAMPA, FLORIDA 33609
TELEPHONE: (813) 874-9494 WWW.CARASTRO.COM



AQUIFER RECHARGE AT FLATFORD SWAMP
SOUTHWEST FLORIDA WATER MANAGEMENT DISTRICT

INSTRUMENT DETAILS

APPROVED BY _____

PAUL S. CARASTRO
P.E. # 45830

PROJECT NO:

19850-041-01

DATE: _____

SEPT 2019

DWG NO:

DWG NO:

10/1/2019 5:10 PM KRIS P:\-6299\6231\Flatford-BIDSET 10-1-19\4-Flatford P&ID.DWG

